

ABERNATHY and ASSOCIATES

Kenneth B. Abernathy Jr.


Wisconsin Registered Land Surveyor S-1594

Rt. 3, Box 273
Elkhorn, Wisconsin 53121
Phone: (414) 723-4260 (office)
(414) 723-7209 (FAX)

PLAT OF SURVEY


LOT 177 OF THE SECOND ADDITION TO CEDAR
POINT PARK ON LAKE GENEVA SUBDIVISION,
LOCATED IN PART OF SECTION 6, TOWN 1
NORTH, RANGE 17 EAST, VILLAGE OF WILLIAMS
BAY, WALWORTH COUNTY, WISCONSIN.

ORDERED BY: ATTORNEY DALE THORPE
512 E. WALWORTH AVE.
DELAVER, WI. 53115

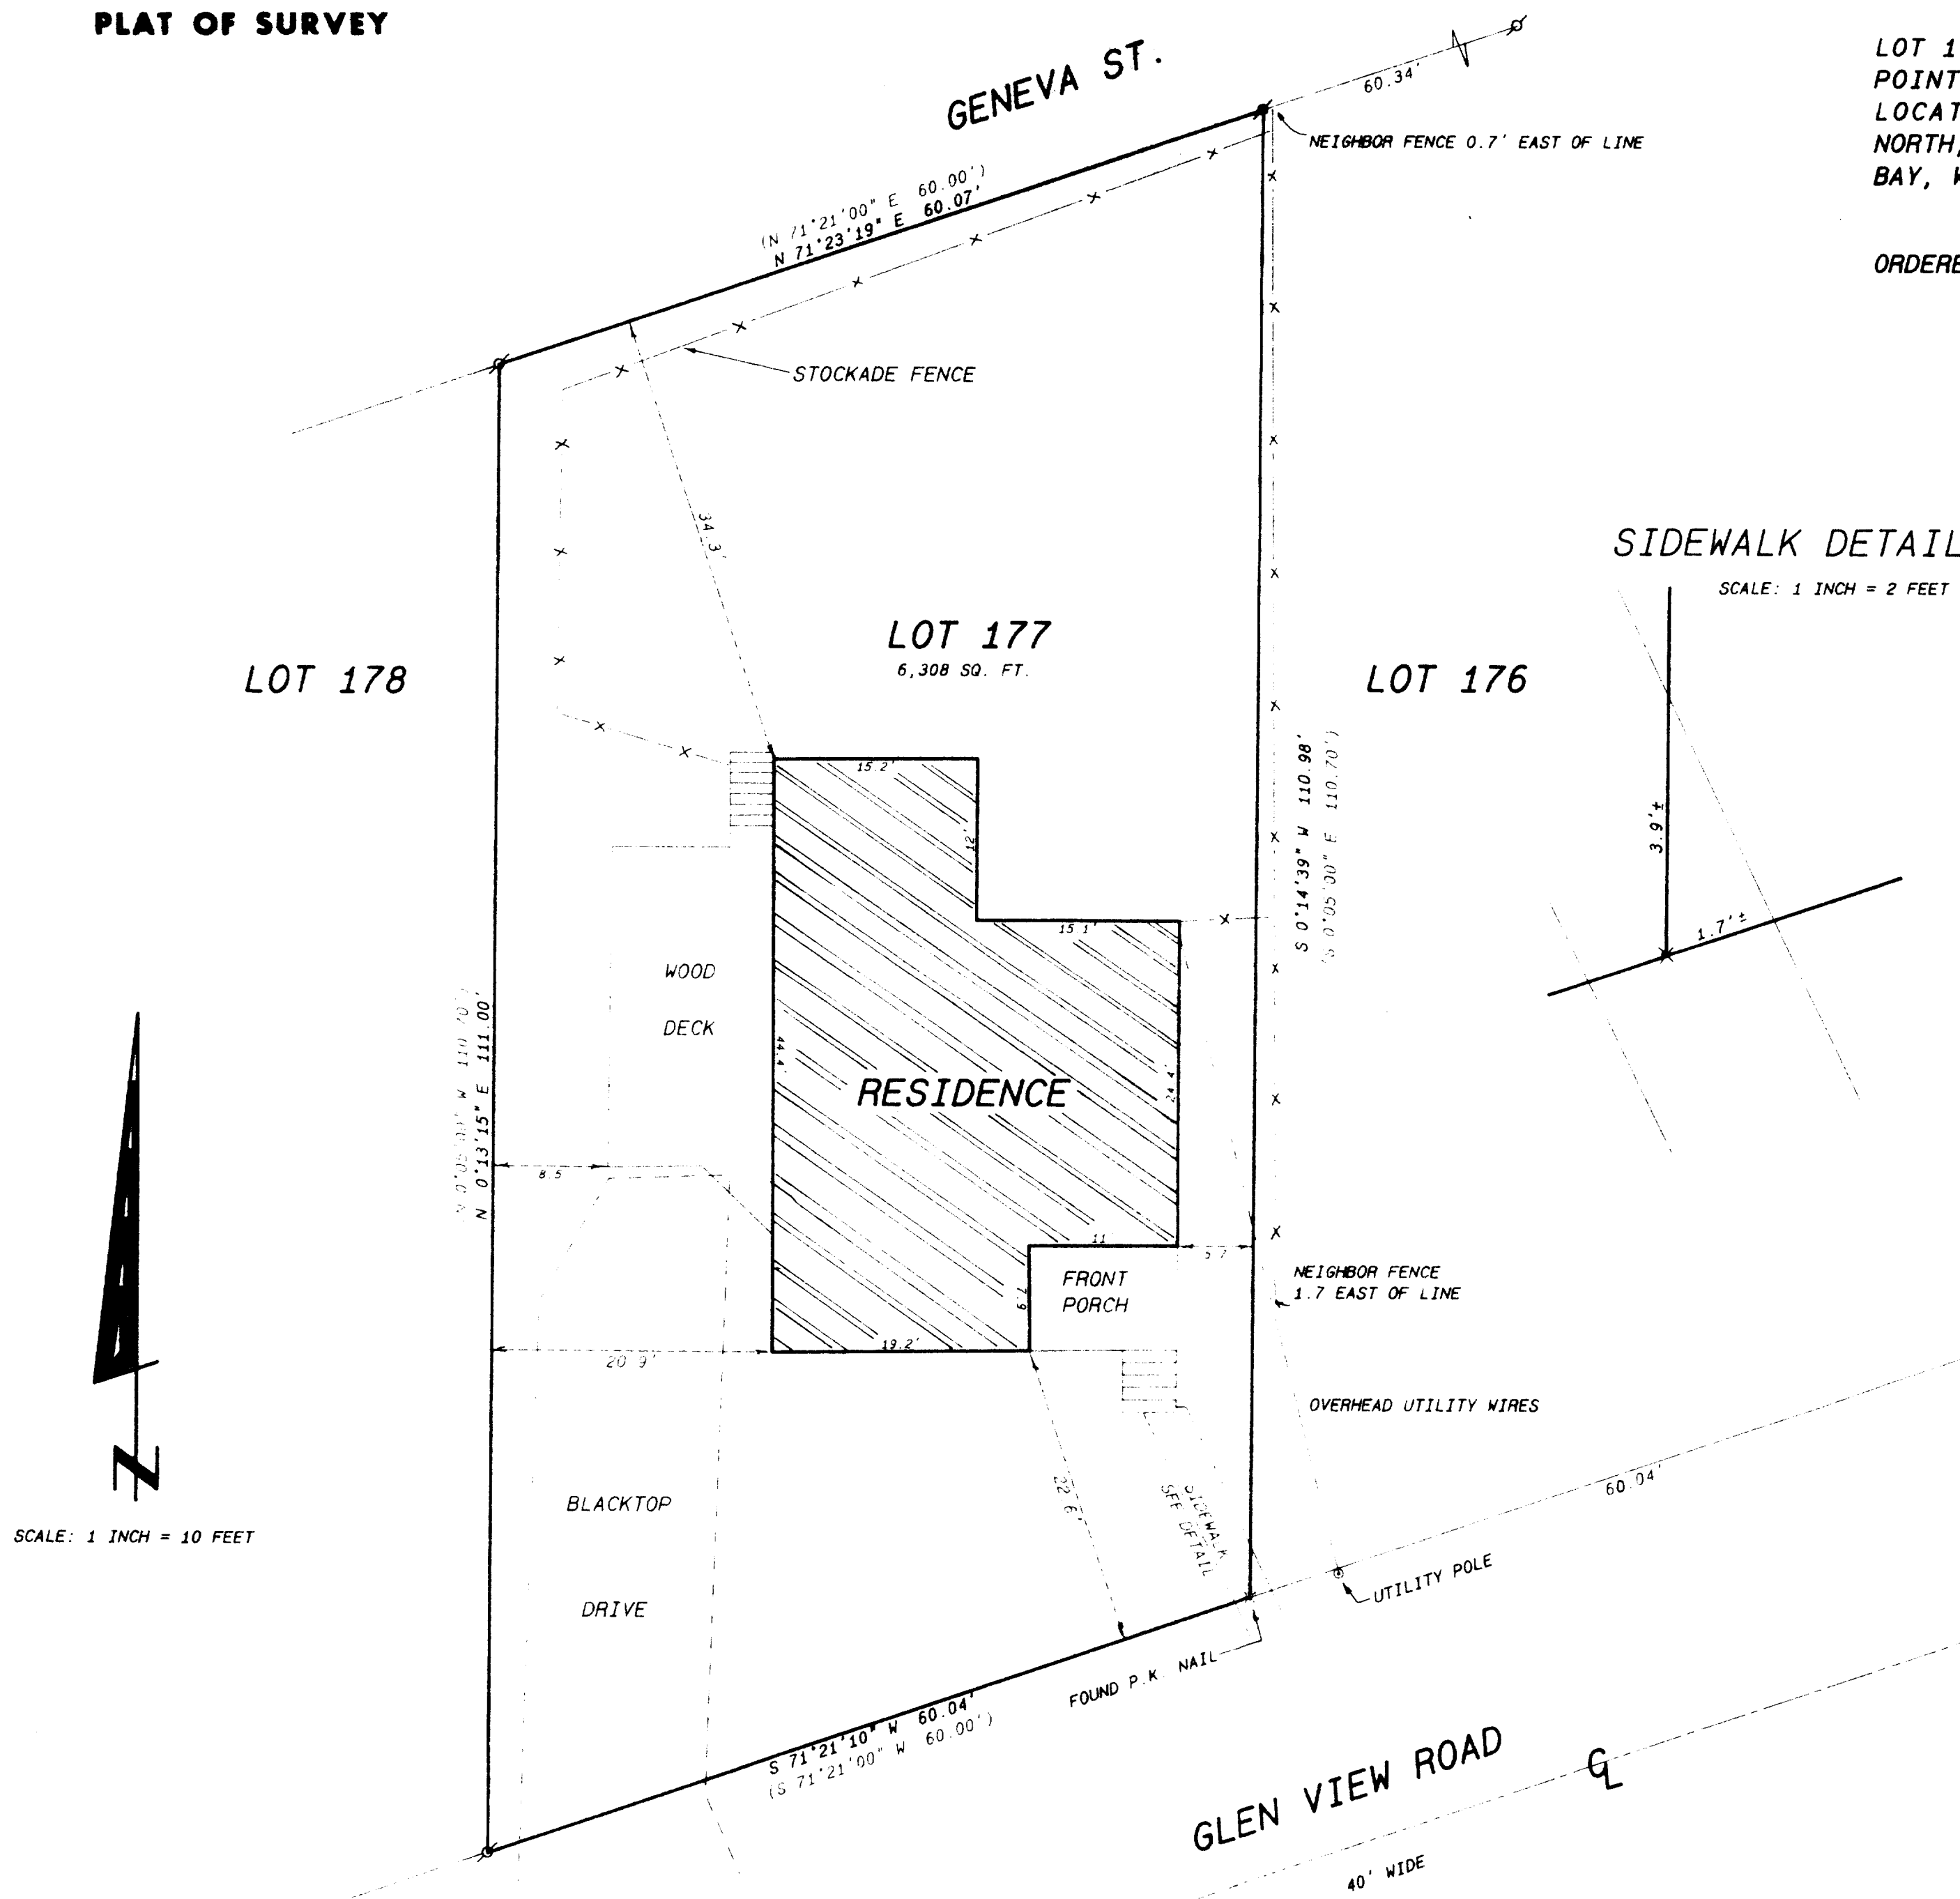

Legend

- FOUND IRON PIPE
- FOUND IRON ROD
- FOUND BRASS CAPPED MONUMENT
- FOUND CONCRETE MONUMENT
- CHISEL CUT IN CONCRETE
- SET IRON ROD, 24" LONG, WEIGHING 1.5 LBS. LINEAL FT. 3/4" DIA.
- SET IRON ROD, 10" LONG, WEIGHING 4.5 LBS. LINEAL FT. 1 1/16" DIA.
- RECORDED AS DIMENSION
- EXISTING FENCE

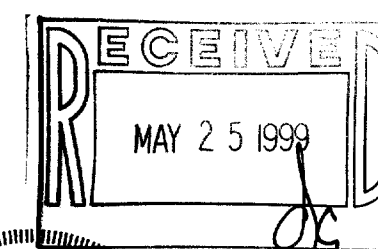

SCALE: 1" = 10 FEET

REVISED MAY 7, 1999

I hereby certify that the above described property has been surveyed
in accordance with my direction and that the above map is a true
representation thereof and shows the size and location of the property, its
external boundaries, the location of all visible structures and dimensions of
all buildings, buildings, thereon, boundaries, fences, apparent easements,
highways and visible encroachments, if any.

This survey is made for the use of the present owners of the property
and those who purchase, mortgage or otherwise acquire the title thereto within
one year from date hereof.

Kenneth B. Abernathy, Jr.
WISCONSIN REGISTERED LAND SURVEYOR,
S-1594

Date: APRIL 15, 1999 Job No. 99.412

011-1351
WCP2-69