



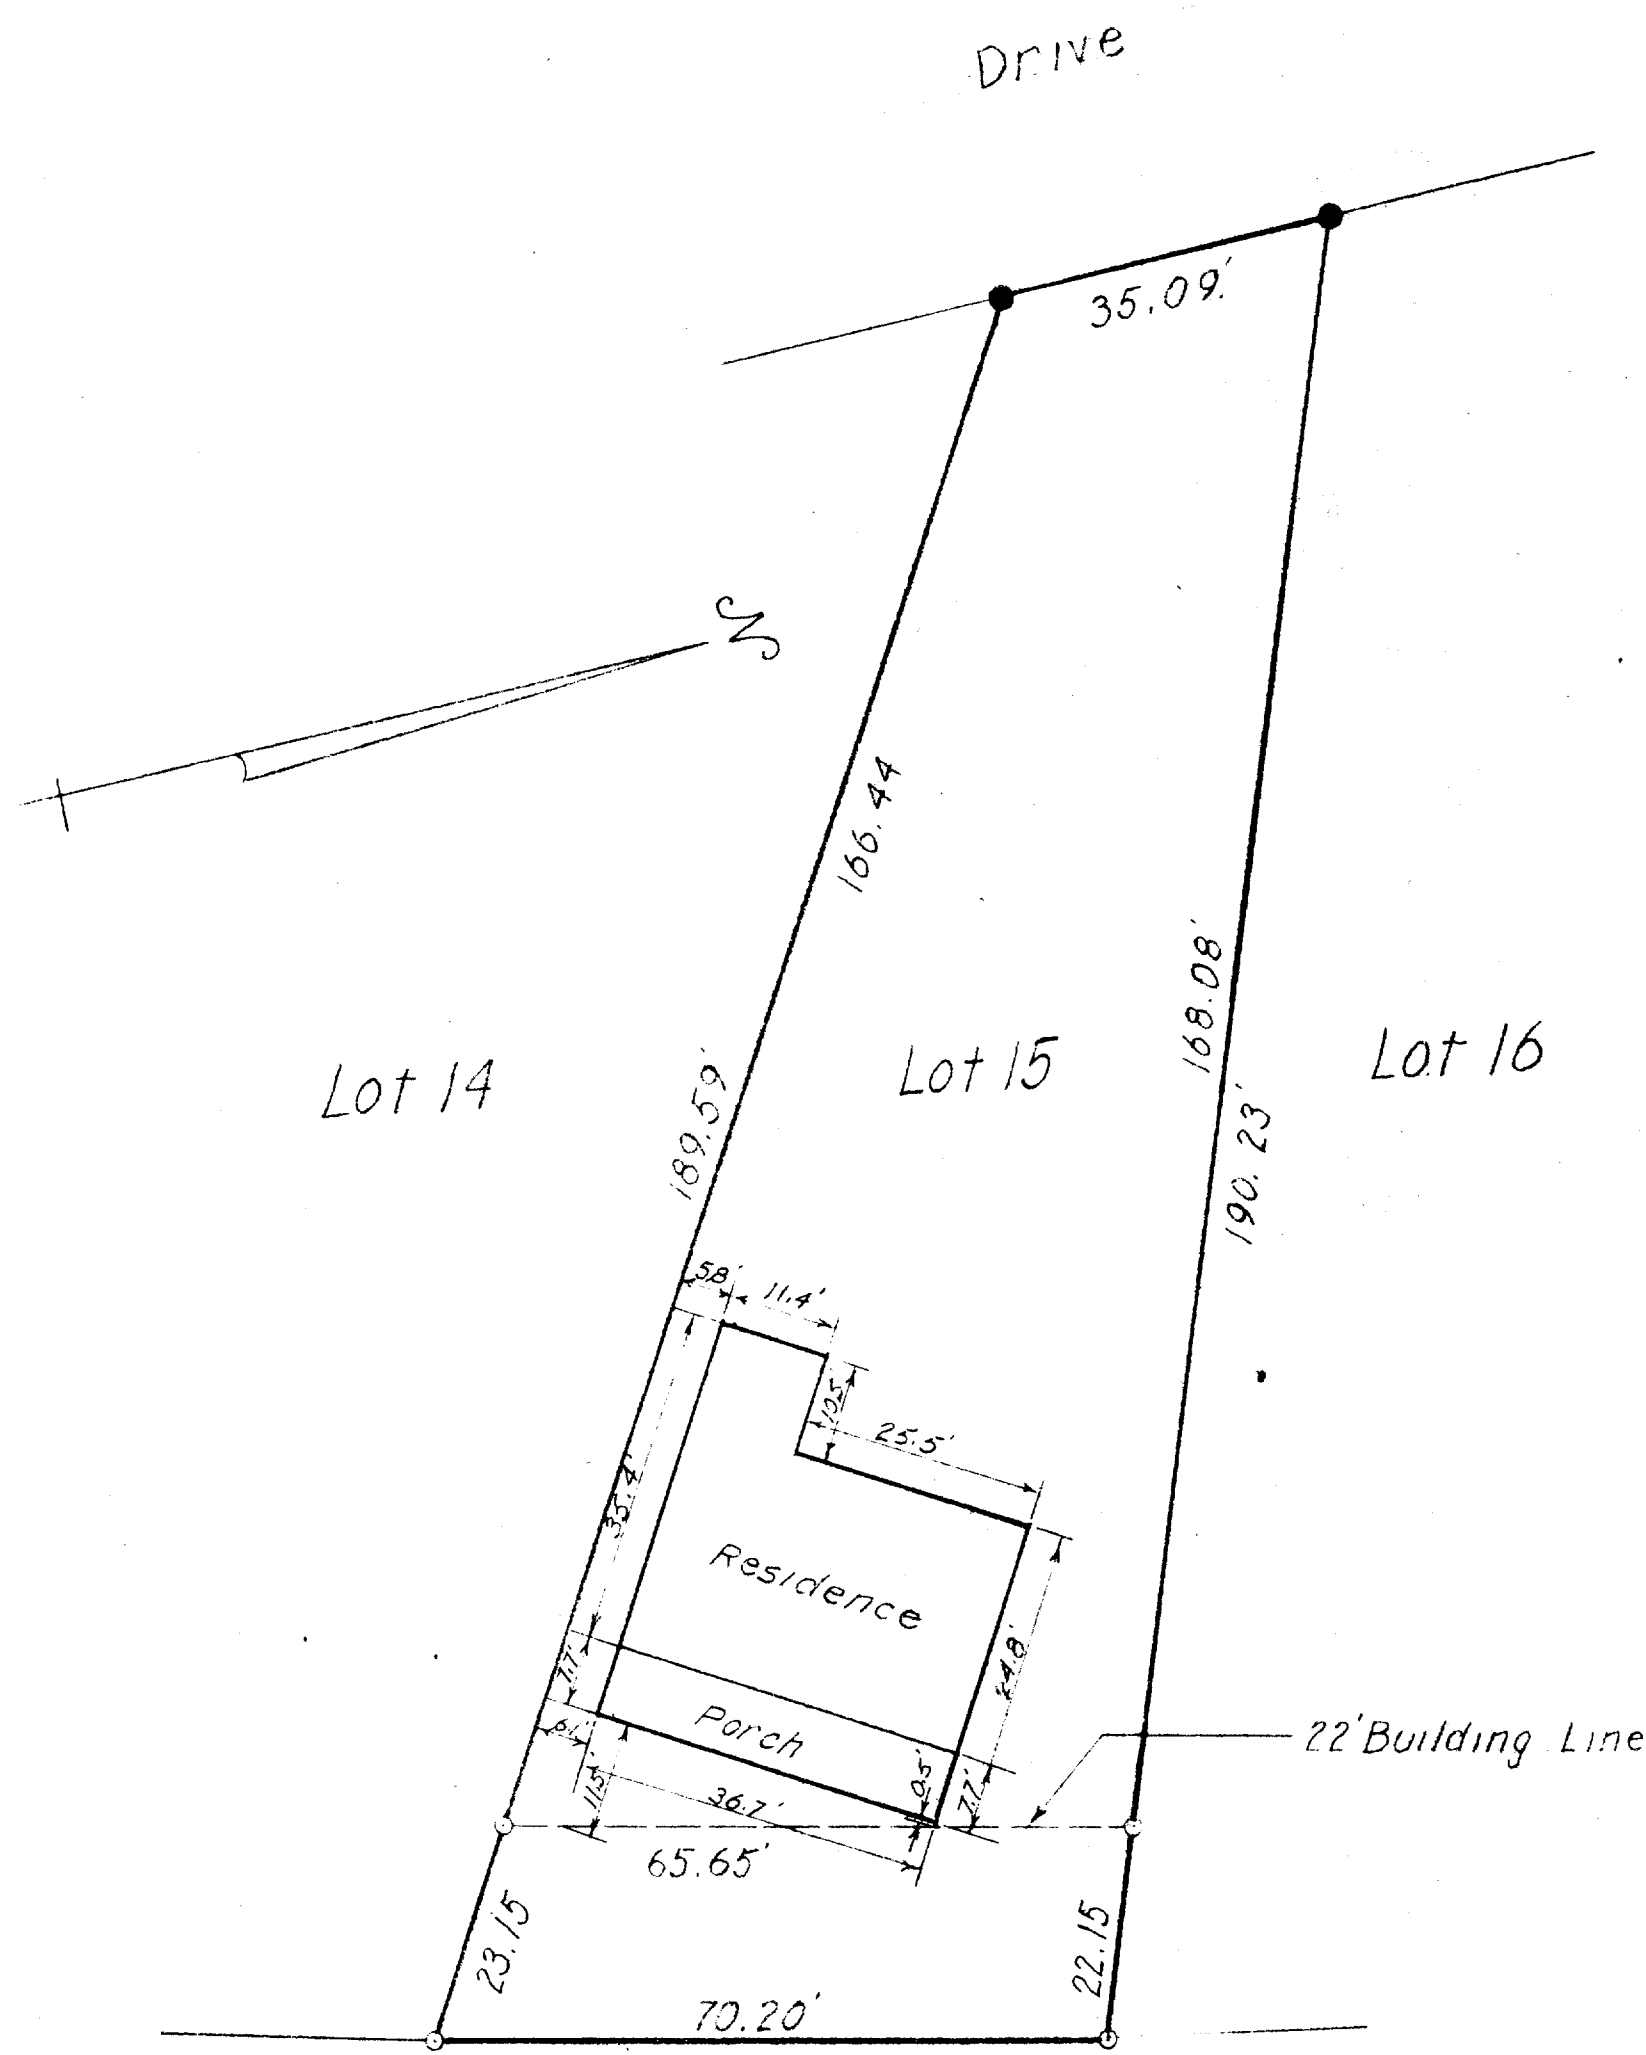

○ - Iron Pipe
 ● - Concrete Monument

Birch Grove Park

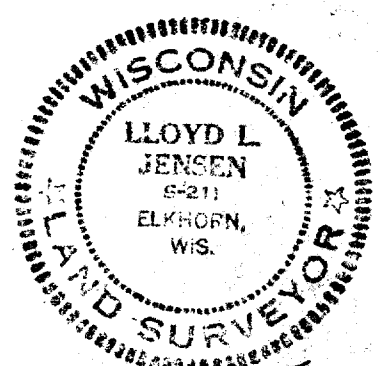

PLAT OF SURVEY
 OF
 Lot 15 of the 1st Addition to Cedar Point Park, Village of Williams Bay, Section 6, T1N, R17E, Walworth County, Wisconsin

Lloyd L. Jensen
 SURVEYOR

SCALE 1" = 20' DATE Dec. 1956