


HAROLD H. KOLB
REGISTERED PROFESSIONAL LAND SURVEYOR
LAKE GENEVA, WISCONSIN

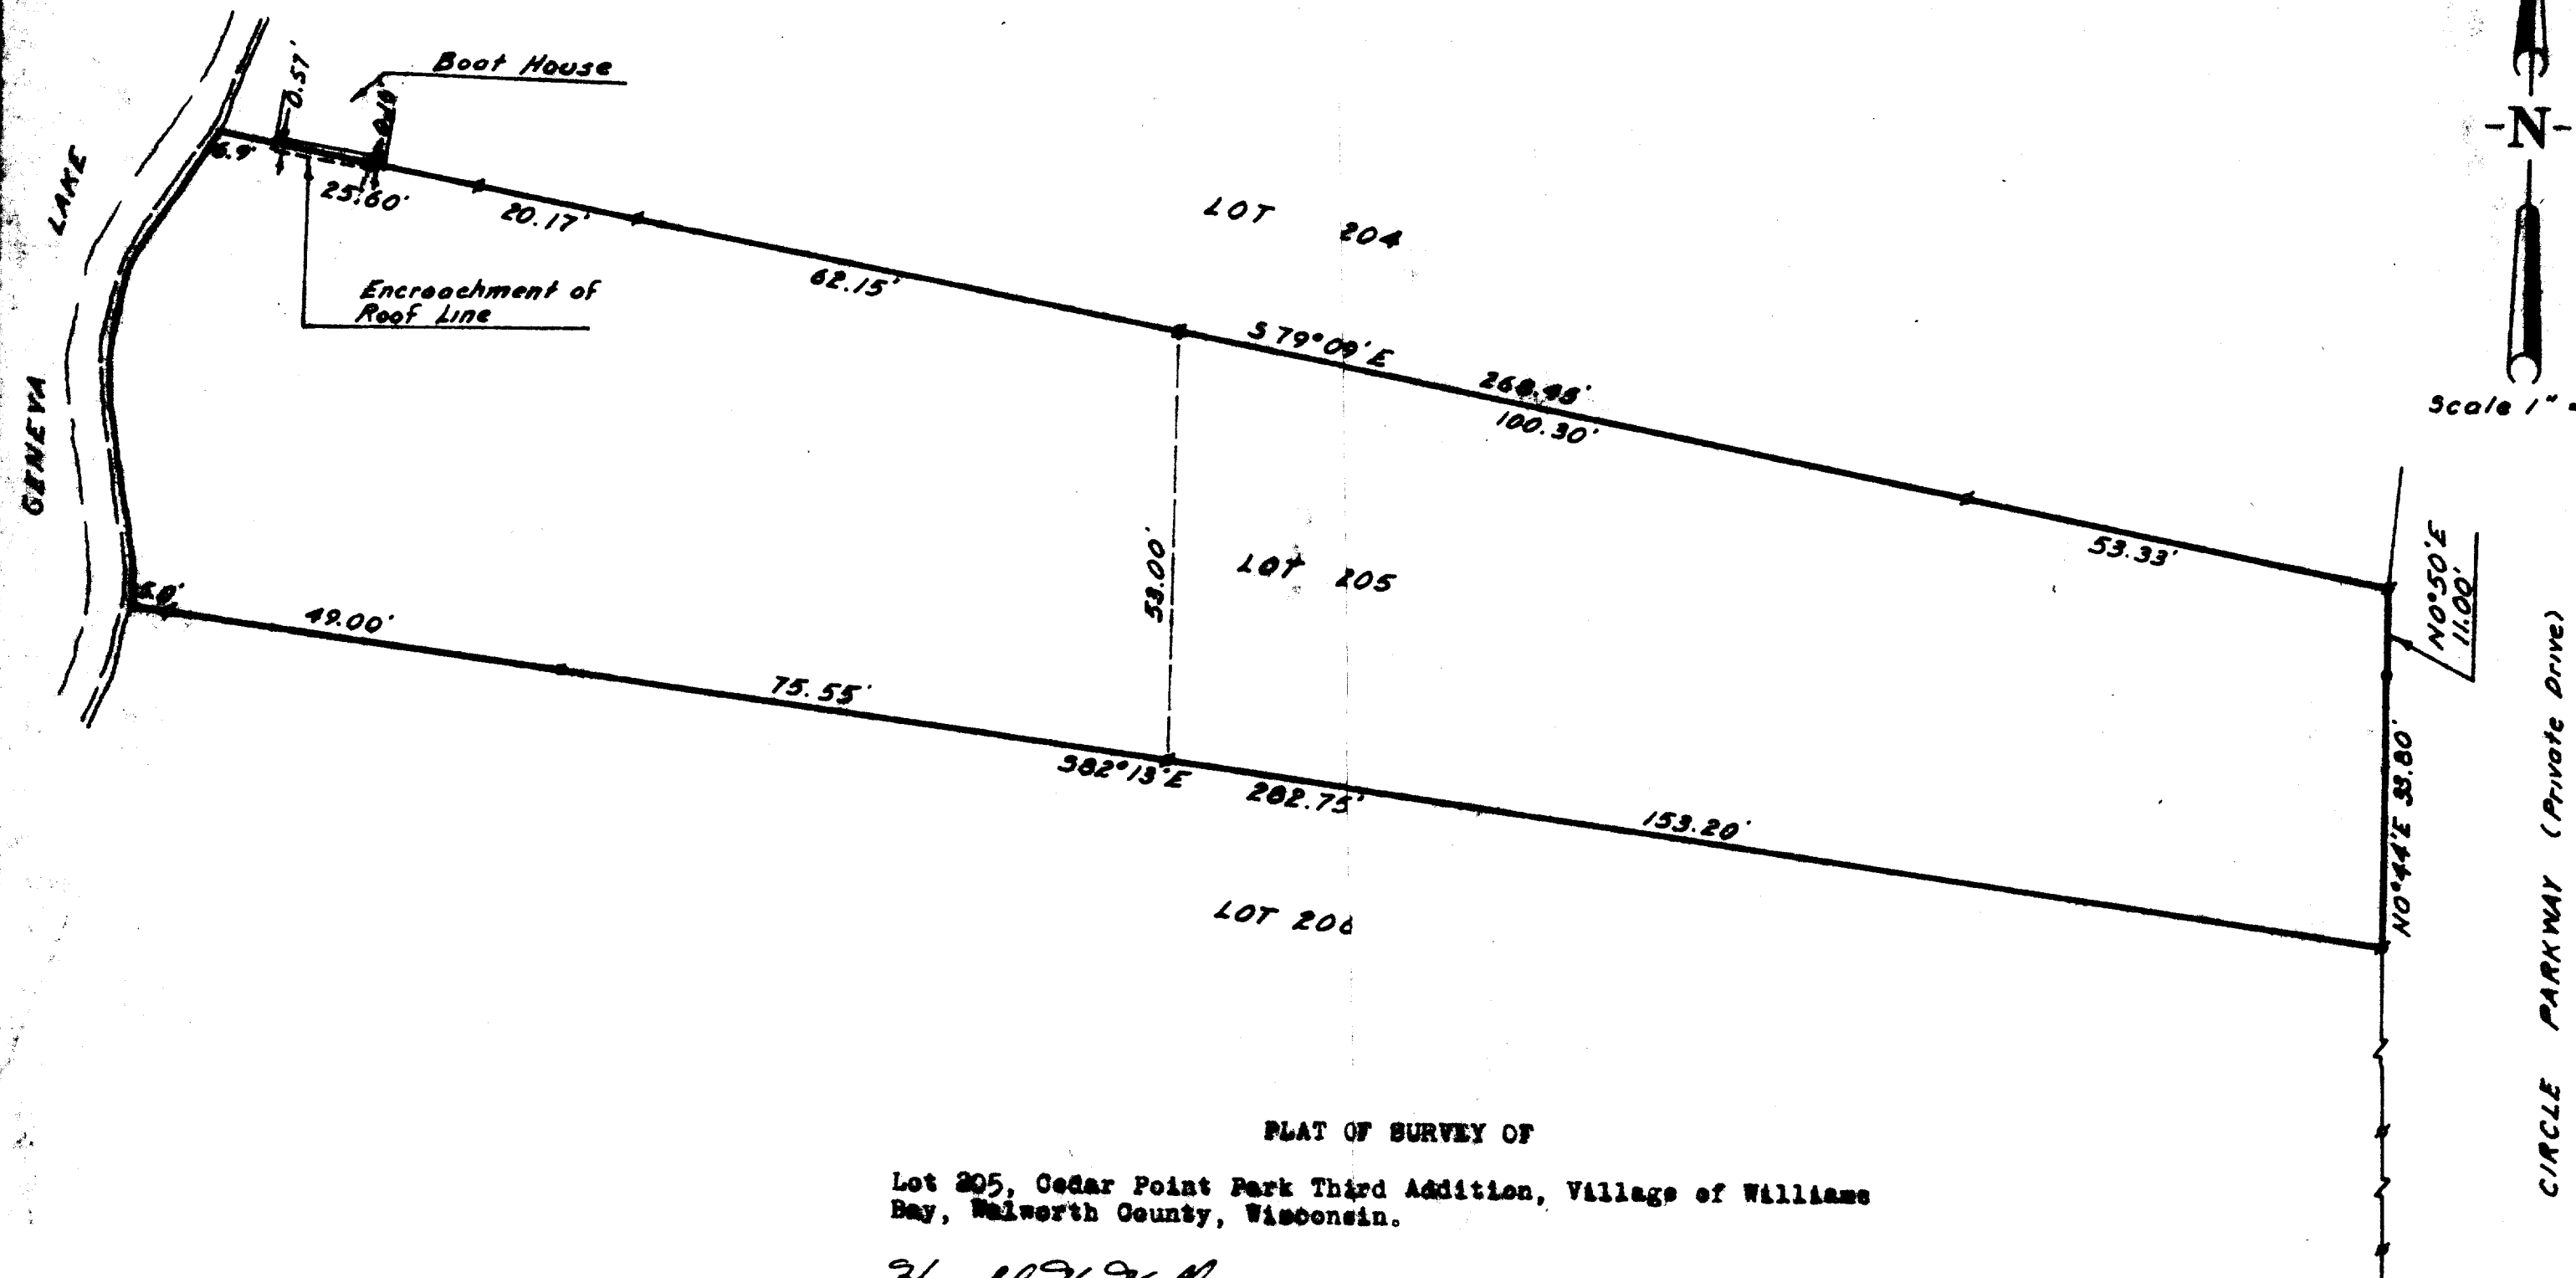

PLAT OF SURVEY OF
Lot 205, Cedar Point Park Third Addition, Village of Williams
Bay, Walworth County, Wisconsin.

Harold H. Kolb
Harold H. Kolb, Wisconsin Surveyor, S-157

- - Iron Rod in Concrete Found
- - Iron Pipe Found
- - Iron Pipe Placed