

PLAT OF SURVEY


PATHFINDER SURVEYING
 FORMERLY KOLB LAND CONSULTING
 929 WILLIAMS STREET LAKE GENEVA, WI. 53147
 (414) 248-3697

ORDERED BY: THE RAULAND AGENCY, INC.
 P.O. BOX 159
 WALWORTH, WI. 53184

DATE: 4-26-1999

DESCRIPTION: LOT 4 OF BETHEL BLOCK, A SUBDIVISION
 LOCATED IN THE VILLAGE OF WILLIAMS
 BAY, WALWORTH COUNTY, WISCONSIN.

SCALE 1"=20"
 BEARINGS REFERENCED
 TO RECORD PLAT OF
 BETHEL BLOCK SUB.

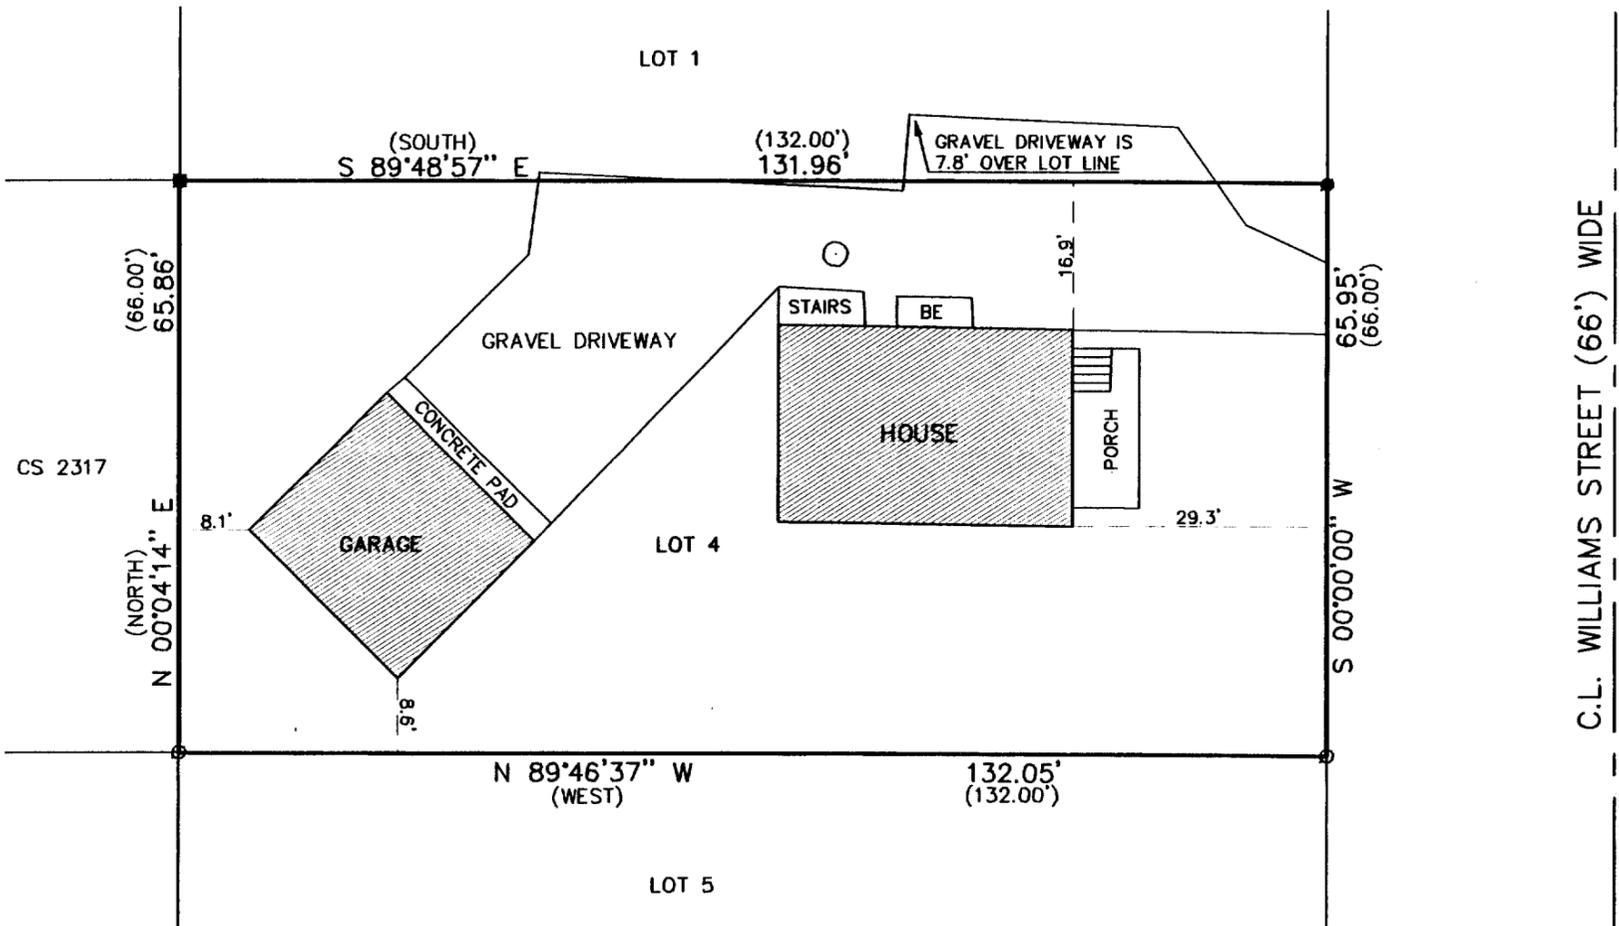

- LEGEND
- FOUND IRON PIPE
 - SET IRON PIPE
 - FOUND IRON PIN
 - BE BASEMENT ENTRANCE
 - (XXX) RECORDED AS
 - MANHOLE

THE ABOVE MAP IS A TRUE REPRESENTATION THEREOF AND
 SHOWS THE SIZE AND LOCATION OF ALL THE PROPERTY,
 EXTERIOR BOUNDARIES, THE LOCATION OF ALL VISIBLE
 BOUNDARY FENCES, APPARENT EASEMENTS, ROADWAYS
 AND VISIBLE ENCROACHMENTS, IF ANY

THIS SURVEY IS MADE FOR THE USE OF THE PRESENT
 OWNERS OF THE PROPERTY, AND ALSO THOSE WHO
 PURCHASE, MORTGAGE OR GUARANTEE TITLE THERETO
 WITHIN ONE (1) YEAR FROM DATE HERETO.



John P. Krott
 JOHN P. KROTT, R.L.S. 2258

NOTE: THIS IS NOT A CERTIFIED COPY
 UNLESS SEAL IS IN RED.
 JOB NUMBER 99086 WBX 00004

WBX-4 011-1381