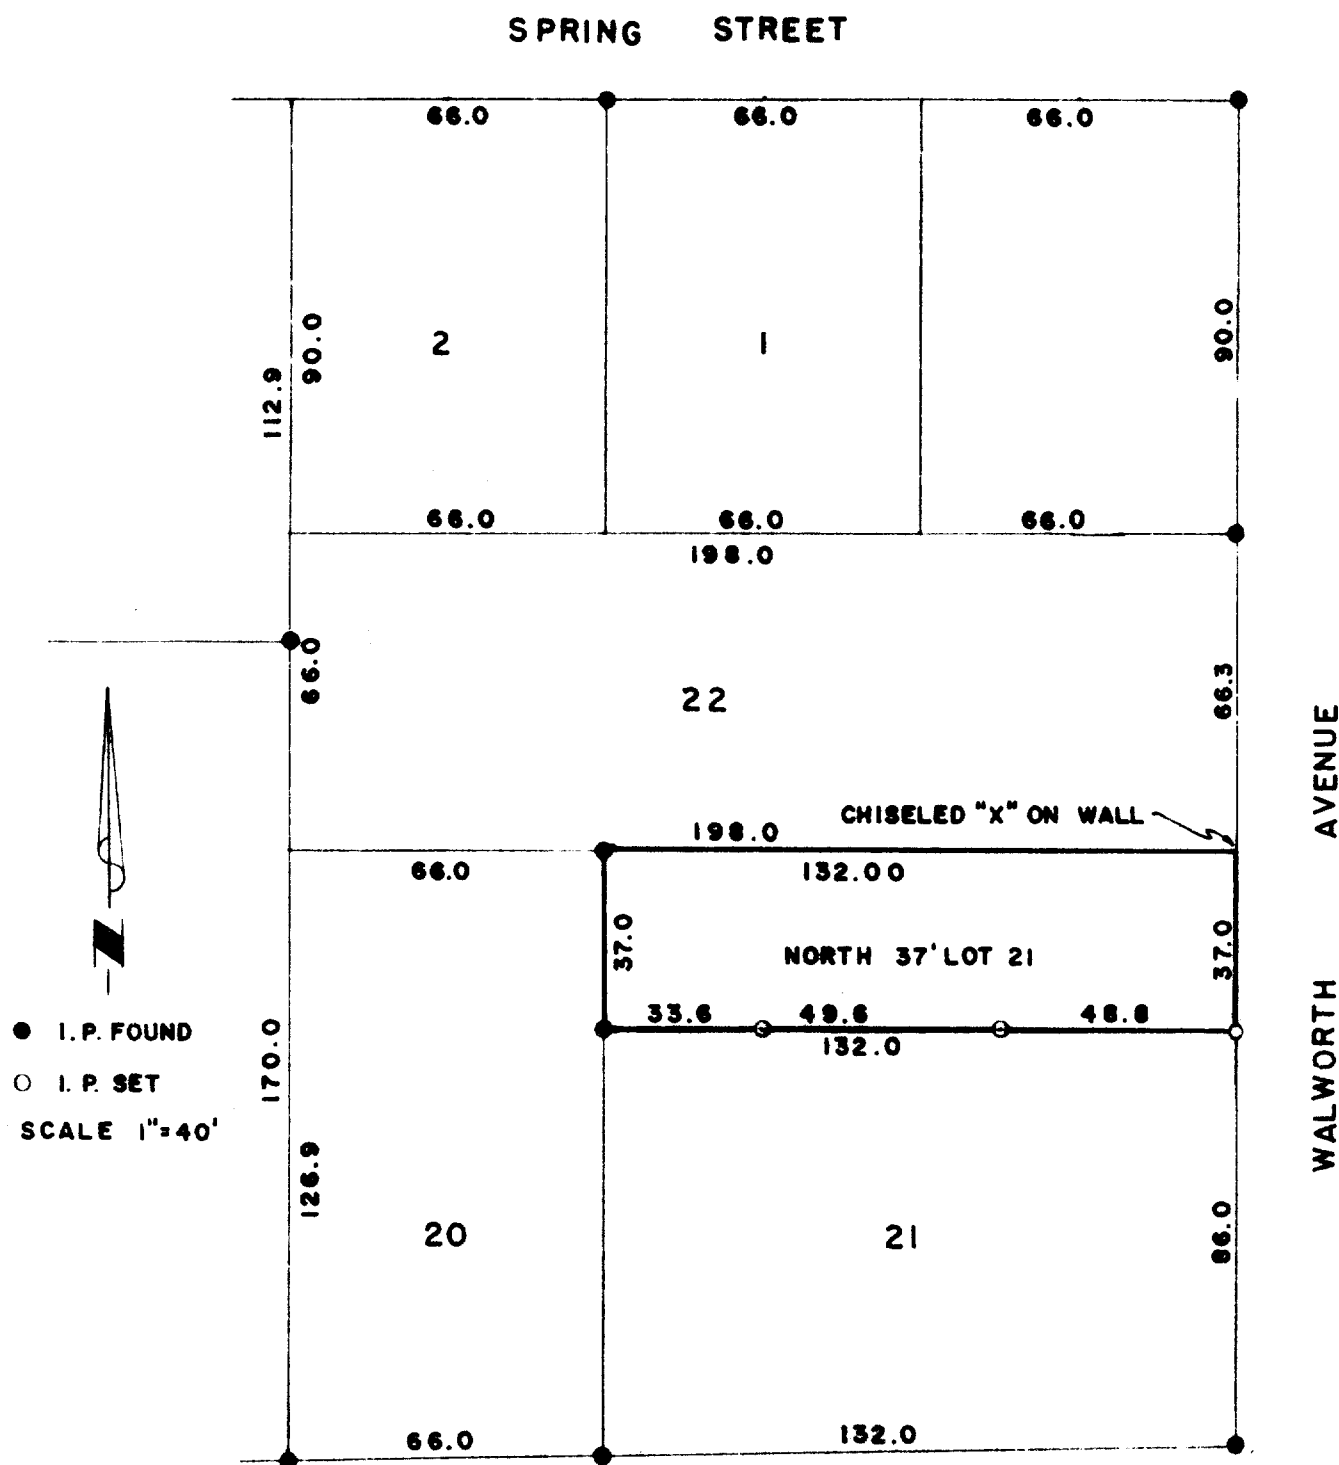


**DESCRIPTION:**

The North 37 feet of Lot 21 of Johnson's Addition to the Village of Williams Bay, Walworth County, Wisconsin.

CERTIFICATE:

I, James F. Biagi, surveyor, do hereby certify that I have surveyed the lands hereon described.

DATE:

May 31, 1971

James F. Biagi
James F. Biagi

R.L.S.272

