


PLAT OF SURVEY OF


the South 30 feet of Lot 31 of LOCKWOOD'S SUBDIVISION, in the Village of Williams Bay, Wisconsin.

Legal description as provided

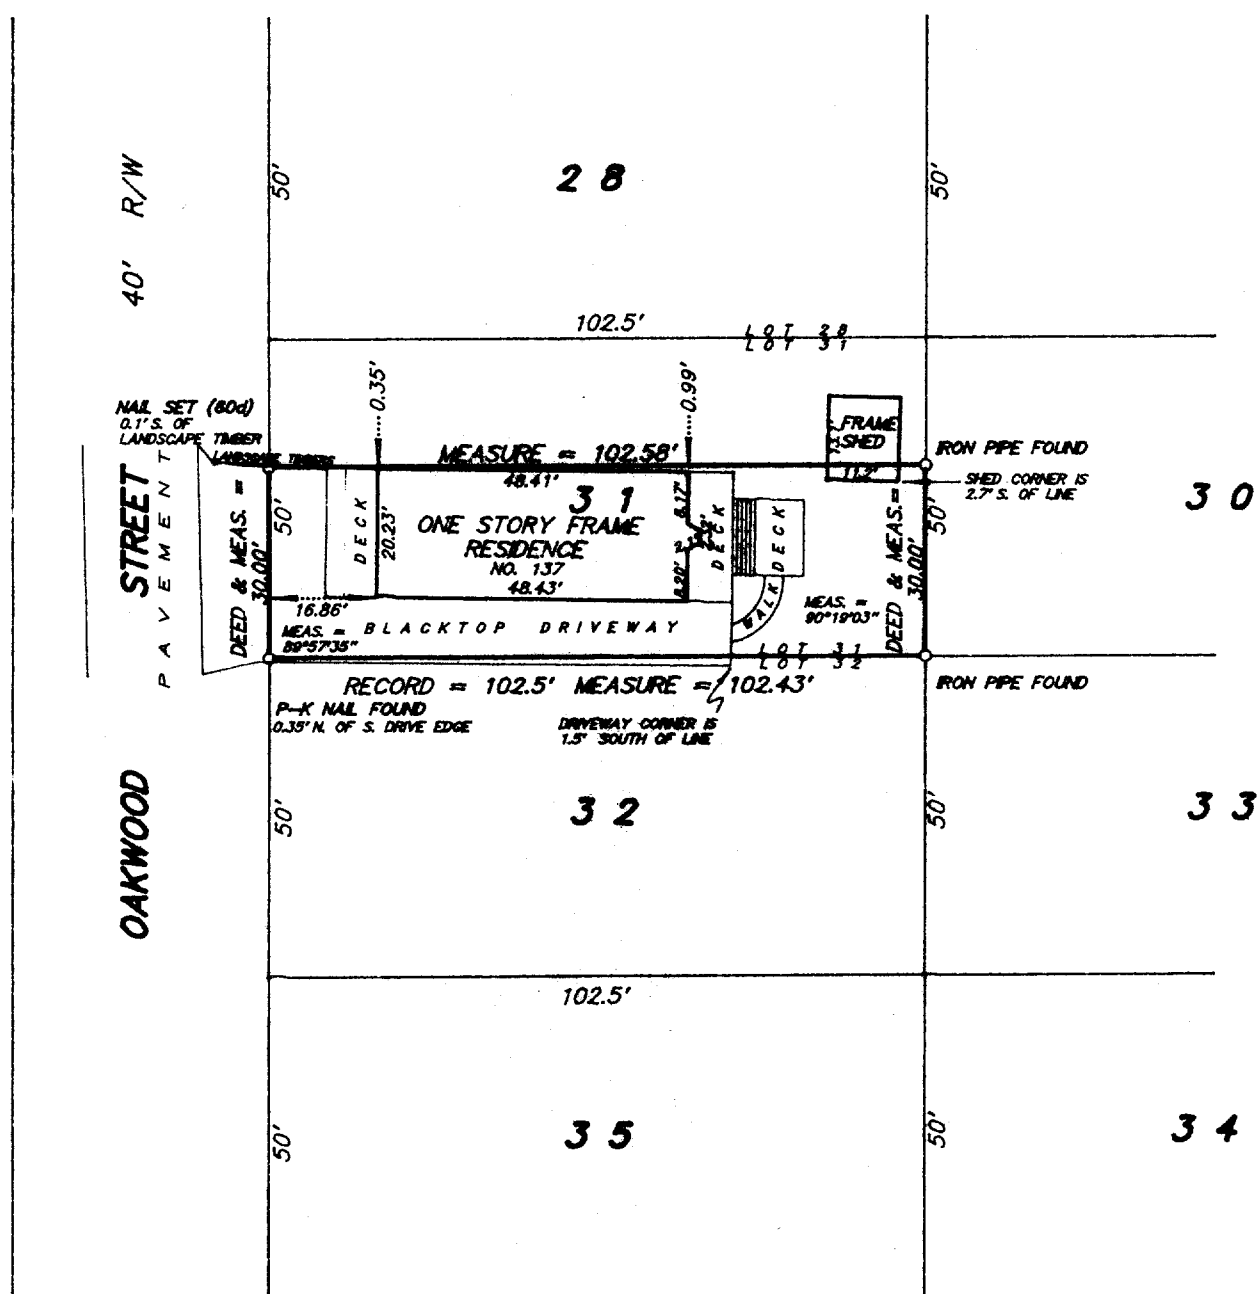

SCALE 1 inch = 30 feet

ORDERED BY B. Limosani / Homstead Lakes Realty
JOB NO. 99060

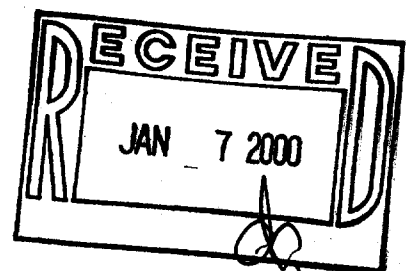

I hereby certify that I have surveyed the above described property and the above plat is a true representation thereof and shows the size and location of the property, its exterior boundaries, the location and dimensions of all visible structures thereon, boundary fences, apparent easements and roadways and visible encroachments, if any.

This survey is made for the exclusive use of the present owners of the property, and also those who purchase, mortgage, or guarantee the title thereto within one year from the date hereof.

Dated at Bassett, Wisconsin this _____ day of _____ 1999.

Mark A. Bolender
Wisconsin Registered Land Surveyor S - 1784

011-1415
W403-22