

PLAT OF SURVEY

THE WESTERLY 75 FEET OF LOT 8 OF GRAND TERRACE SUBDIVISION, LOCATED IN SECTION 1
 , TOWN 1 NORTH, RANGE 16 EAST, VILLAGE OF WILLIAMS BAY, WALWORTH COUNTY,
 WISCONSIN.


SUBJECT PROPERTY ADDRESS: 455 OUTING DRIVE
WILLIAMS BAY, WI. 53191

ORDERED BY: THOMAS NEWMAN ET. AL.
P. O. BOX 564
WHEATON, IL. 60189-0564

REFERENCE LEGAL DESCRIPTION



The West half (W 1/2) and the West half (W 1/2) of the East half (E 1/2) of Lot Eight (8) in Grand Terrace Subdivision, being a subdivision of part of Section one (1) and twelve (12) in Township One (1), North, Range sixteen (16) East, according to the plat and survey of said subdivision on record in the office of the Register of Deeds in and for said County of Walworth, together with all improvements thereon.

QUIT CLAIM DEED DATED MARCH 25, 1993 VOL. 624 P.
31 DOC. NO. 260444.

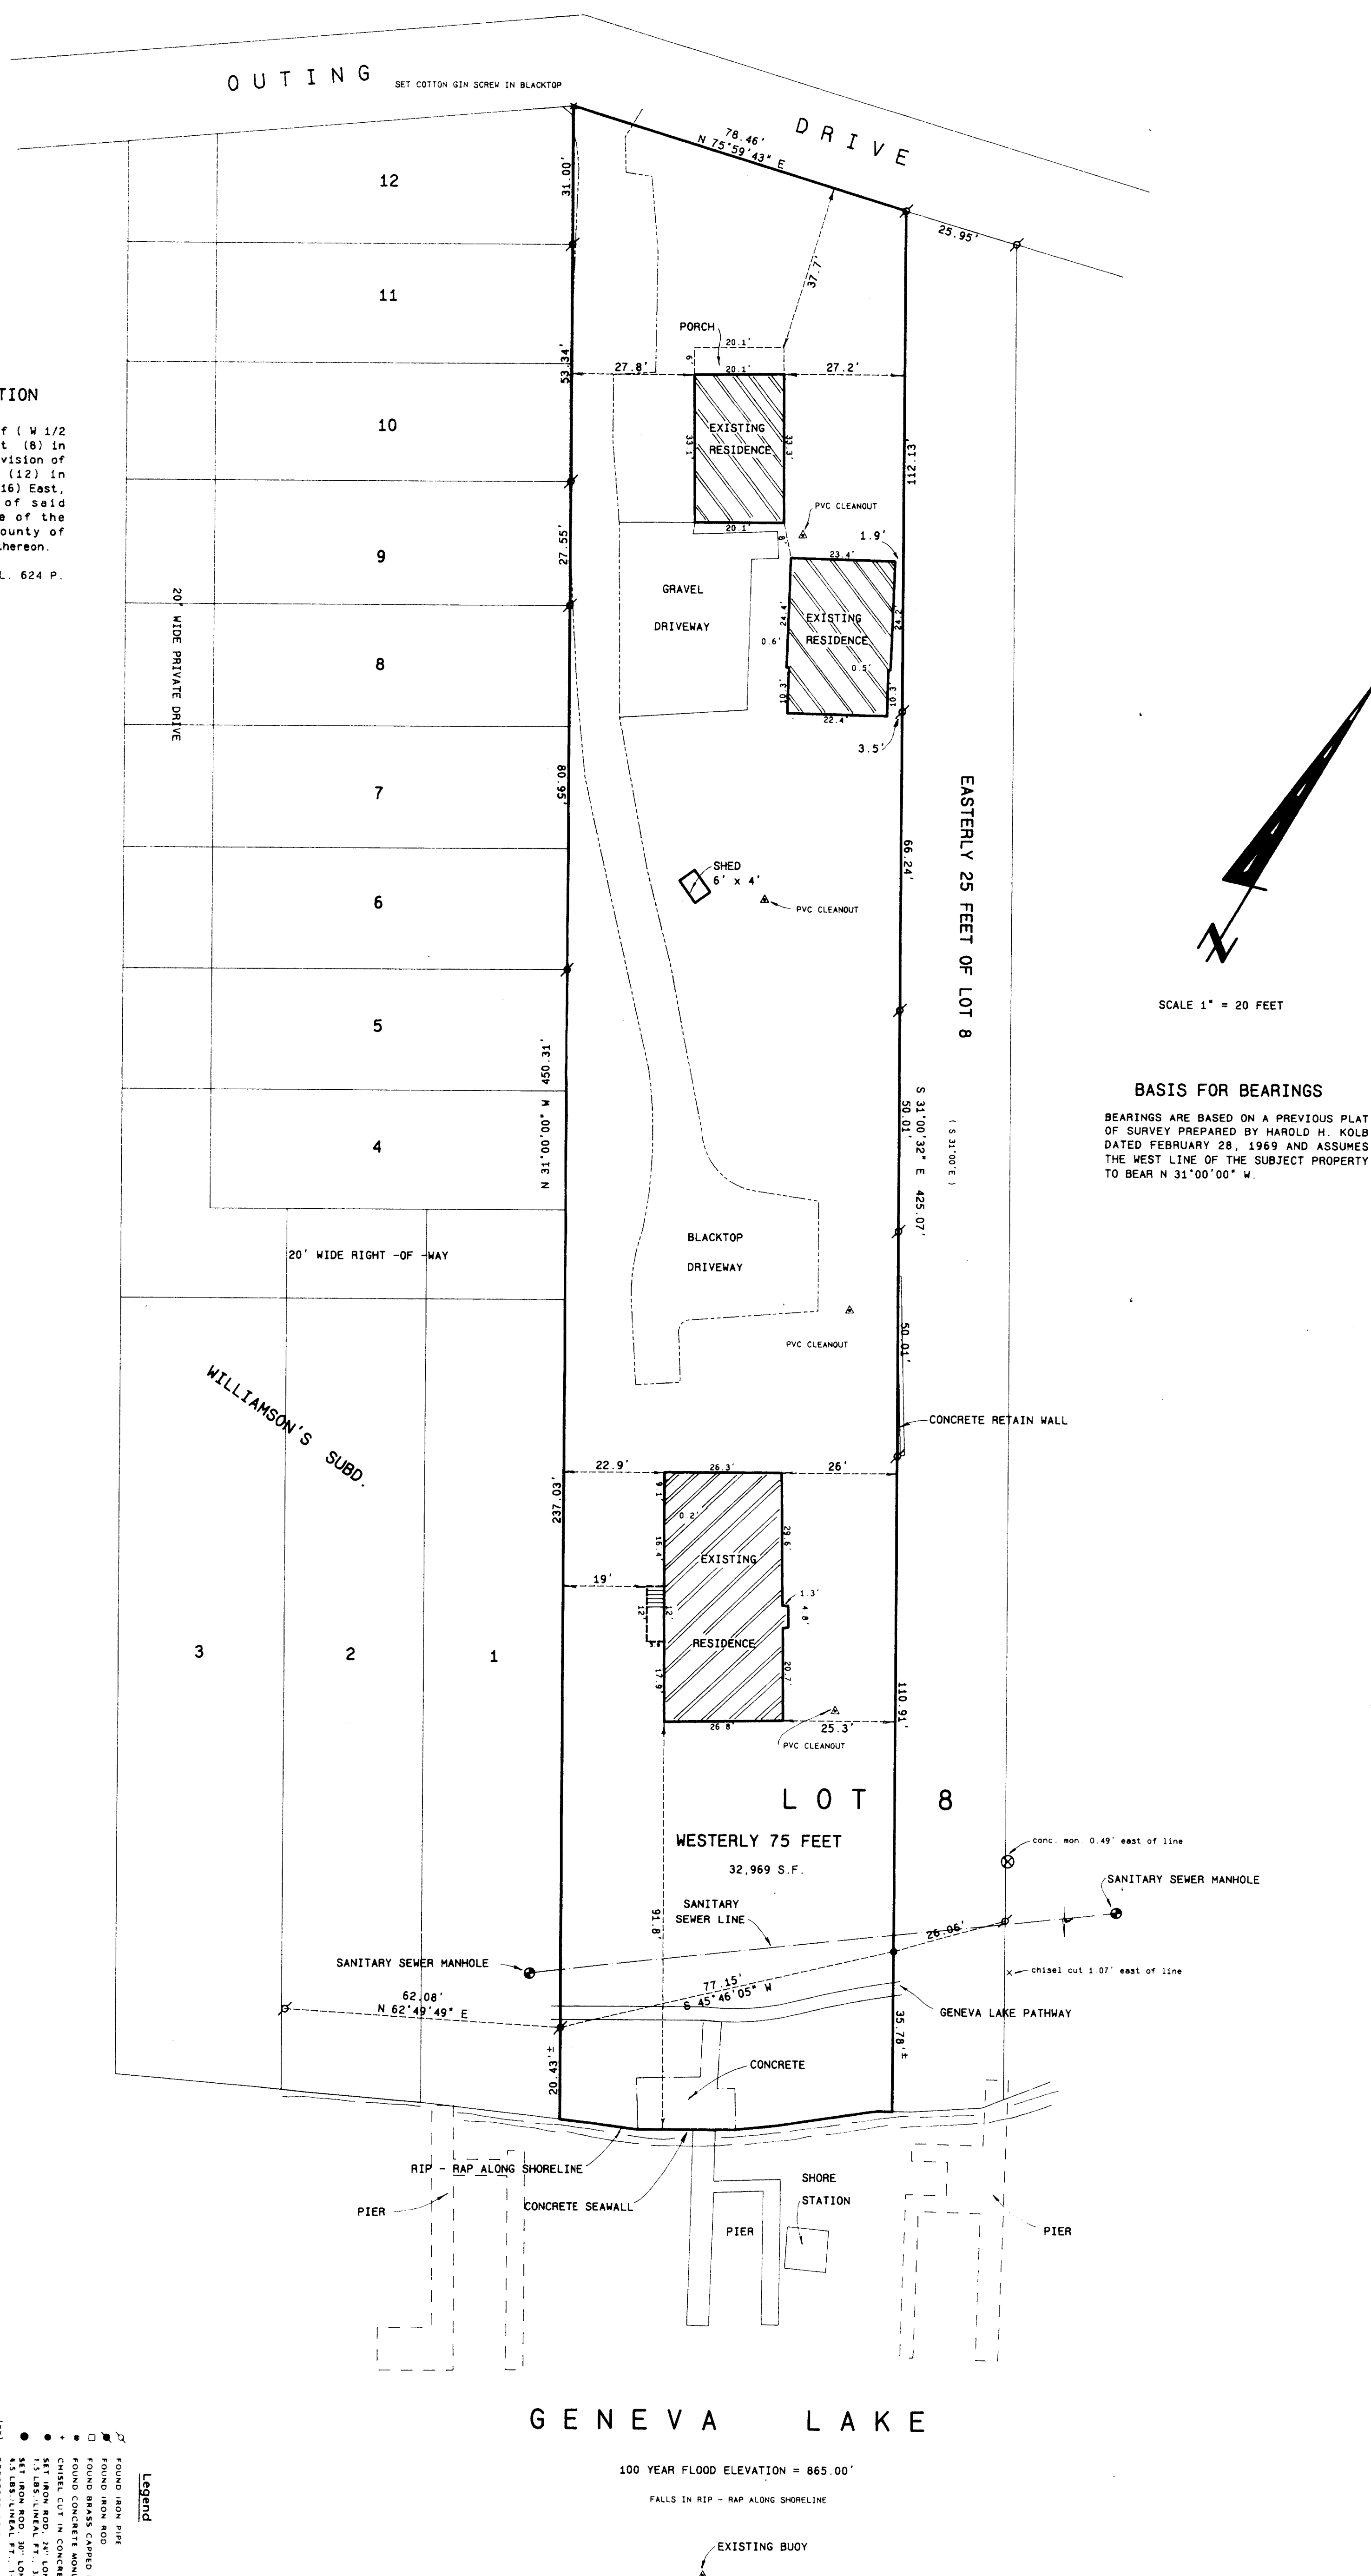

BASIS FOR BEARINGS

BEARINGS ARE BASED ON A PREVIOUS PLAT
OF SURVEY PREPARED BY HAROLD H. KOLE
DATED FEBRUARY 28, 1969 AND ASSUMES
THE WEST LINE OF THE SUBJECT PROPERTY
TO BEAR N 31°00'00" W

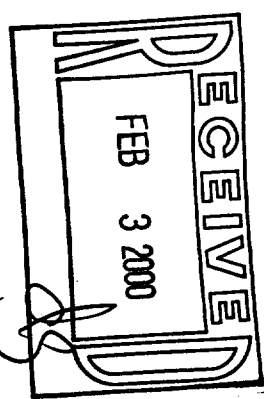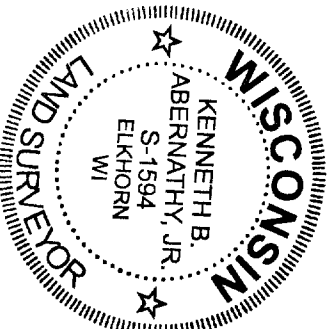

SCALE: 1" = 20 FEET

Legend

- FOUND IRON PIPE
 - FOUND IRON ROD
 - FOUND BRASS CAPPED MONUMENT
 - FOUND CONCRETE MONUMENT
 - CHISEL CUT IN CONCRETE
 - SET IRON ROD, 24" LONG, WEIGHING 1.5 LBS./LINEAL FT., 3/8" DIA.
 - SET IRON ROD, 30" LONG, WEIGHING 4.5 LBS./LINEAL FT., 1/2" DIA.
- RECORDED AS DIMENSION
EXISTING FENCE

WISCONSIN REGISTERED LAND SURVEYOR,
S-1504
Date: Dec. 10, 1999 Job No. 99.1006

Ø11-1421
WGT-6