

PLAT OF SURVEY


PATHFINDER SURVEYING
FORMERLY KOLB LAND CONSULTING
929 WILLIAMS STREET LAKE GENEVA, WI. 53147
(414) 248-3697

ORDERED BY: LAW OFFICE ALICE WOOD
1755 PARK ST SUITE 200
NAPERVILLE, IL 60563

DATE: 9-24-1999

DESCRIPTION: LOT 162 OF THE SECOND ADDITION TO
CEDAR POINT PARK, LOCATED IN THE
VILLAGE OF WILLIMAMS BAY, WALWORTH
COUNTY, WISCONSIN.

C.L. GLEN VIEW ROAD (40') WIDE

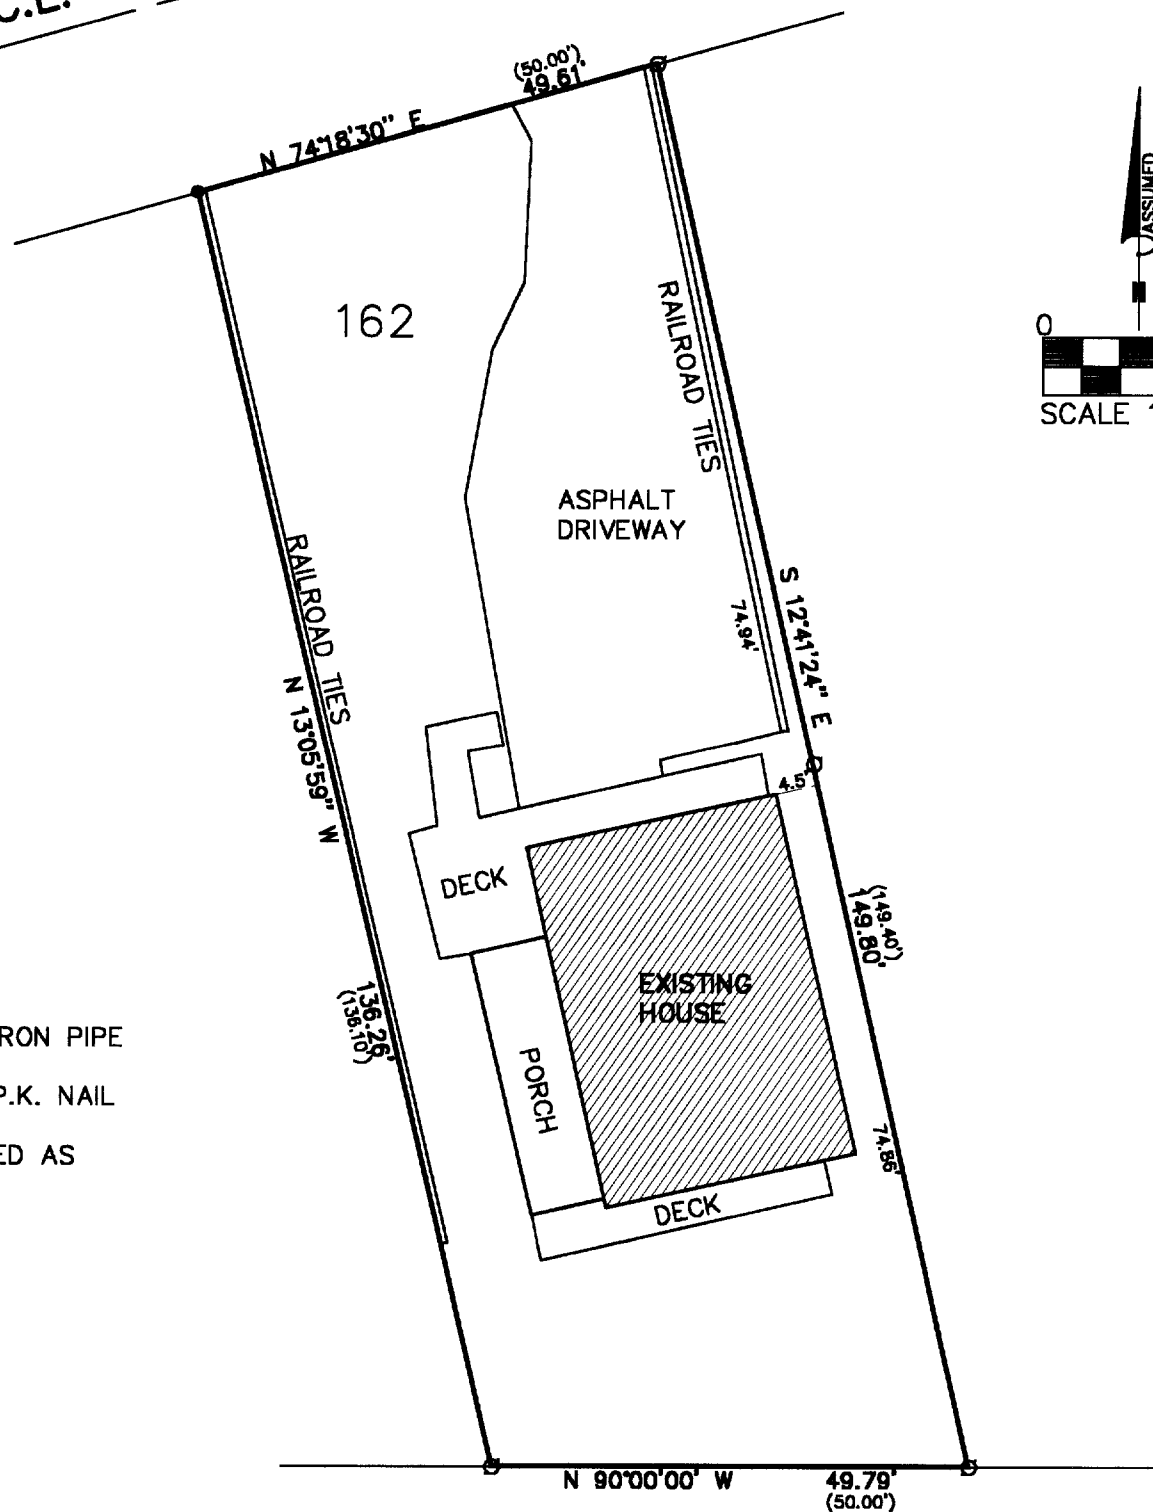

LEGEND



- FOUND IRON PIPE
- FOUND P.K. NAIL
- (XXXX) RECORDED AS

C.L. WILMETTE ROAD (40') WIDE

THE ABOVE MAP IS A TRUE REPRESENTATION THEREOF AND
SHOWS THE SIZE AND LOCATION OF ALL THE PROPERTY,
EXTERIOR BOUNDARIES, THE LOCATION OF ALL VISIBLE
BOUNDARY FENCES, APPARENT EASEMENTS, ROADWAYS
AND VISIBLE ENCROACHMENTS, IF ANY

THIS SURVEY IS MADE FOR THE USE OF THE PRESENT
OWNERS OF THE PROPERTY, AND ALSO THOSE WHO
PURCHASE, MORTGAGE OR GUARANTEE TITLE THERETO
WITHIN ONE (1) YEAR FROM DATE HERETO.

John P. Krott
JOHN P. KROTT, R.L.S. 2258

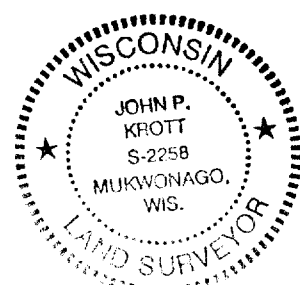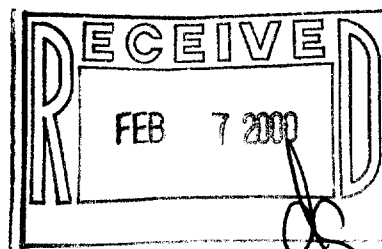

NOTE: THIS IS NOT A CERTIFIED COPY
UNLESS SEAL IS IN RED.
JOB NUMBER 99226 WCP2 00054

WCP2-54
011-1424