


PLAT OF SURVEY LOT 5 OF BLOCK 7 LAKEWOOD TRAILS SUBDIVISION

LOCATED IN THE NE 1/4 AND THE NW 1/4
OF THE NW 1/4 OF SECTION 1, TOWN 1 NORTH,
RANGE 16 EAST, VILLAGE OF WILLIAMS BAY,
WALWORTH COUNTY, WISCONSIN

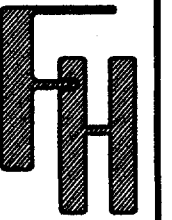

PLAT OF SURVEY
LOT 5 BLOCK 7
LAKEWOOD TRAILS SUBDIVISION

WORK ORDERED BY: C.R. CONSTRUCTION
ROGER RICHARDSON
W 5423 SOLID COMFORT DRIVE
ELKHORN, WI 53121
(262) 495-4824

FARRIS, HANSEN & ASSOCIATES, INC.
Engineering, Architecture, Surveying
7 Ridgway Court P.O. Box 437
ELKHORN, WISCONSIN 53121
Office: (414) 723-2098
Fax: (414) 723-5866

REVISIONS

PROJECT NO.
3836.07.05
DATE:
01-05-00
SHEET NO.
1 OF 1

LAKEWOOD DRIVE

66' WIDE

SAN MH
IE = 1005.14'

8" SANITARY SEWER

10' X 40'
ANTI-TRACKING MATT

30' - 12" CULVERT
CMP W/ END SEC.

12" WATERMAIN

IE = 1011.50

IE = 1011.20

S87-49-11.5W 60.73
RAD.=167.00 ARC=60.46

S 81°-48'-31"E
55.95
SAN IE =
1005.3'
(VERIFY)

30' SIDE
YARD

BITUMINOUS DRIVE

SILT FENCE
(TYP.)

15' SIDE
YARD

AS BUILT RESIDENCE

CHIMNEY

HUNG BAY

14,267 S.F.

TOPSOIL
STOCKPILE

30' REAR YARD


SILT FENCE
(TYP.)

BENCH MARK
TOP OF IRON REBAR STAKE
EL. = 1018.30'

25' WIDE
GENERAL EASEMENT

MAP SCALE IN FEET ORIGINAL 1" = 20'

SAN MH
IE = 997.8'

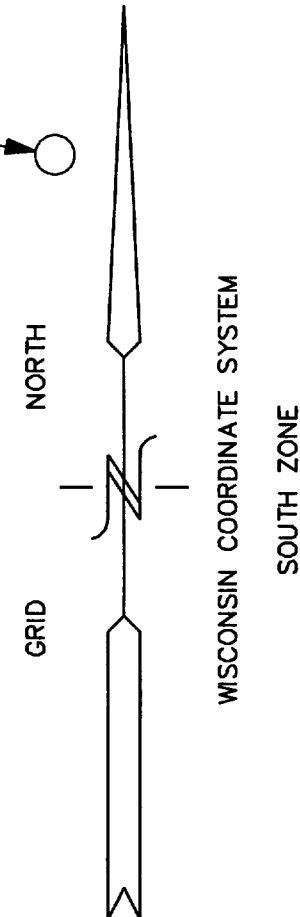

- = FOUND IRON PIPE STAKE 1" DIA.
- = FOUND IRON REBAR STAKE 3/4"
- = FOUND CONCRETE COUNTY MONUMENT
- = FOUND SOLID ROUND IRON BAR STAKE 1 5/16"
- (xxx) = RECORDED AS

NOTE: GENERAL EASEMENT IS A COMBINATION
OF UTILITY, DRAINAGE, AND WALKWAY EASEMENTS.

NOTE: COPIES OF THIS MAP TO WHICH THE FOLLOWING CERTIFICATE
WILL APPLY SHOW SURVEYOR'S ORIGINAL
SEAL AND SIGNATURE IN RED INK. COPIES BY ANY OTHER MEANS
MAY HAVE ALTERATIONS WHICH DO NOT REPRESENT THE SURVEYOR'S
WORK PRODUCT.

I HEREBY CERTIFY THAT THE ABOVE DESCRIBED PROPERTY HAS BEEN
SURVEYED UNDER MY DIRECTION AND THAT THE ABOVE MAP IS A TRUE
REPRESENTATION THEREOF AND SHOWS THE SIZE AND LOCATION OF
THE PROPERTY AND ITS EXTERIOR BOUNDARIES. THIS SURVEY IS
MADE FOR THE USE OF THE PRESENT OWNERS OF THE PROPERTY, AND
ALSO THOSE WHO PURCHASE, MORTGAGE, OR GUARANTEE THE TITLE
THERE TO WITHIN ONE YEAR FROM THE DATE HEREOF.

DATED: 04-07-2000

REVISED 12-06-2000
ADD SIZE & LOCATION OF
RESIDENCE AS BUILT

PETER S. GORDON R.L.S. 2101

DEC 05 2000

WLAK-112

011-1514