



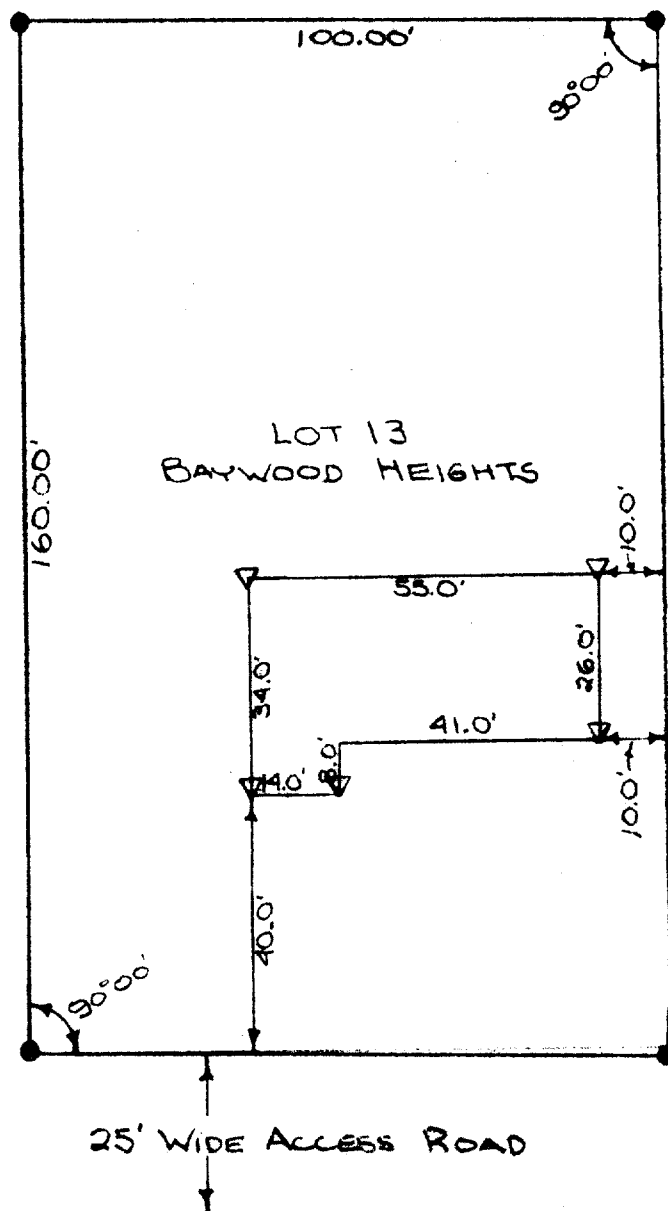

● - INDICATES IRON PIPE
▽ INDICATES WOOD STAKE

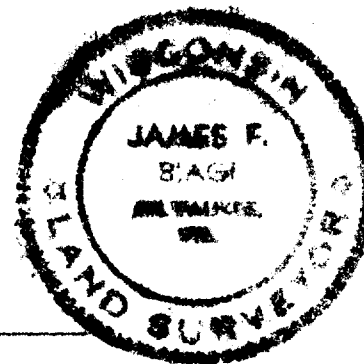

STATE HWY. "36"

DESCRIPTION: Lot 13 of Baywood Heights Subd. located in the NW $\frac{1}{4}$ of Section 1, T1N, R16E, in the Village of Williams Bay, Walworth County, Wisconsin.

CERTIFICATE: I, James F. Biagi, surveyor, do hereby certify that I have surveyed the property hereon described.

DATE: June 24, 1971

James F. Biagi
James F. Biagi
Walworth, Wisconsin
HLS 272
158