


1140 SEQUOIA STREET • DELAVAN, WISCONSIN 53115
262-728-6737

MAR 5 2003

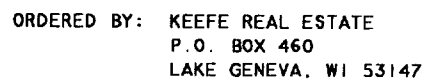

NOTE: BEARINGS ARE REFERENCED TO THE
RECORDED SUBDIVISION PLAT.

LOT 22 AND THE WEST 1/2 OF LOT 23, BAYWOOD
HEIGHTS ADDITION NO. 1, LOCATED IN THE
VILLAGE OF WILLIAMS BAY, WALWORTH COUNTY,
WISCONSIN.

REVISÉ ET RECERTIFIÉ OCTOBRE 22, 2002

I HEREBY CERTIFY THAT I HAVE SURVEYED THE ABOVE DESCRIBED PROPERTY AND THAT THE ABOVE MAP IS A TRUE REPRESENTATION THEREOF AND SHOWS THE SIZE AND LOCATION OF THE PROPERTY, ITS EXTERIOR BOUNDARIES, THE LOCATION OF ALL VISIBLE STRUCTURES AND DIMENSIONS OF ALL PRINCIPAL BUILDINGS THEREON, BOUNDARY FENCES, APPARENT EASEMENTS, ROADWAYS AND VISIBLE ENCROACHMENTS, IF ANY, TO THE BEST OF MY KNOWLEDGE AND BELIEF.

THIS SURVEY IS MADE FOR THE USE OF THE PRESENT OWNERS OF THE PROPERTY, AND ALSO THOSE WHO PURCHASE, MORTGAGE, OR GUARANTEE THE TITLE THERETO WITHIN ONE (1) YEAR FROM DATE HEREON.

FROM DATE HEREON.

David F. Hall

DAVID F. ABELL
WISCONSIN REGISTERED LAND SURVEYOR, S-1596

August 6; 1996

DATE _____ JOB NUMBER - 96141A
NOTE: THIS IS NOT A CERTIFIED COPY UNLESS SEALED.

SCALE 1" = 40'

LEGEND

- Ø -IRON PIPE FOUND
 ● -CONCRETE MONUMENT FOUND
 △ -UTILITY POLE
 —→ -GUY WIRE
 ——— -OVERHEAD UTILITY LINES
 — -CHAINLINK FENCE
 () -RECORDED AS

✓ WBW1-2

011-1712