


DUNHAM SURVEYING, S.C.
SURVEYING & SUBDIVIDING
DELAVER, WISCONSIN 53115

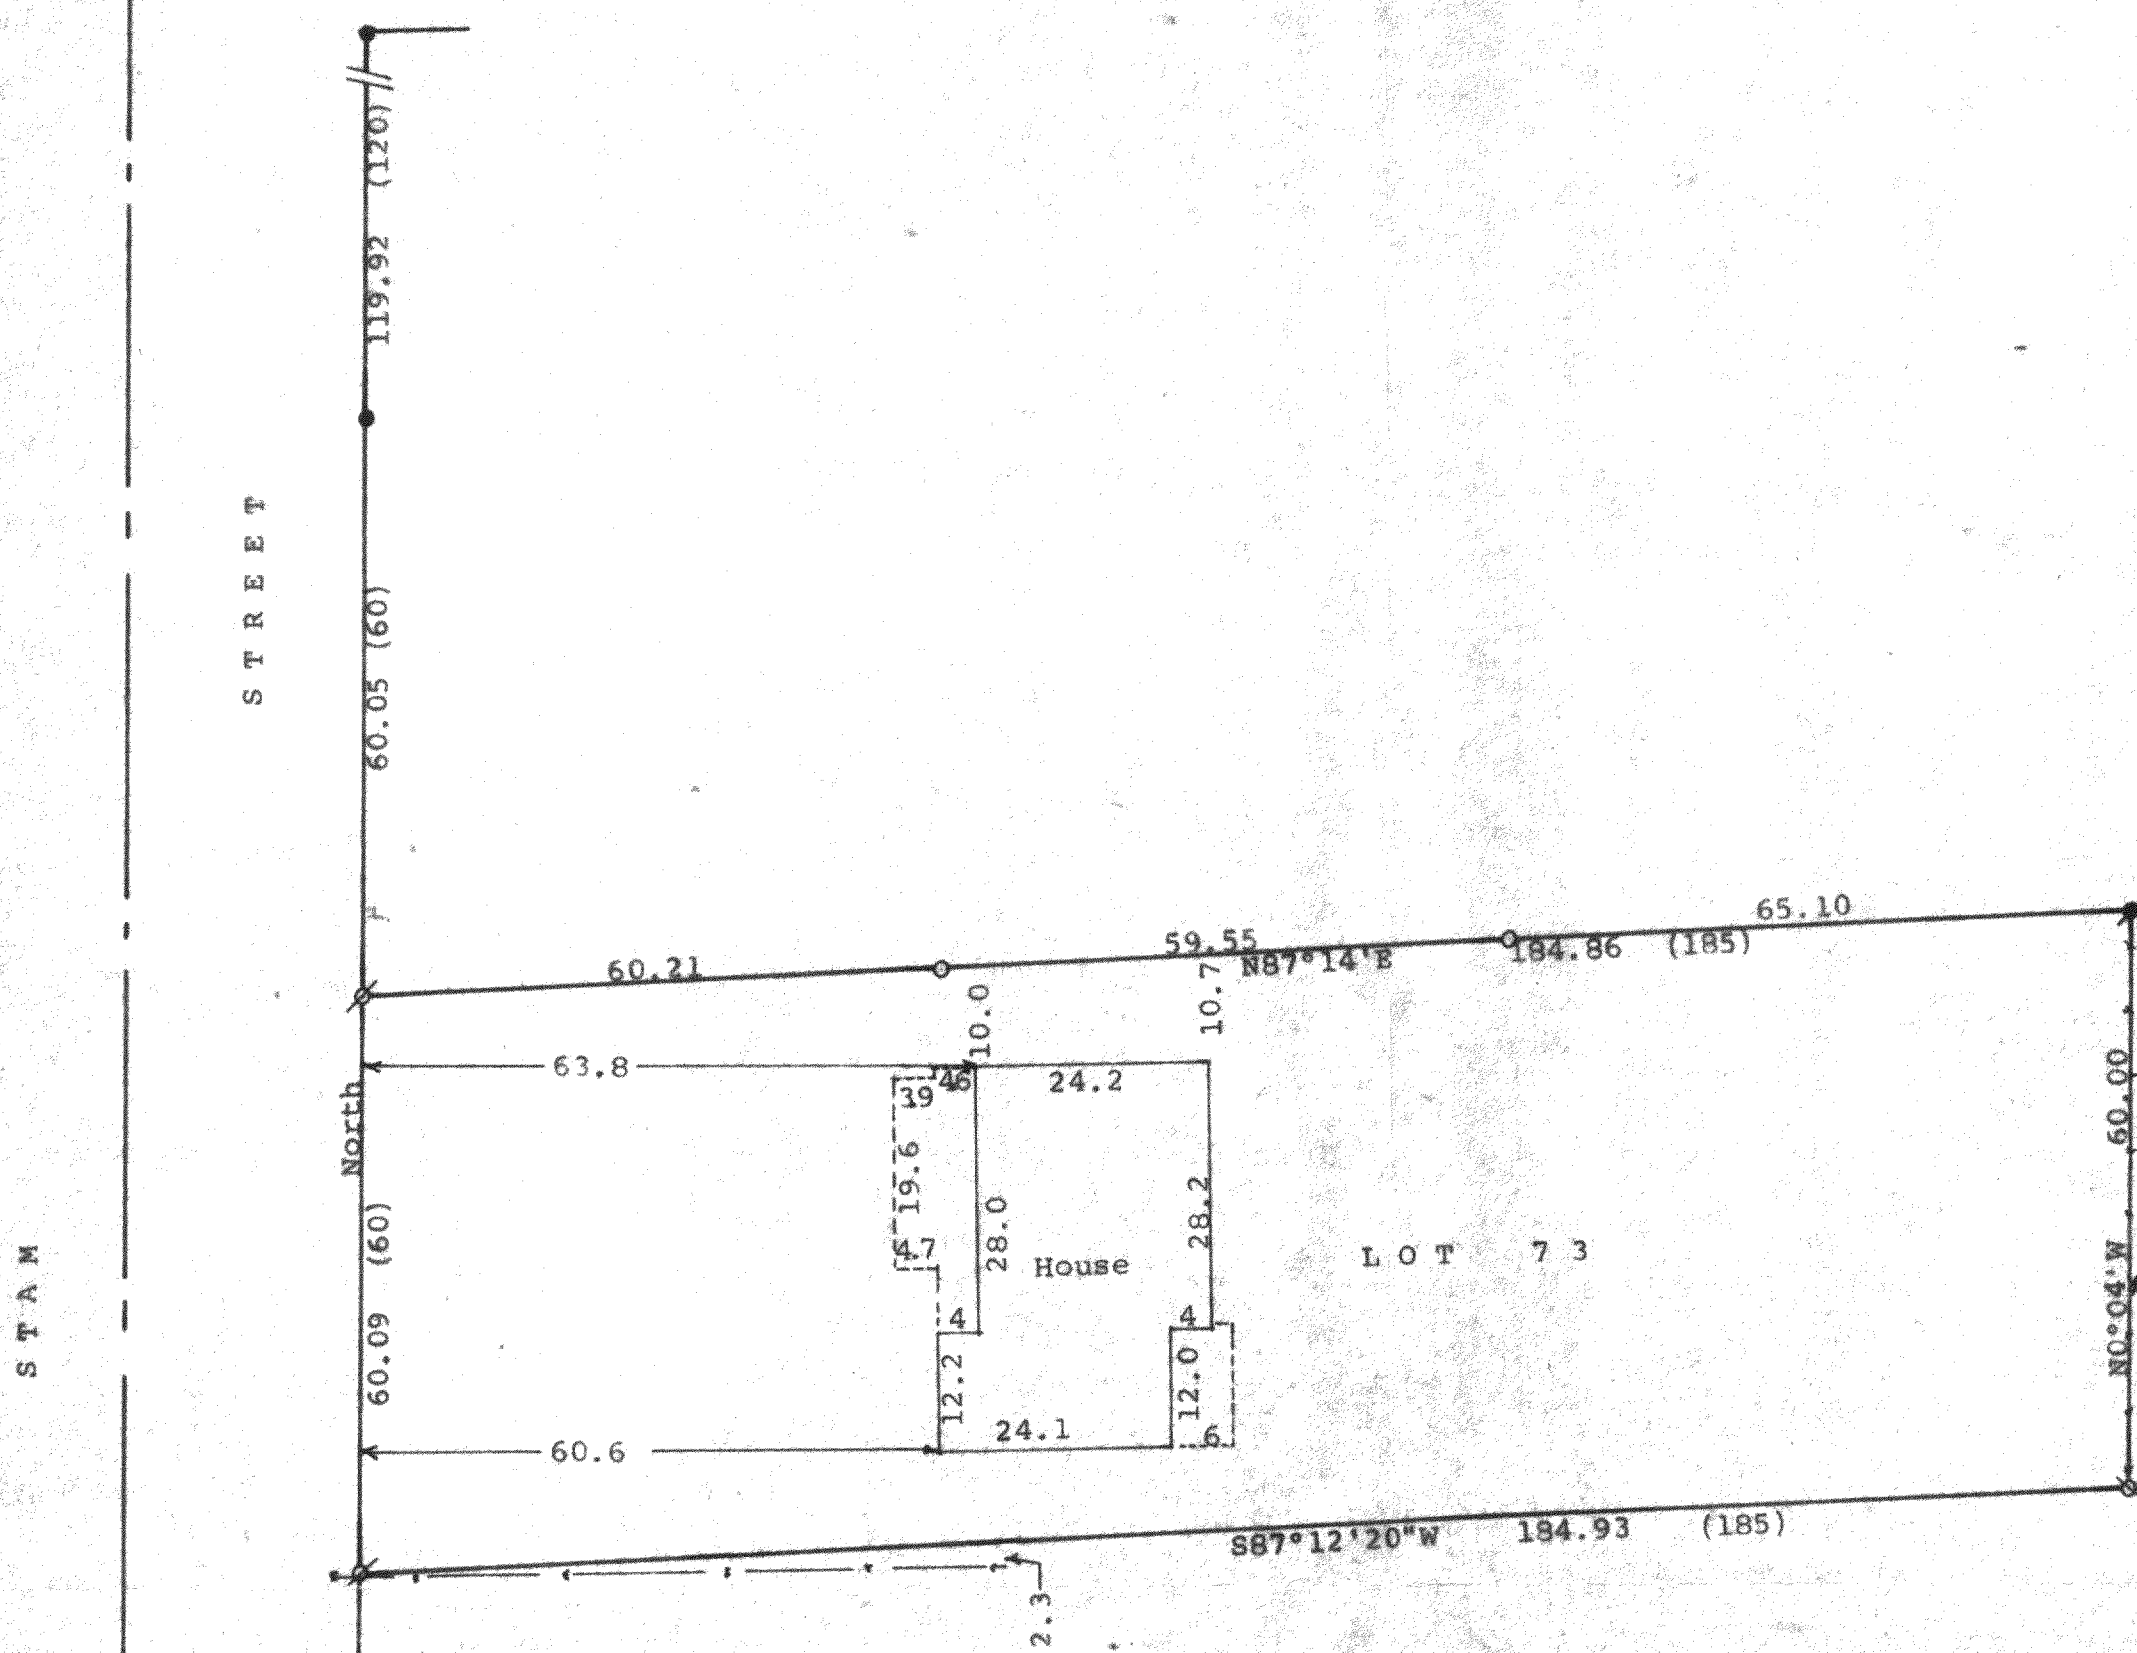

N

Scale - 1" = 20'
 * = 1 1/4" Iron Pipe Found
 Ø = 1" Iron Pipe Found
 Q = 3/4" Iron Pipe Found
 O = 1/2" Iron Pipe Set
 (0.00) = recorded distance
 Bearings referenced to the east line of
 Stam Street with the assumed bearing
 of North

Survey ordered by: Glacier Realty
 W5109 Cty Rd A
 Elkhorn, WI 53121

● = Concrete Monument Found

--- = Fence Line

Updating and recertification ordered
 by: Keefe Real Estate, Inc.
 P.O. Box 460
 Lake Geneva, WI 53147

STATE OF WISCONSIN) SS
 COUNTY OF WALWORTH)

I, George T. Dunham, Surveyor, certify that I have surveyed the
 property described as follows:

Lot 73, Bay View Subdivision located in the Village of Williams
 Bay, Walworth County, Wisconsin,

and that the plat shown hereon is a correct representation thereof and shows
 the size and location of the property, its exterior boundaries, the location
 of all visible structures and dimensions of all principal buildings thereon,
 boundary fences, apparent easements, roadways and visible encroachments, if
 any, and that I have surveyed the property hereon described, according to the
 official records, to the best of my knowledge and belief.

May 24, 1995

Updated & recertified to this
 12th day of March, 1998

George T. Dunham
 George T. Dunham, Surveyor

