

DUNHAM SURVEYING, S.C.
SURVEYING & SUBDIVIDING
DELAVER, WISCONSIN 53115

N



Scale - 1" = 20'

Ø = 3/4" Iron Pipe Found

○ = 3/4" X 24" Iron Pipe Set

(0.00) = recorded distance

Bearings referenced to the east line of Cedar Point Drive with the assumed bearing of North

Survey ordered by: William Pyne

73 Cedar Point Drive

Williams Bay, WI 53191

Updating and recertification ordered by:

Newport Realtors

101 Broad Street

Lake Geneva, WI 53147

Updating and recertification on October 7, 1996

ordered by:


Keefe Real Estate

704 West Main

Lake Geneva, WI 53147

CEDAR POINT DRIVE

DRIVE

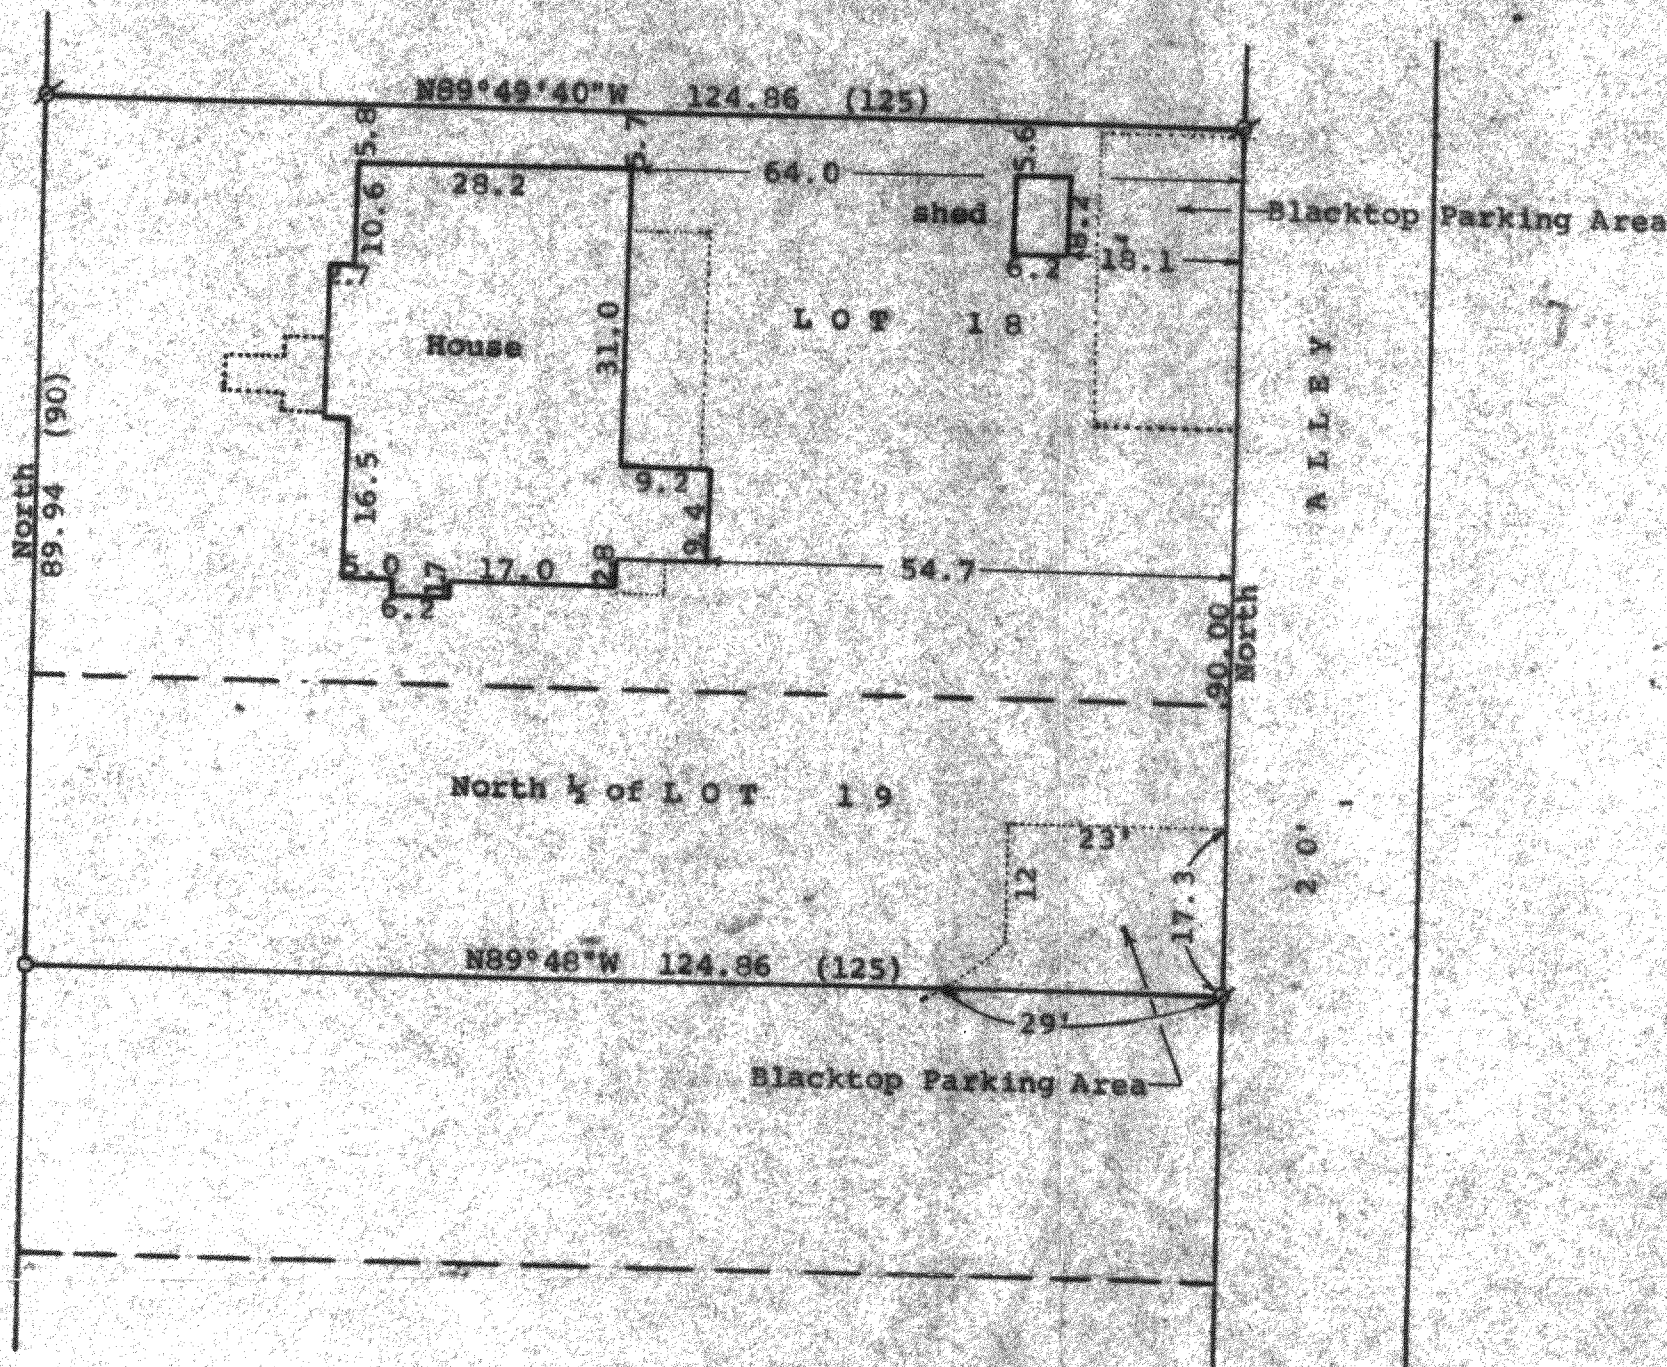

STATE OF WISCONSIN) ss
COUNTY OF WALWORTH)

I, George T. Dunham, Surveyor, certify that I have surveyed the property described as follows:

Lot 18 and the North 1/4 of Lot 19 in Cedar Point Park, a subdivision located in the Village of Williams Bay, Walworth County, Wisconsin, and that the plat shown hereon is a correct representation thereof and shows the size and location of the property, its exterior boundaries, the location of all visible structures and dimensions of all principal buildings thereon, boundary fences, apparent easements, roadways and visible encroachments, if any, and that I have surveyed the property hereon described, according to the official records, to the best of my knowledge and belief.

July 2, 1991

Updated and recertified to this 31st day of August, 1992

Updated and recertified to this 7th day of October, 1996

George T. Dunham
George T. Dunham, Surveyor

