



WCP-108
WCP-110
WCP-112

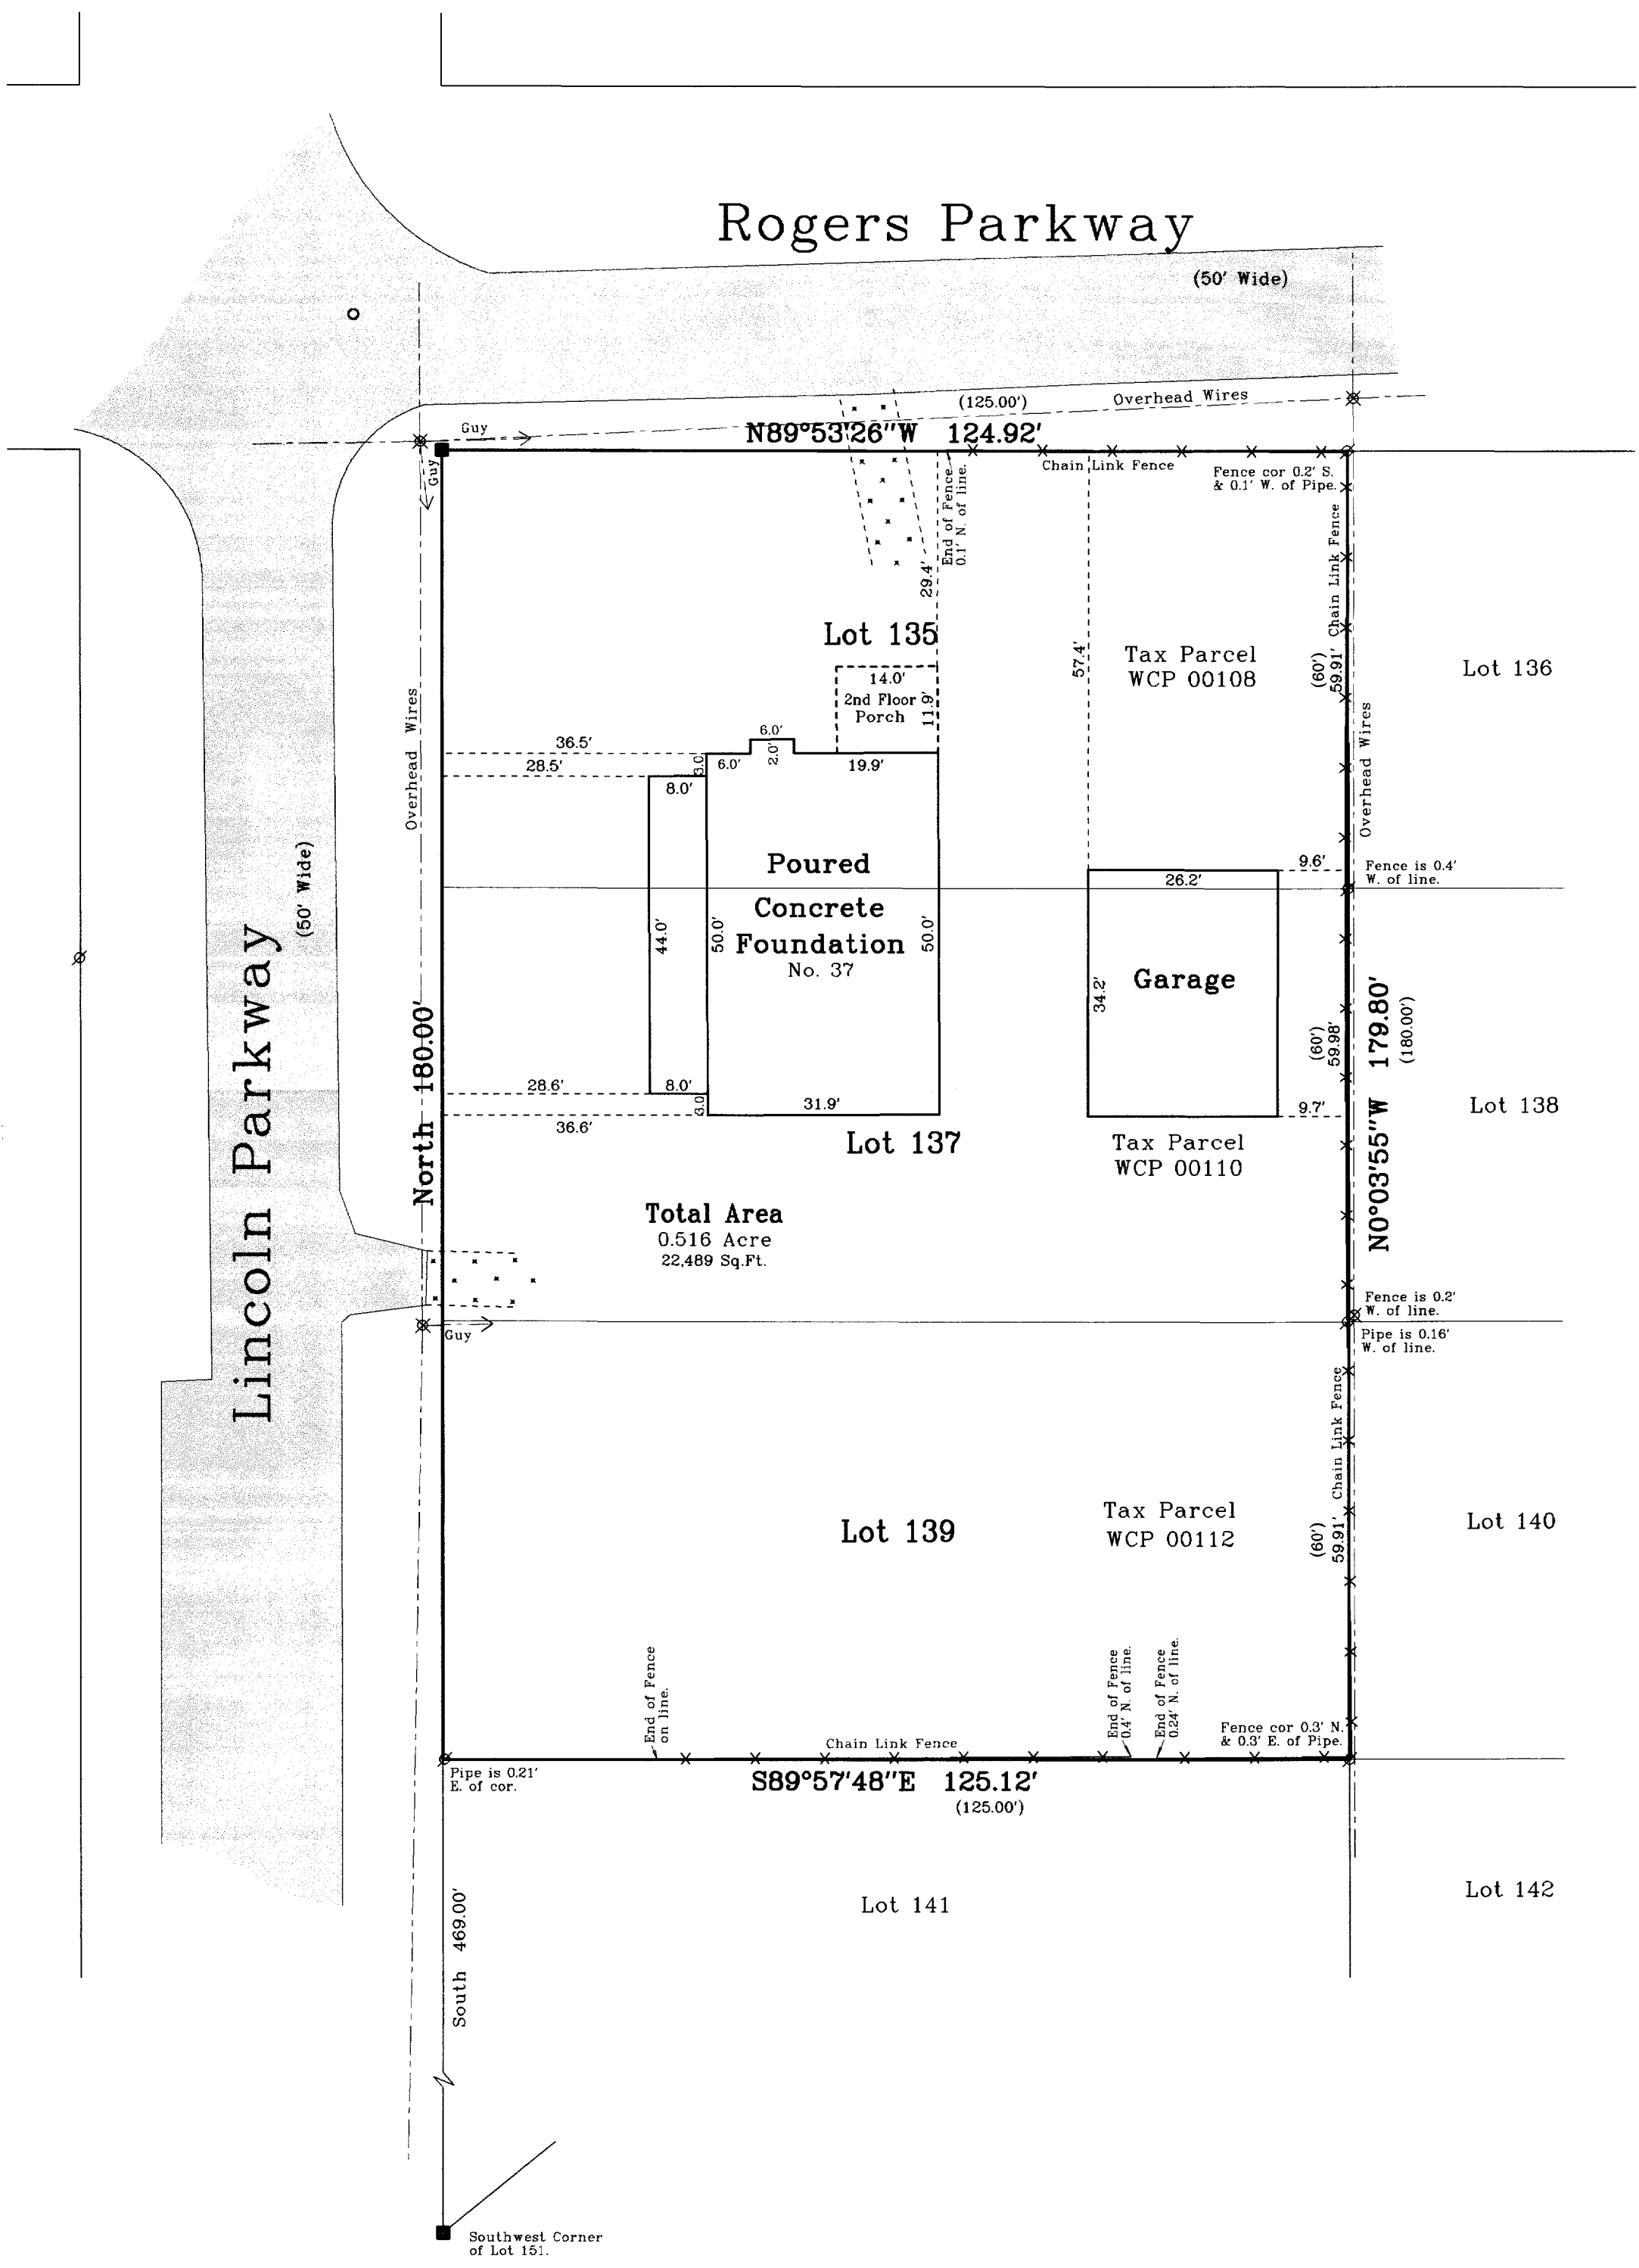

Plat of Survey

of
Lots 135, 137 and 139 of Cedar Point Park,
a subdivision located in the Southeast 1/4 of Section 6, Town 1 North,
Range 17 East, Village of Williams Bay, Walworth County, Wisconsin.

Surveyed for: **Jean Feehan**
6525 North Nakomis Avenue
Lincolnwood, Illinois. 60712-3025

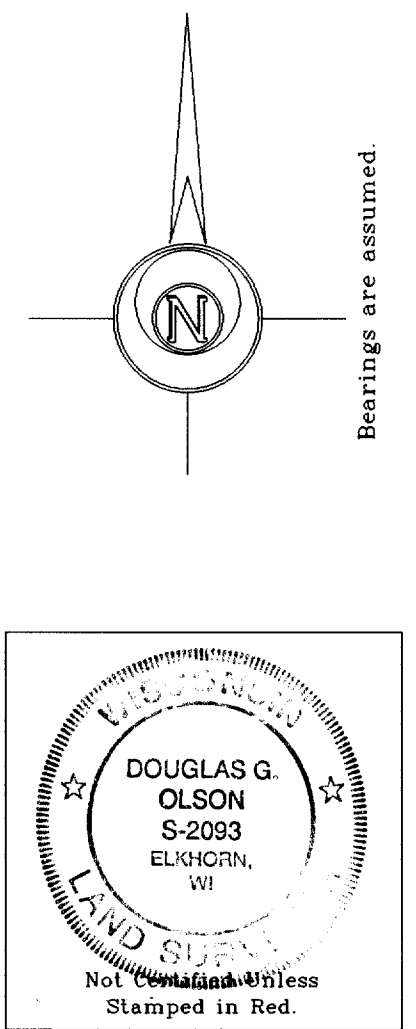

- Notes: 1) This survey plat is not certified unless signed and sealed in red ink.
- 2) This survey is subject to Wisconsin lien laws. This Plat of Survey is the notice of intent to file lien. Lien waiver required.


Copyright © 2002 by Jensen & Olson Land Surveying, LLC.

All rights reserved. No part of this survey plat may be reproduced or transmitted in any form by any means - graphic, electronic, or mechanical, including photocopying, tracing, or information storage and retrieval systems - without permission in writing from Douglas G. Olson, Jensen & Olson Land Surveying, LLC.

I, Douglas G. Olson, Wisconsin Registered Land Surveyor, do hereby certify that this survey was performed by me or under my direction in full compliance with the owner's/agent's instructions and Chapter A-E 7 of the Wisconsin Administrative Code "Minimum Standards for Property Surveys"; and that this map is an accurate representation thereof to the best of my knowledge and belief.

Douglas G. Olson
Wisconsin Registered Land Surveyor - 2093

Survey Date: June 20, 2002
Revisions: No. 1 - Foundation

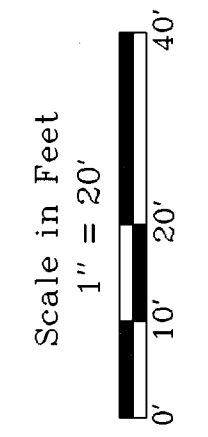

Jensen & Olson Land Surveying, LLC
45 South Wisconsin Street
Elkhorn, Wisconsin. 53121
Telephone (262) 723-3434
Facsimile (262) 723-8044
P.O. Box 322

- Legend**
- Found Concrete Monument
 - Found Iron Pipe
 - Recorded Information
 - Utility Pole
 - Survey Station
 - Concrete Surface
 - Asphalt Surface
 - Gravel

Sheet 1 of 1 Sheets
Job Reference Number
2002.222
2002.222