


PLAT OF SURVEY

OF

PART OF LOT 5 OF OBSERVATORY SUBDIVISION
LOCATED IN THE VILLAGE OF WILLIAMS BAY, IN
WALNORTH COUNTY, WISCONSIN.

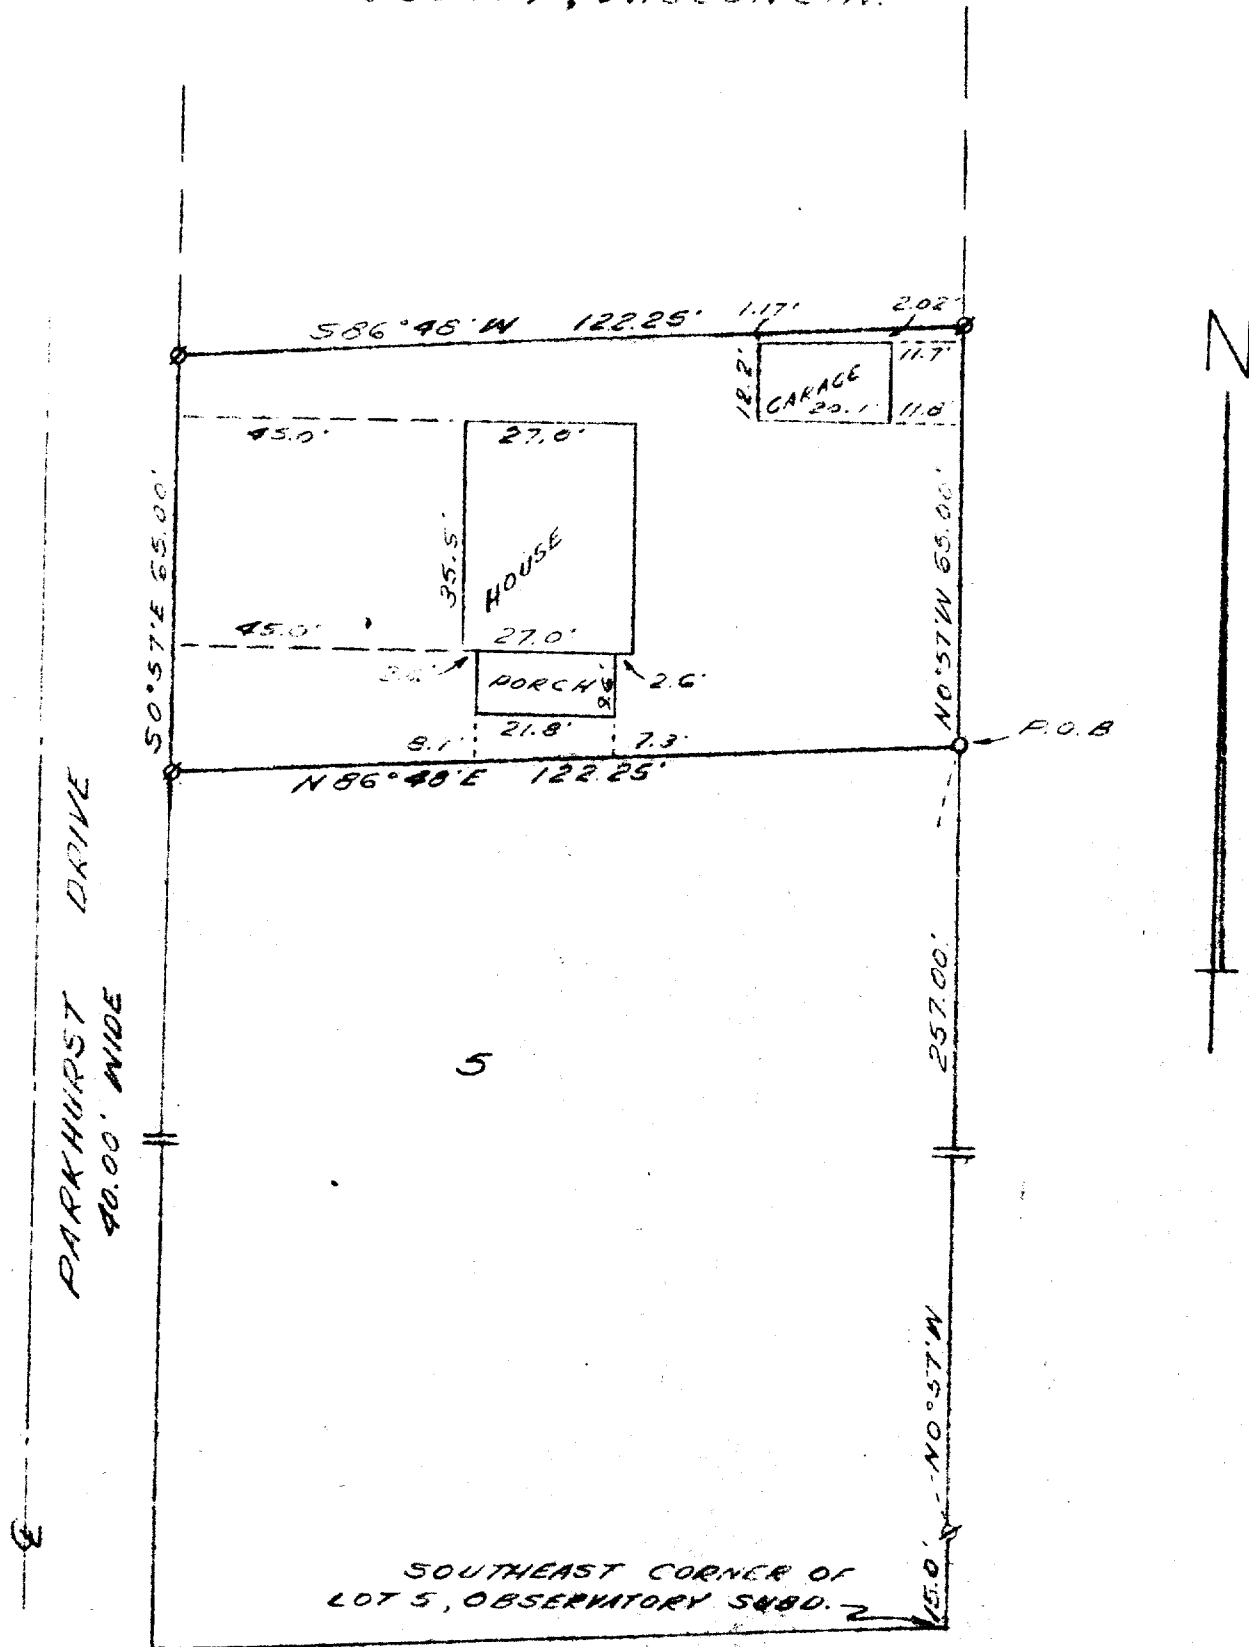

LEGEND

- — Iron Pipe
- — Concrete Monument
- Scale 1" = 30
- Ø IRON PIPE FOUND

WE CERTIFY: That we have surveyed the above described property and that the plat shown hereon is an accurate survey and a true representation thereof and correctly shows the exterior boundary lines and all divisions of said property, and all buildings located there on.

Date JANUARY 7, 1963

Lloyd L. Jensen
LOYD L. JENSEN, Partner

Wisconsin Registered Land Surveyor, No. S-211

11-175