

PREPARED FOR :  
LINDA TONGE  
KEEFE REALESTATE, INC.  
P.O. BOX 460  
LAKE GENEVA, WI. 53147

# PLAT OF SURVEY


-OF-

J.K. SURVEYING INC.  
N3705 WILLOWBEND LANE  
LAKE GENEVA, WI, 53147  
262-248-3697

LOT 25, FIRST ADDITION TO CEDAR POINT PARK, LOCATED IN SECTION 6,  
T1N, R17E, VILLAGE OF WILLIAMS BAY, WALWORTH COUNTY, WISCONSIN.

OUT - 3

RRR

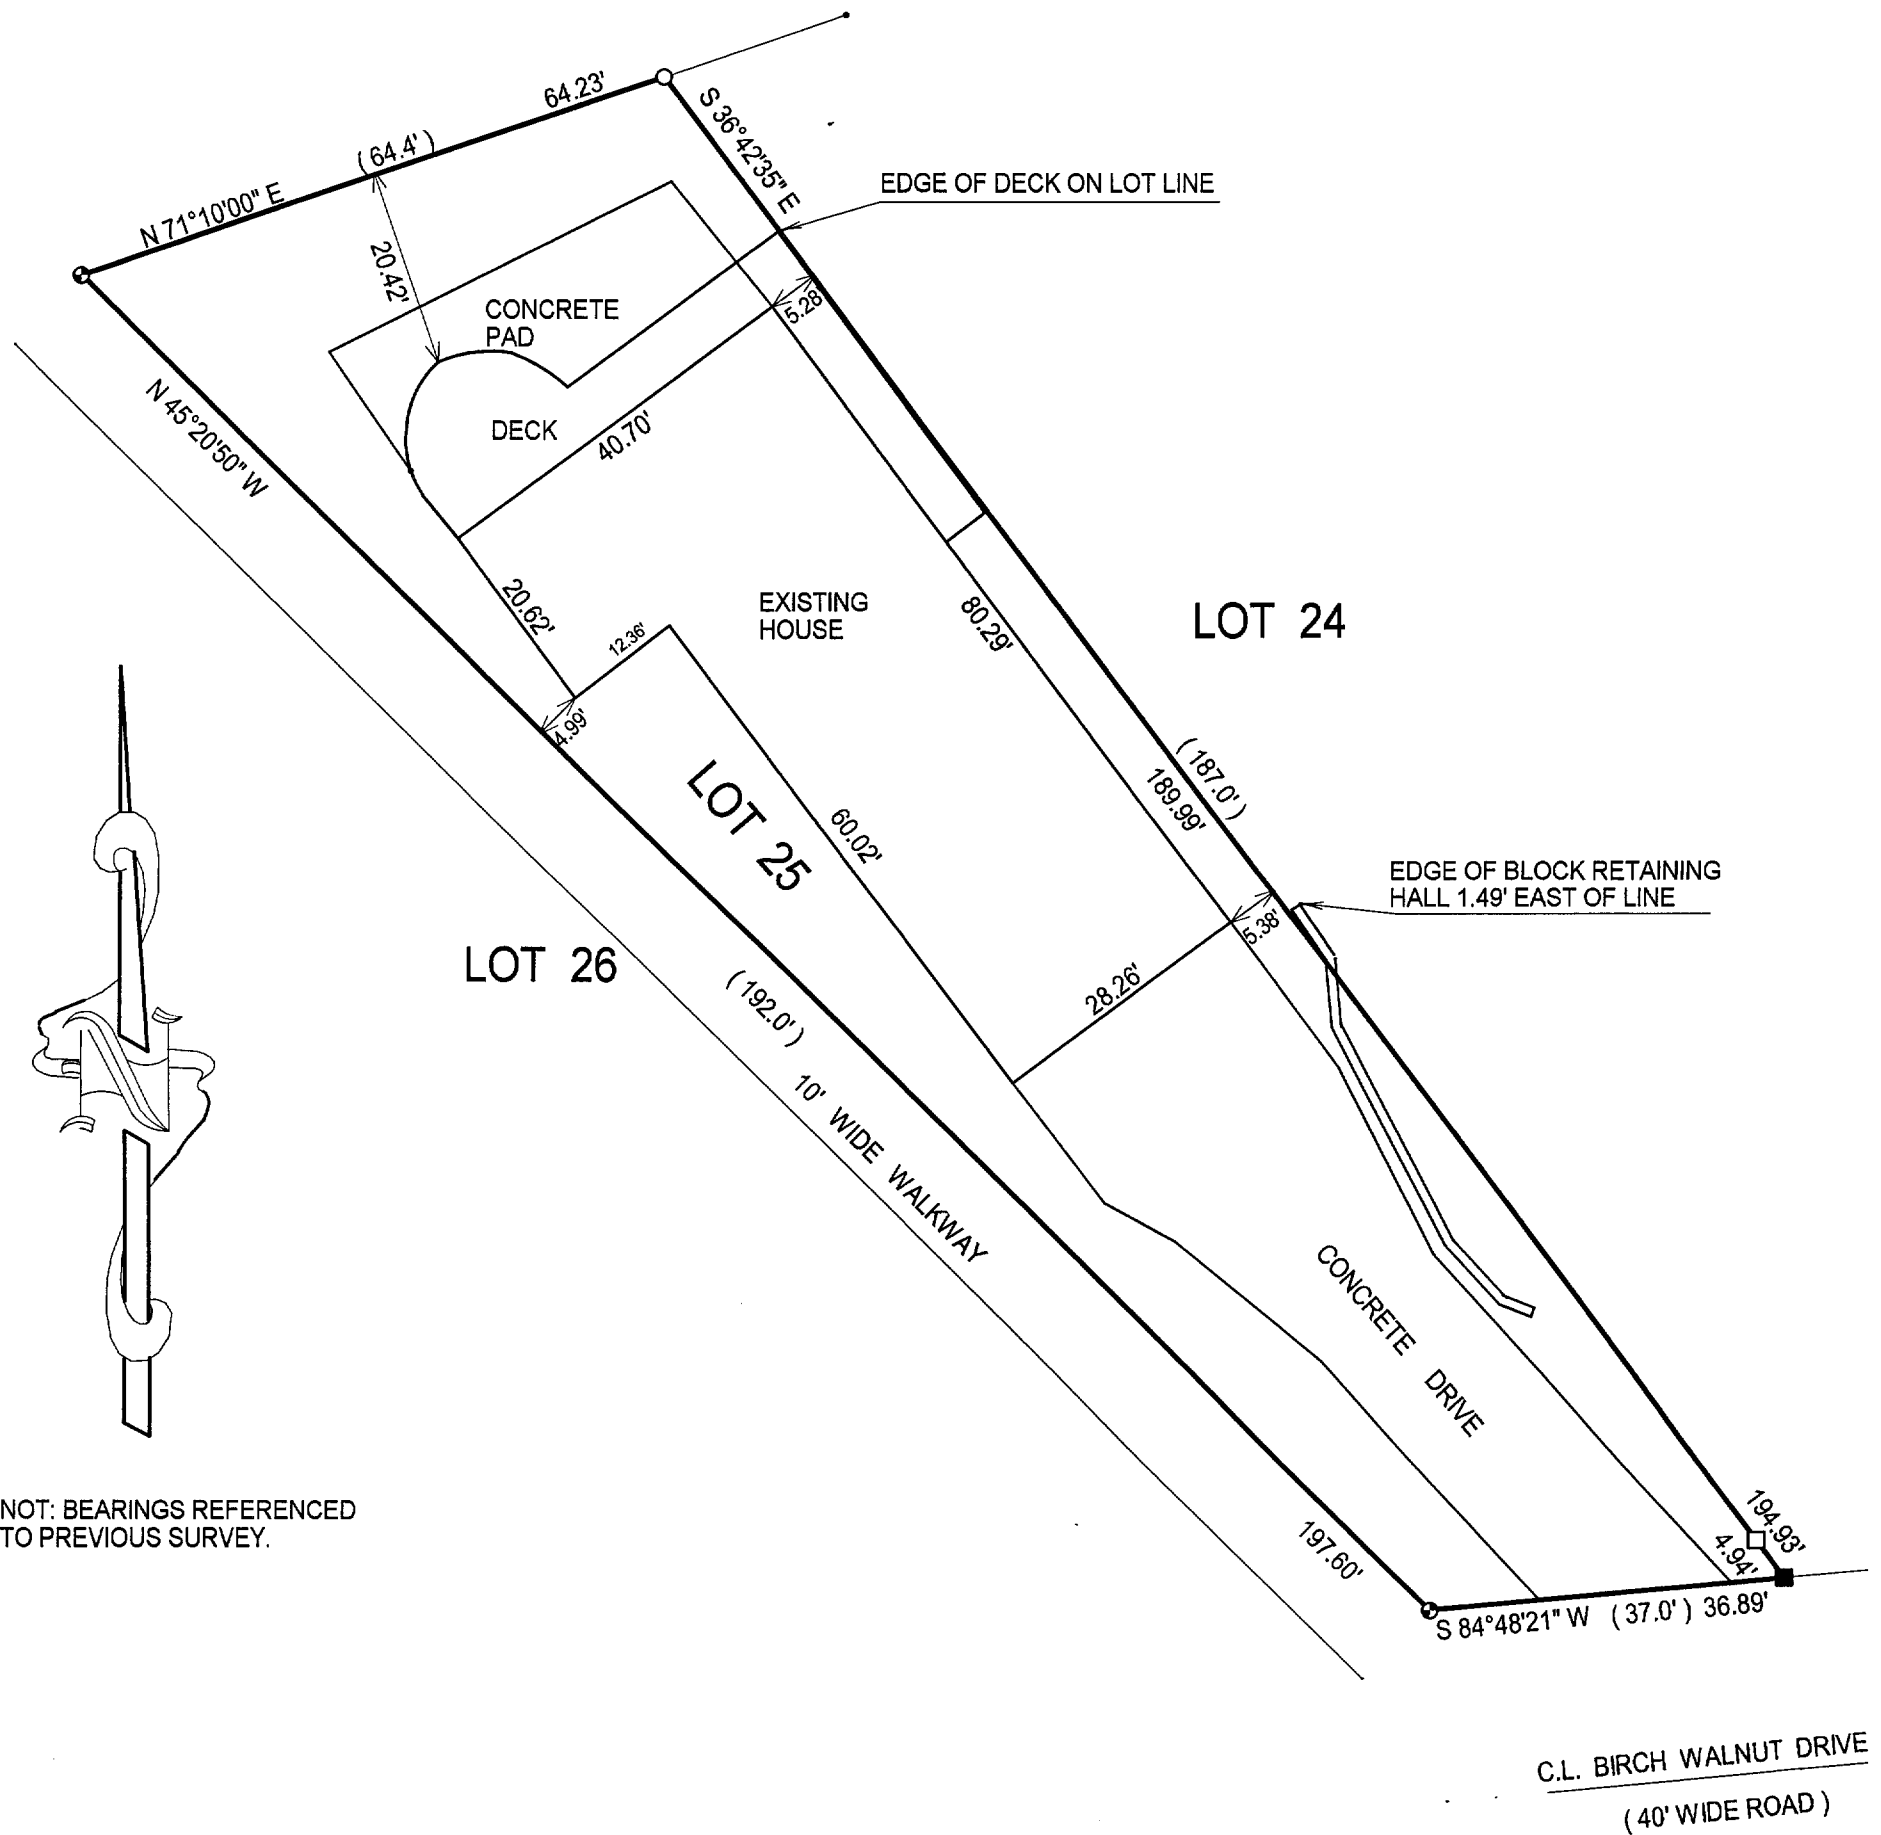

- ⊕ = found concrete monument
- = found iron bar
- = set iron bar
- = found iron pipe
- = set iron pipe

SCALE 1" = 20'

JOB # 03-363

TAX ID# WCPI 00026

COMPARE LEGAL DESCRIPTION ABOVE AND DRAWING WITH DEED. FOR BUILDING RESTRICTIONS AND EASEMENTS NOT SHOWN, REFER TO DEED, ABSTRACT SOURCES AND LOCAL MUNICIPAL CODES. NOTIFY THE SURVEYOR IMMEDIATELY OF ANY DISCREPANCY.

"I hereby certify that the above described property was surveyed under my supervision and that the above map is a true representation thereof and shows the size and location of all visible structures, apparent easements and encroachments if any."

This survey is made for the present owners of the property, and those who purchase, mortgage, or guarantee the title thereto, within one year from the date hereof.

DATED THE 1 ST, DAY OF JULY 2003



*John P. Krott*  
JOHN KROTT S - 2258  
Wisconsin Registered Land Surveyor  
(original if signed in red)

011-1783