


PREPARED FOR :
RICHARD TORHORST
500 COMMERCIAL CT.
LAKE GENEVA, WI. 53147

PLAT OF SURVEY

-OF-

J.K. SURVEYING INC.
N3705 WILLOWBEND LANE
LAKE GENEVA, WI, 53147
262-248-3697

LOTS 178 AND 179 IN SECOND ADDITION TO CEDAR POINT PARK SUBDIVISION
IN THE VILLAGE OF WILLIAMS BAY, ACCORDING TO THE PLAT THEREOF OF
RECORD IN THE OFFICE OF THE REGISTER OF DEEDS OF WALWORTH COUNTY,
WISCONSIN.

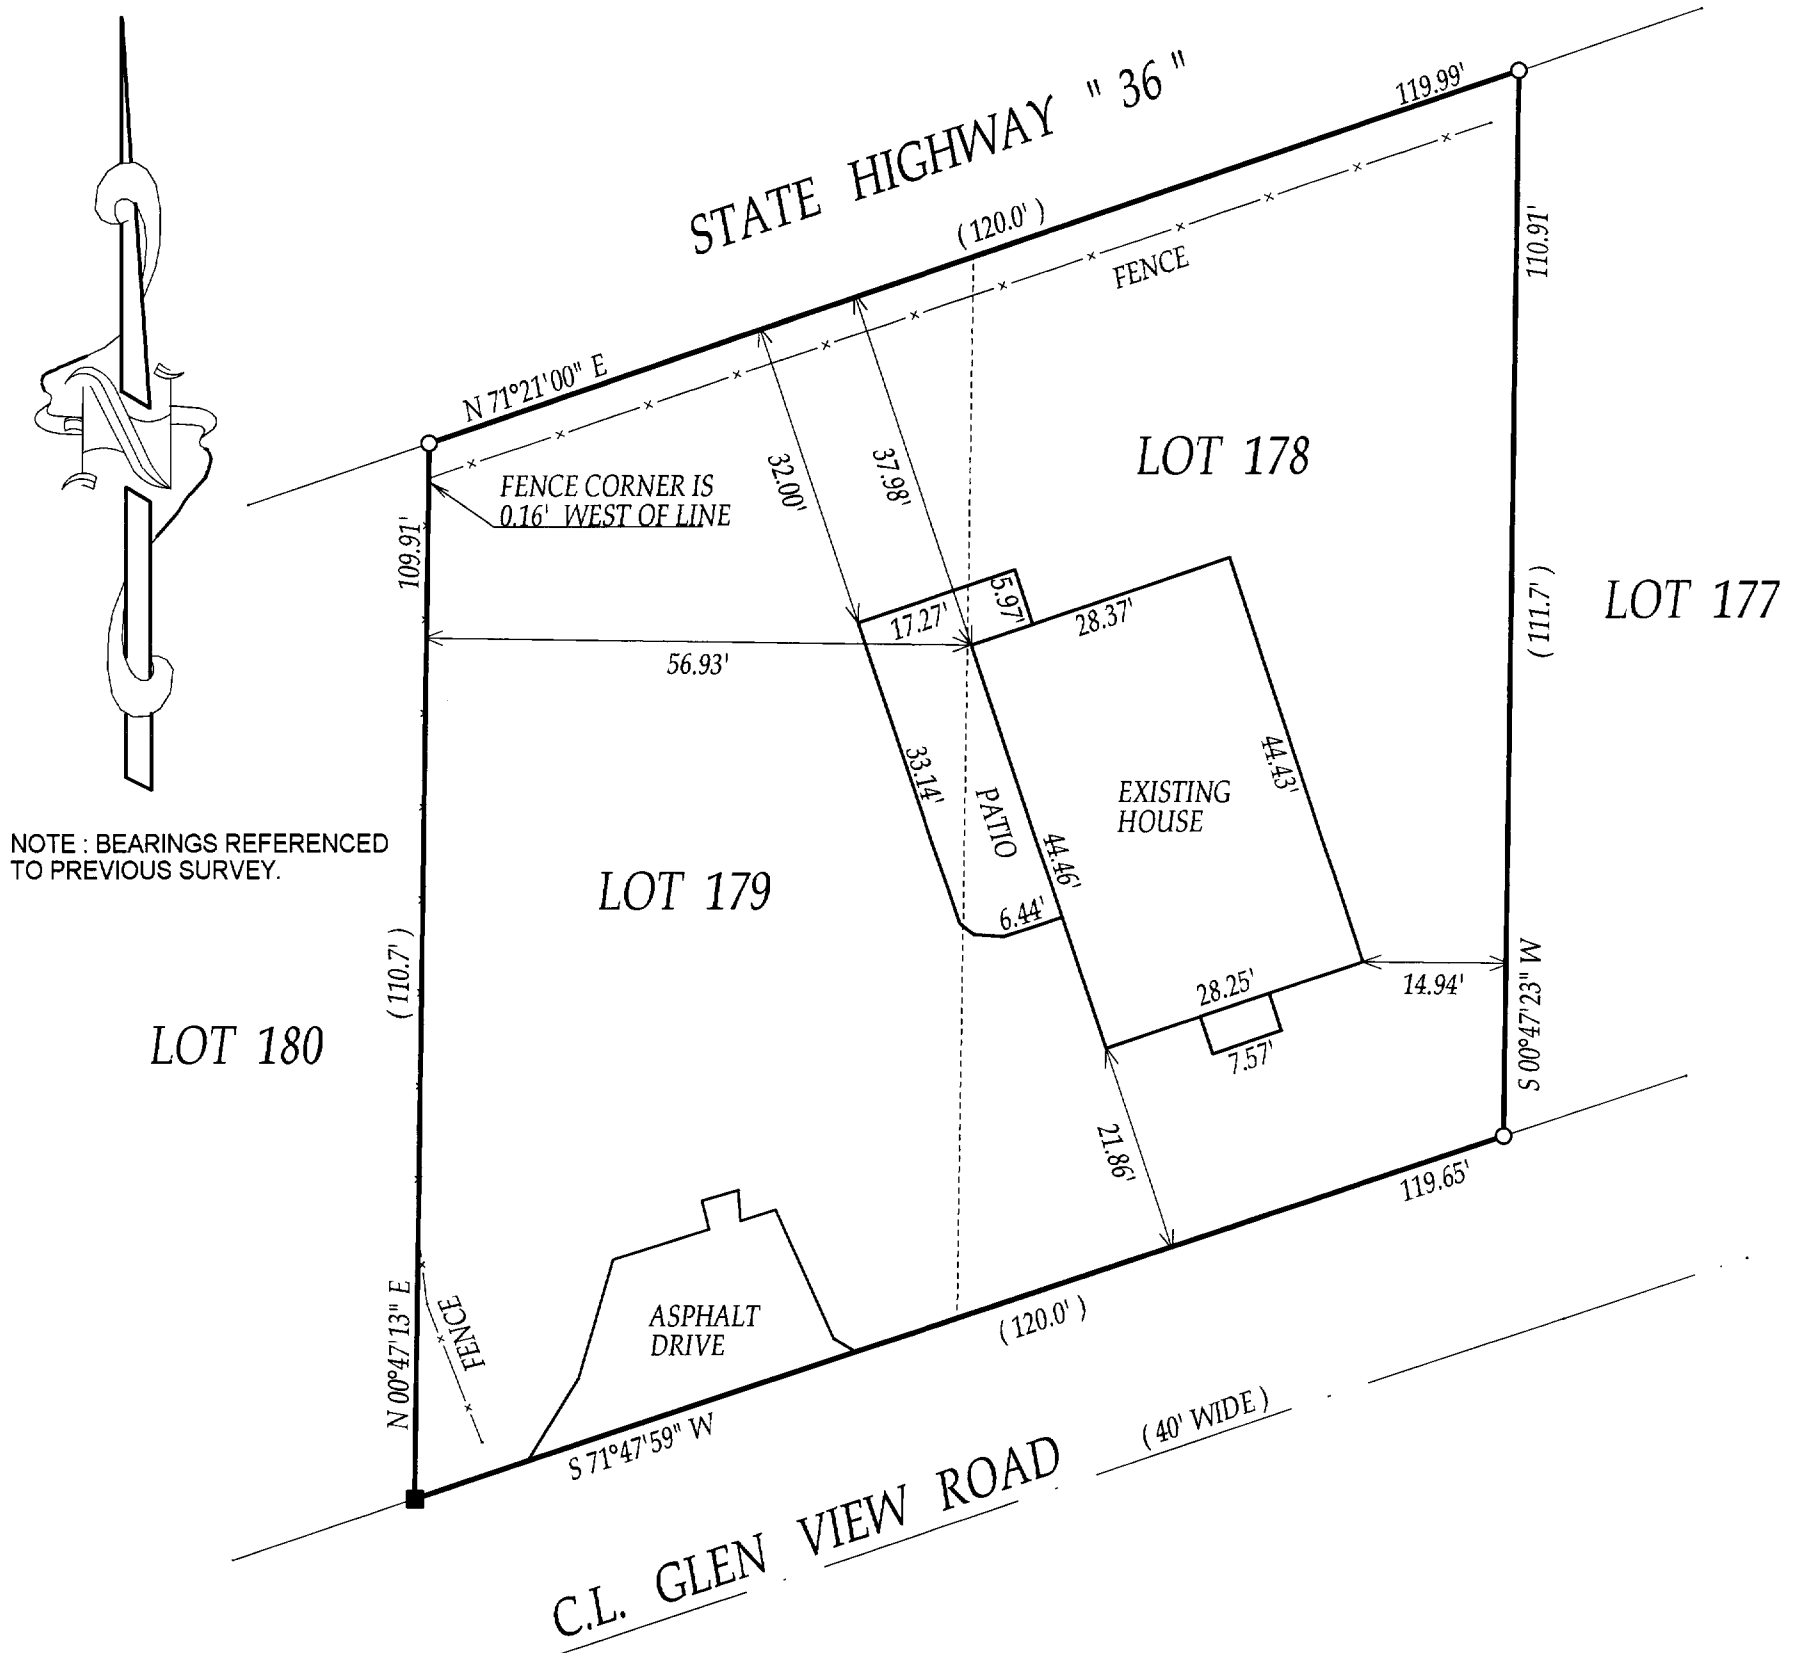

() = recorded as

□ = found iron bar

○ = found iron pipe

● = set iron pipe

■ = set iron bar

SCALE 1" = 20'

JOB # 03-386

TAX ID # WCP2 00070

COMPARE LEGAL DESCRIPTION ABOVE AND DRAWING WITH DEED. FOR BUILDING RESTRICTIONS AND EASEMENTS NOT SHOWN, REFER TO DEED, ABSTRACT SOURCES AND LOCAL MUNICIPAL CODES. NOTIFY THE SURVEYOR IMMEDIATELY OF ANY DISCREPANCY.

"I hereby certify that the above described property was surveyed under my supervision and that the above map is a true representation thereof and shows the size and location of all visible structures, apparent easements and encroachments if any."

This survey is made for the present owners of the property, and those who purchase, mortgage, or guarantee the title thereto, within one year from the date hereof.

DATED THE 09 TH, DAY OF JULY 2003

OCT - 3



JOHN P. KROTT
S-2258
MUKWONAGO, WIS.
JOHN KROTT S - 2258
Wisconsin Registered Land Surveyor
(original if signed in red)

011-1784