



PREPARED FOR:
PAUL NICOLOSI
363 FINANCIAL COURT,
SUITE 200
ROCKFORD, ILL
61107

PLAT OF SURVEY

- OF -

LOT 119 OF THE SECOND ADDITION TO CEDAR POINT PARK, VILLAGE OF WILLIAMS
BAY, ACCORDING TO THE RECORDED PLAT THEREOF, IN THE COUNTY OF WALWORTH,
STATE OF WISCONSIN.

J.K. SURVEYING INC.
N3705 WILLOWBEND LANE
LAKE GENEVA, WI, 53147
262-248-3697

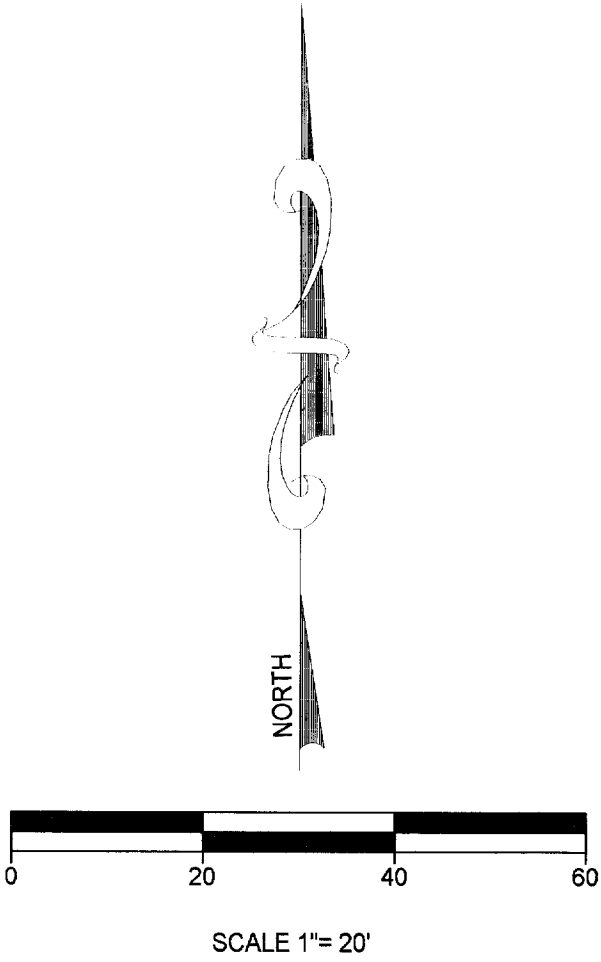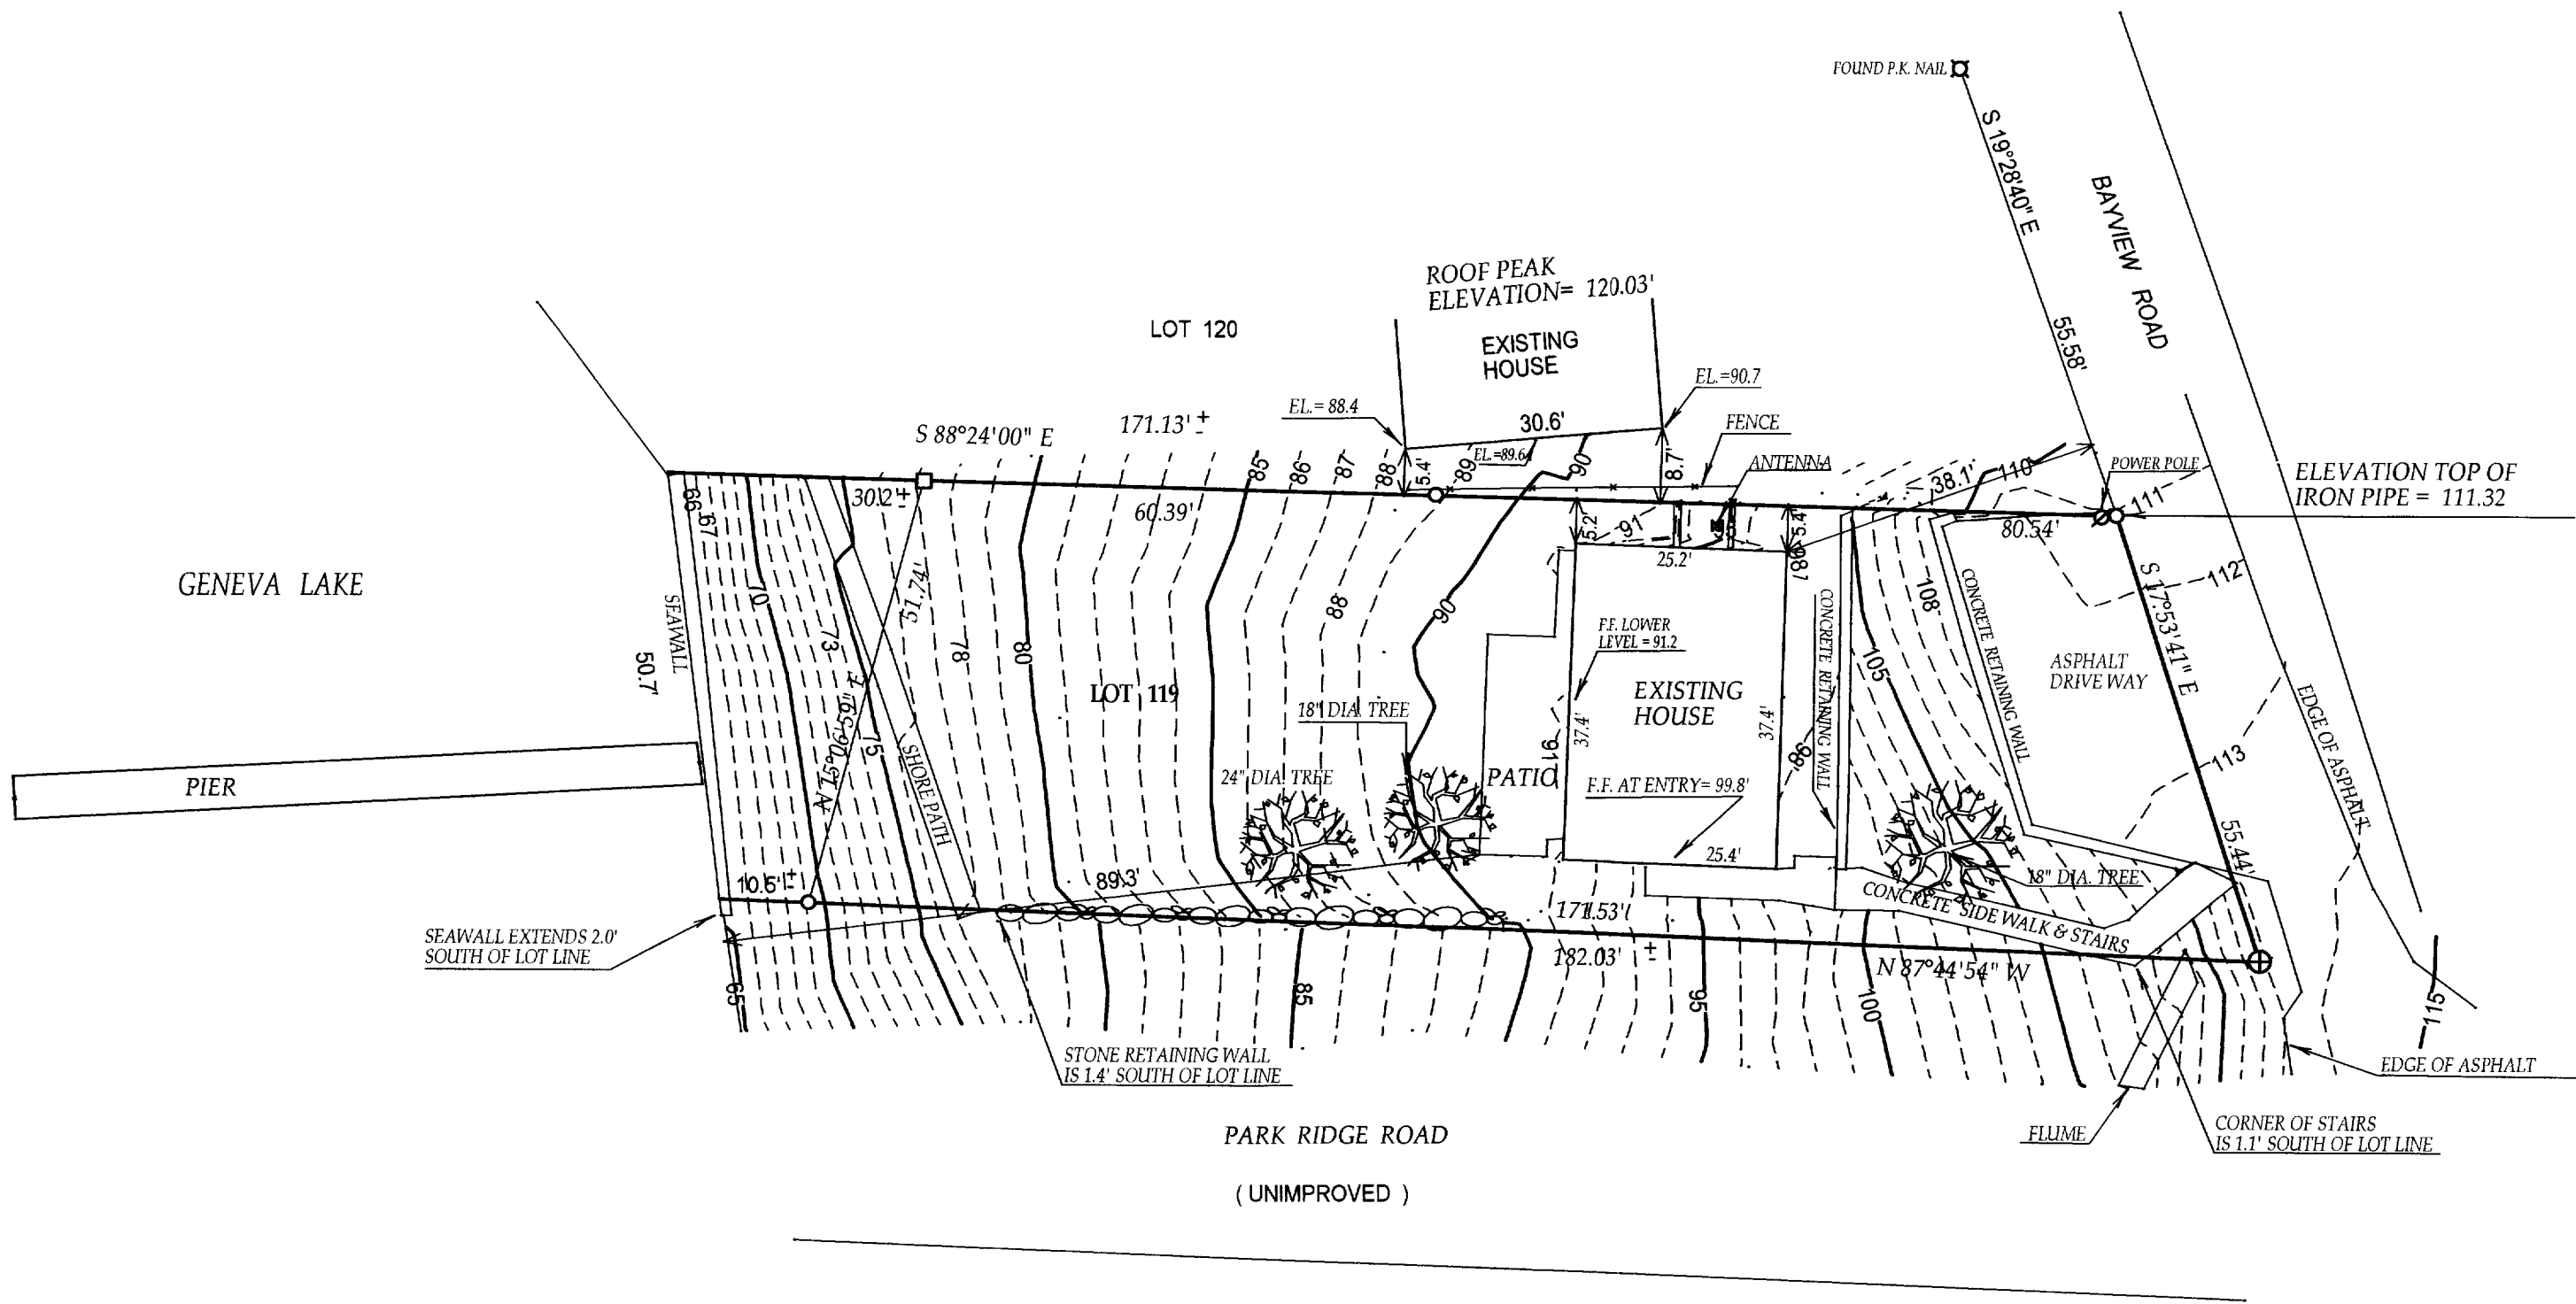

LEGEND

- () = recorded as
- = found iron bar
- = found iron pipe
- = set iron pipe
- = set iron bar

SCALE 1" = 20'


JOB # 03-460

TAX ID # WCP200017

COMPARE LEGAL DESCRIPTION ABOVE AND DRAWING WITH DEED. FOR BUILDING RESTRICTIONS AND
EASEMENTS NOT SHOWN, REFER TO DEED, ABSTRACT SOURCES AND LOCAL MUNICIPAL CODES. NOTIFY
THE SURVEYOR IMMEDIATELY OF ANY DISCREPANCY.

"I hereby certify that I have surveyed the above described property and that
the above map is a true representation thereof and shows the size and
location of all visible structures, apparent easements and encroachments
if any."
This survey is made for the present owners of the property, and those who
purchase, mortgage, or guarantee the title thereto, within one year from
the date hereof.

DATED THIS 7th, DAY OF AUGUST, 2003

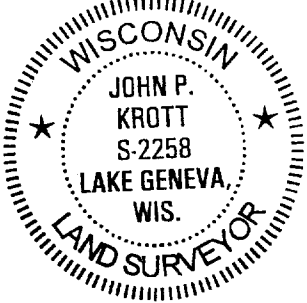

John P. Krott
JOHN KROTT S - 2258
Wisconsin Registered Land Surveyor
(original if signed in red)

011-1791