



PREPARED FOR: PETER CONNOLLY
 222 S. DERBYSHIRE LN.
 ARLINGTON HIGHTS IL. 60004

PLAT OF SURVEY

- OF -

LOT 52 OF THE FIRST ADDITION TO CEDAR POINT PARK, BEING
 A RESUBDIVISION OF THE EAST 1/2 OF THE FRACTIONAL 1/4
 SECTION 6, TOWN 2 NORTH, RANGE 17 EAST, IN THE VILLAGE
 OF WILLIAMS BAY, WALWORTH COUNTY, WISCONSIN.

J.K. SURVEYING INC.
 N3705 WILLOWBEND LANE
 LAKE GENEVA, WI, 53147
 262-248-3697

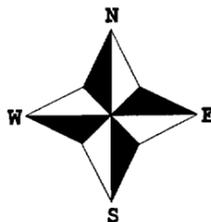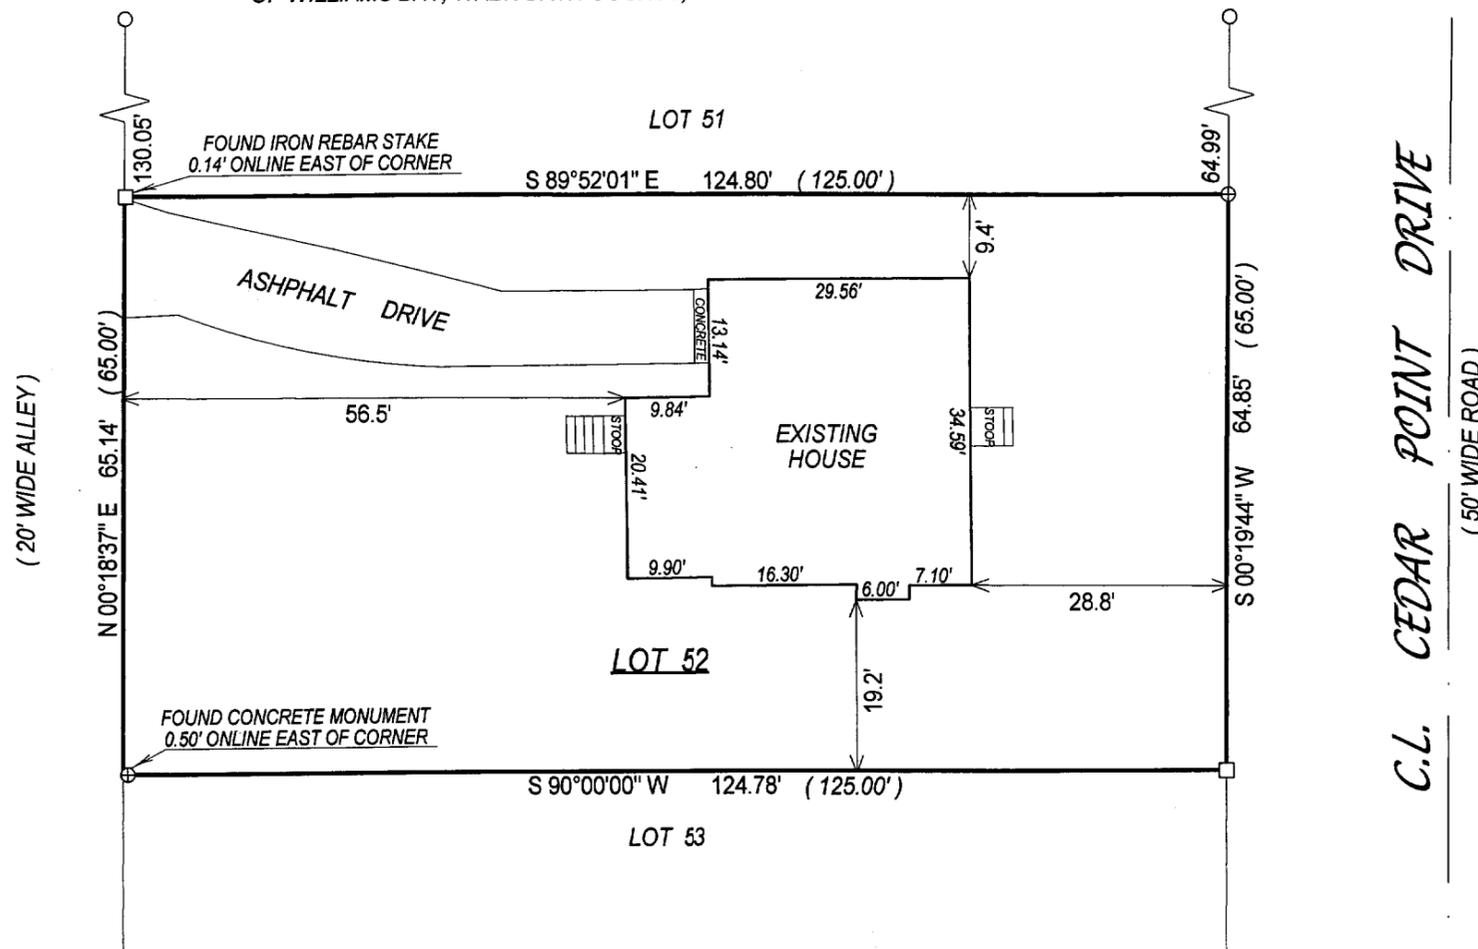

- () = recorded as
- = found iron bar
- = found iron pipe
- = set iron pipe
- = set iron bar

SCALE 1" = 20'



JOB # 04-003

TAX ID # WCP100048

COMPARE LEGAL DESCRIPTION ABOVE AND DRAWING WITH DEED. FOR BUILDING RESTRICTIONS AND EASEMENTS NOT SHOWN, REFER TO DEED, ABSTRACT SOURCES AND LOCAL MUNICIPAL CODES. NOTIFY THE SURVEYOR IMMEDIATELY OF ANY DISCREPANCY.

"I hereby certify that I have surveyed the above described property and that the above map is a true representation thereof and shows the size and location of all visible structures, apparent easements and encroachments if any."

This survey is made for the present owners of the property, and those who purchase, mortgage, or guarantee the title thereto, within one year from the date hereof.

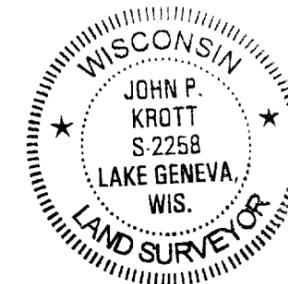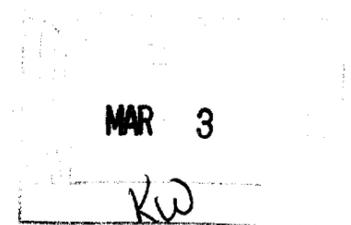

John P. Krott
 JOHN KROTT S - 2258
 Wisconsin Registered Land Surveyor
 (original if signed in red)

DATED THIS THE 7th DAY OF JANUARY 2004.

011-1814