

**ABERNATHY and ASSOCIATES**


Kenneth B. Abernathy Jr.

Wisconsin Registered Land Surveyor S-1594

W4056 BRAY RD.  
ELKHORN, WI. 53121  
PHONE: (262) 723-4260 (OFFICE)  
(262) 723-7209 (FAX)  
Email: abernathy@elknet.net


OWNERS: JOSEPH GIRALAMO JR. and GLORIA A. GIRALAMO  
915 ST. STEVENS GREEN  
OAKBROOK, IL. 60523

ORDERED BY: HUMMEL CONSTRUCTION

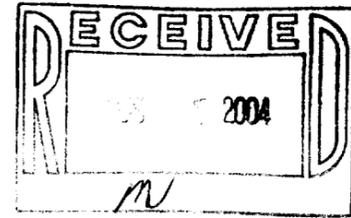

**PLAT OF SURVEY**


PART OF LOT 39 AND 40 OF LOCH VISTA CLUB SUBDIVISION LOCATED IN SOUTHEAST 1/4 OF SECTION 1, TOWN 1 NORTH, RANGE 16 EAST, VILLAGE OF WILLIAMS BAY, WALWORTH COUNTY, WISCONSIN.

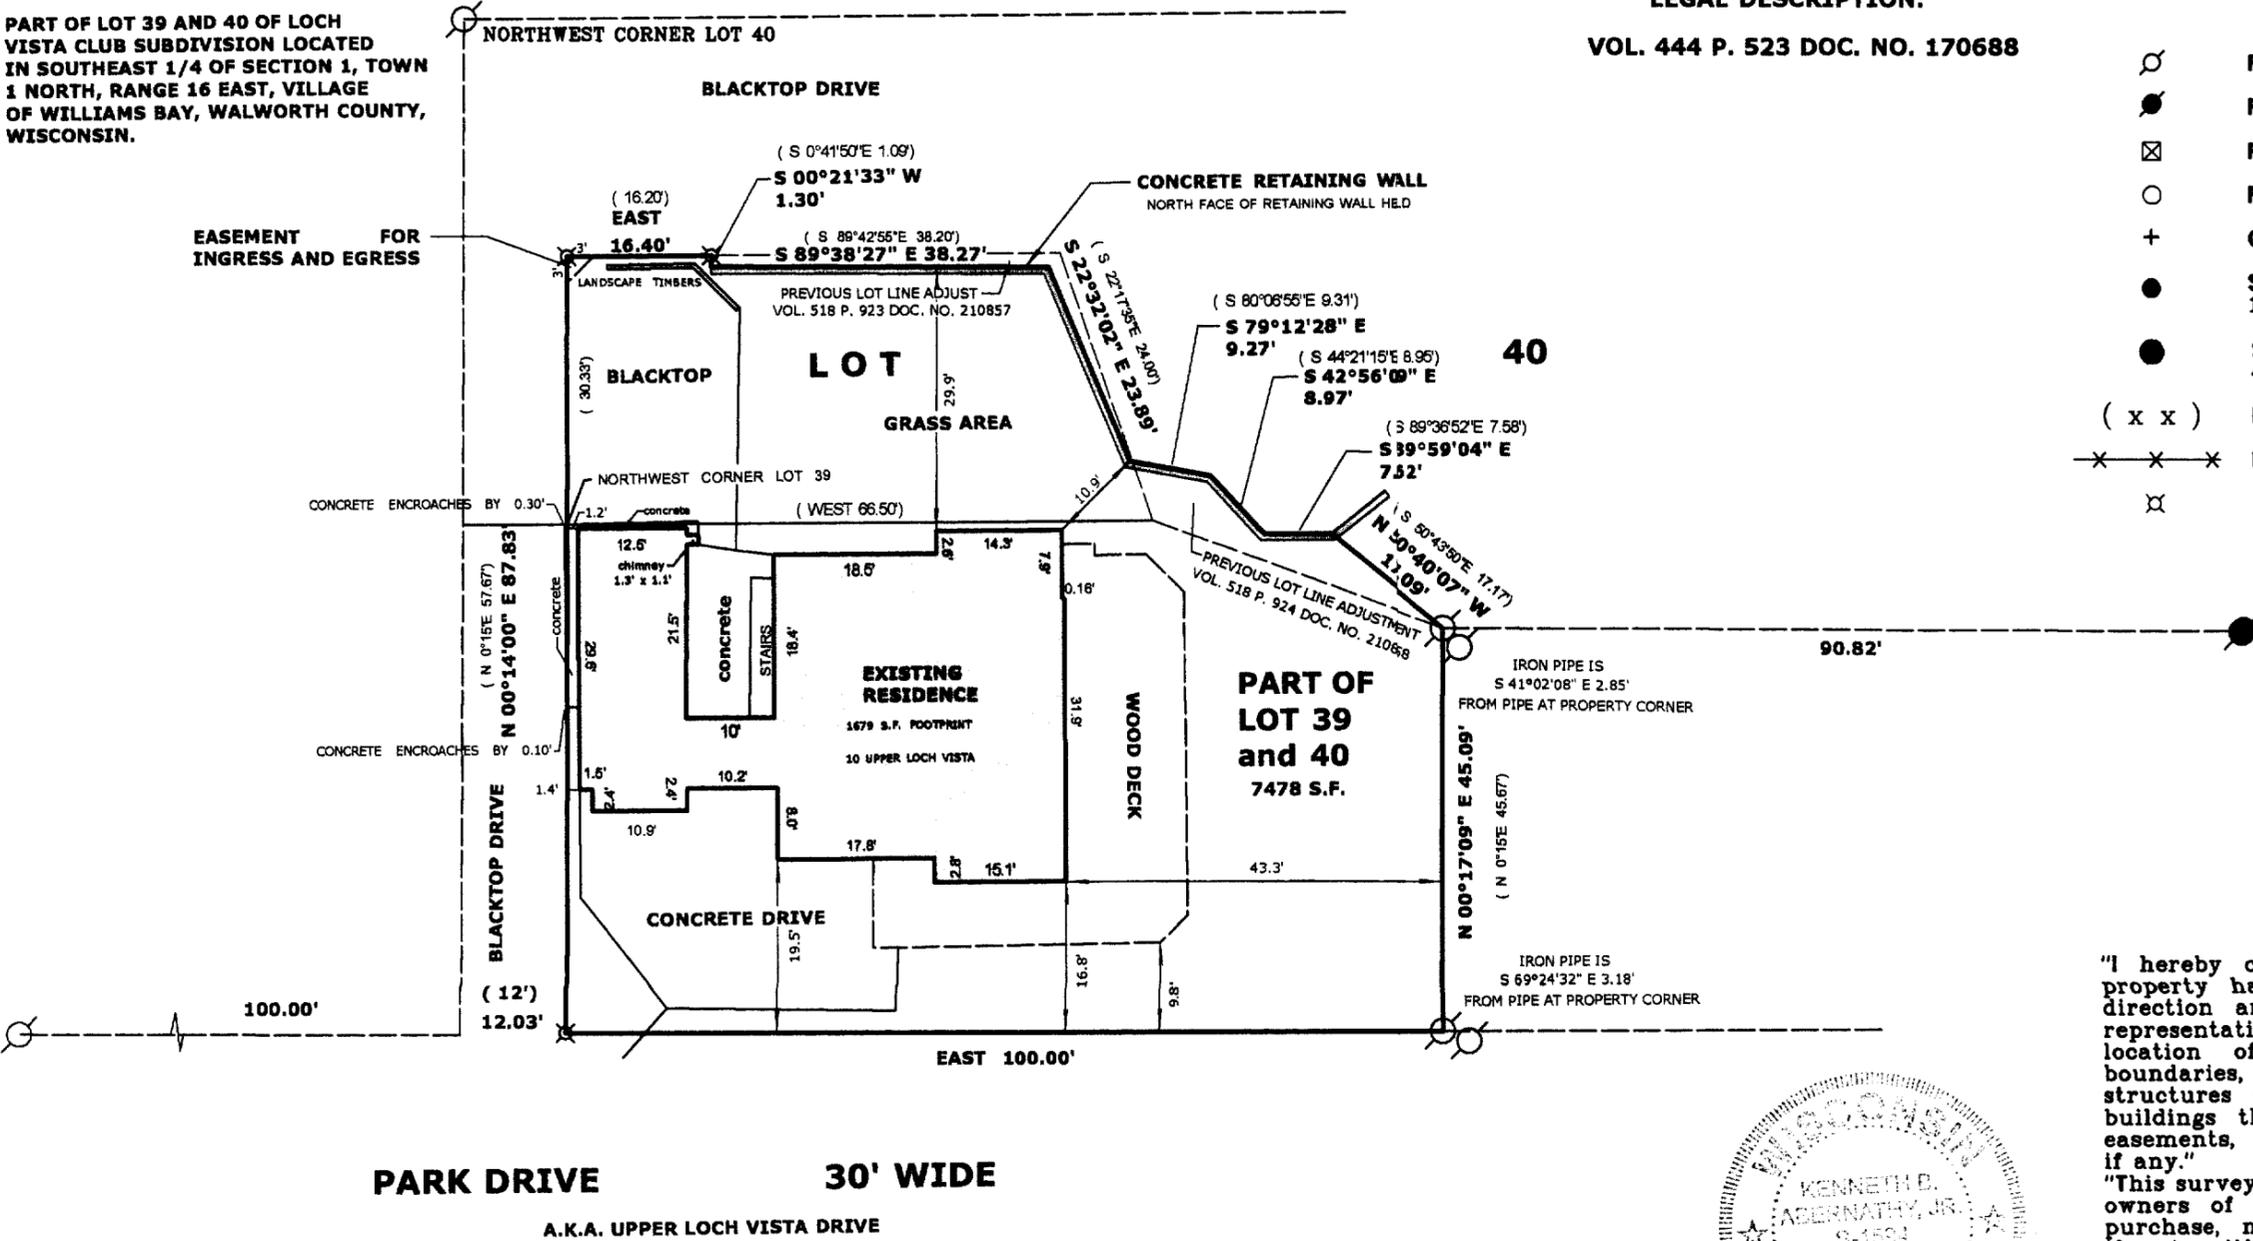

LEGAL DESCRIPTION:  
VOL. 444 P. 523 DOC. NO. 170688

**Legend**

- ⊗ FOUND IRON PIPE
- FOUND IRON ROD
- ⊠ FOUND BRASS CAPPED MONUMENT
- FOUND CONCRETE MONUMENT
- + CHISEL CUT IN CONCRETE
- SET IRON ROD, 24" LONG, WEIGHING 1.5 LBS./LINEAL FT., 3/4" DIA.
- SET IRON ROD, 30" LONG, WEIGHING 4.5 LBS./LINEAL FT., 1-11/16" DIA.
- ( X X ) RECORDED AS DIMENSION
- X — X — X EXISTING FENCE
- ⊗ P.K. NAIL SET

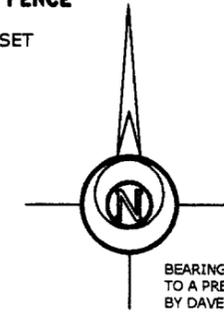

BEARINGS ARE REFERENCED TO A PREVIOUS SURVEY BY DAVE ABELL DATED JUNE 9, 1990

SCALE: 1" = 20 FEET

"I hereby certify that the above described property has been surveyed by me or under my direction and that the above map is a true representation thereof and shows the size and location of the property, its exterior boundaries, the location of all visible structures and dimensions of all principal buildings thereon, boundary fences, apparent easements, roadways and visible encroachments, if any."  
"This survey is made for the use of the present owners of the property, and also those who purchase, mortgage, or guarantee the title thereto within one year from the date hereof."



*Kenneth B. Abernathy, Jr.*  
KENNETH B. ABERNATHY, JR.  
WISCONSIN REGISTERED LAND SURVEYOR,  
S-1594  
Date: **MAY 11, 2004** Job No. **04.407**

WLV 00032

011-1829