
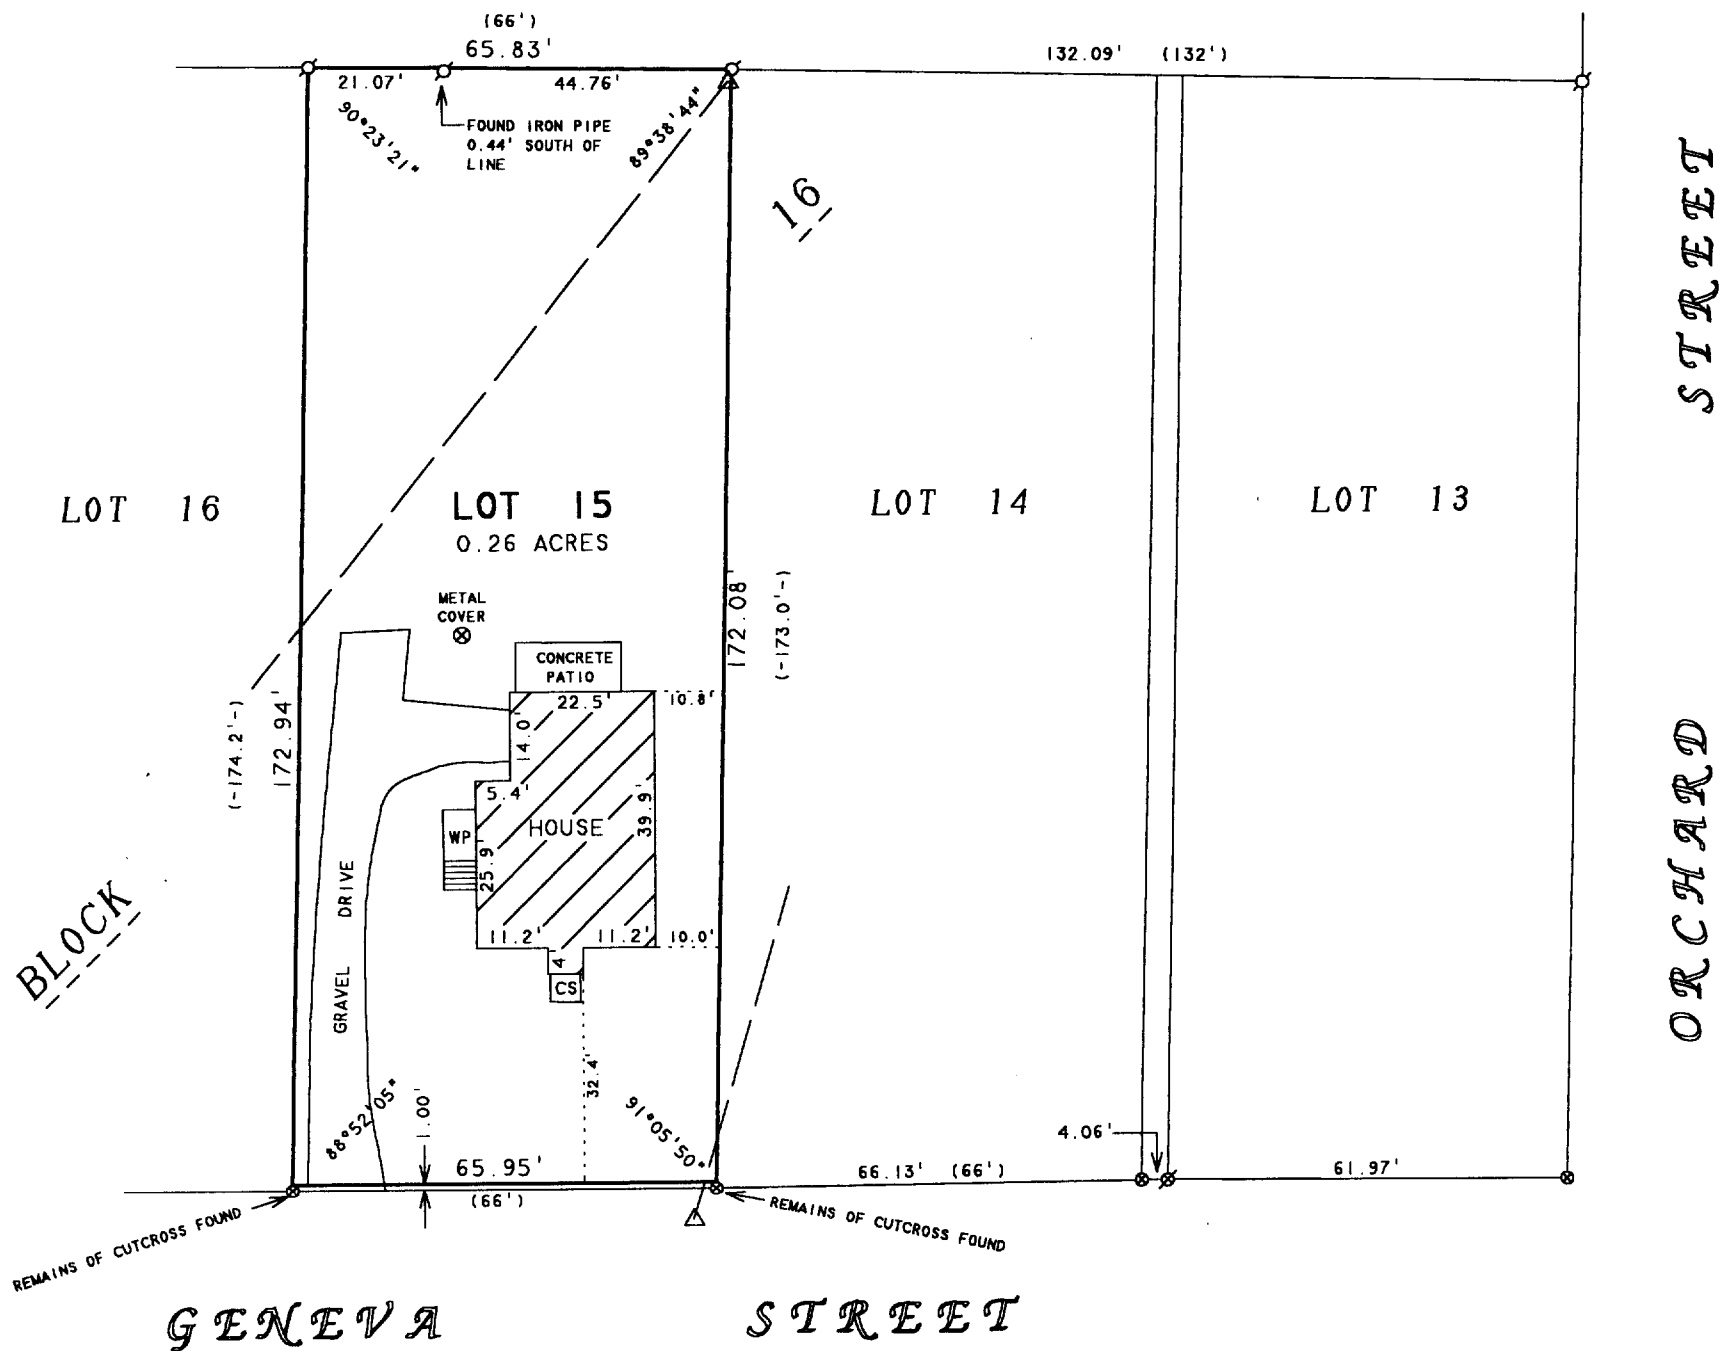


ABELL SURVEYING & MAPPING

1140 SEQUOIA STREET • DELAVAN, WISCONSIN 53115
262-728-6737

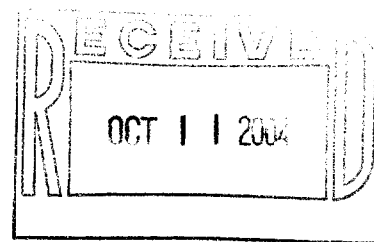

NOTE: THIS IS A RETRACEMENT OF A SURVEY BY
JAMES F. BIAGI DATED JULY 24, 1972.

PLAT OF SURVEY OF

LOT 15, BLOCK 16, WILLIAMS SECOND ADDITION TO THE VILLAGE
OF WILLIAMS BAY, WALWORTH COUNTY, WISCONSIN, EXCEPTING
THEREFROM THE SOUTH 1 FOOT OF LOT 15 IN BLOCK 16 OF
WILLIAMS SECOND ADDITION, CONVEYED TO THE VILLAGE OF
WILLIAMS BAY.

ORDERED BY: RASMUSSEN LAW OFFICE
113 KENOSHA STREET
WALWORTH, WI 53184

N



SCALE 1" = 30'

LEGEND

- ⊙ - IRON PIPE FOUND
- ⊗ - CUTCROSS IN CONCRETE FOUND
- ⊗ - PK NAIL FOUND
- △ - UTILITY POLE
- - OVERHEAD UTILITY LINES
- CS - CONCRETE STOOP
- WP - WOOD PORCH
- () - RECORDED AS

I HEREBY CERTIFY THAT I HAVE SURVEYED THE ABOVE DESCRIBED PROPERTY AND THAT THE
ABOVE MAP IS A TRUE REPRESENTATION THEREOF AND SHOWS THE SIZE AND LOCATION OF
THE PROPERTY, ITS EXTERIOR BOUNDARIES, THE LOCATION OF ALL VISIBLE STRUCTURES
AND DIMENSIONS OF ALL PRINCIPAL BUILDINGS THEREON, BOUNDARY FENCES, APPARENT
EASEMENTS, ROADWAYS AND VISIBLE ENCROACHMENTS, IF ANY, TO THE BEST OF MY
KNOWLEDGE AND BELIEF.

THIS SURVEY IS MADE FOR THE USE OF THE PRESENT OWNERS OF THE PROPERTY, AND ALSO
THOSE WHO PURCHASE, MORTGAGE, OR GUARANTEE THE TITLE THERETO WITHIN ONE (1) YEAR
FROM DATE HEREON.

David F. Abell

DAVID F. ABELL
WISCONSIN REGISTERED LAND SURVEYOR, S-1596

September 8, 2004

DATE JOB NUMBER - 04107
NOTE: THIS IS NOT A CERTIFIED COPY UNLESS SEALED.

WOP 00229

011-1851