


PLAT OF SURVEY

OF

LOT 12 OF

WILLIAM H. FRANCIS SUBDIVISION

WILLIAMS BAY, WISCONSIN

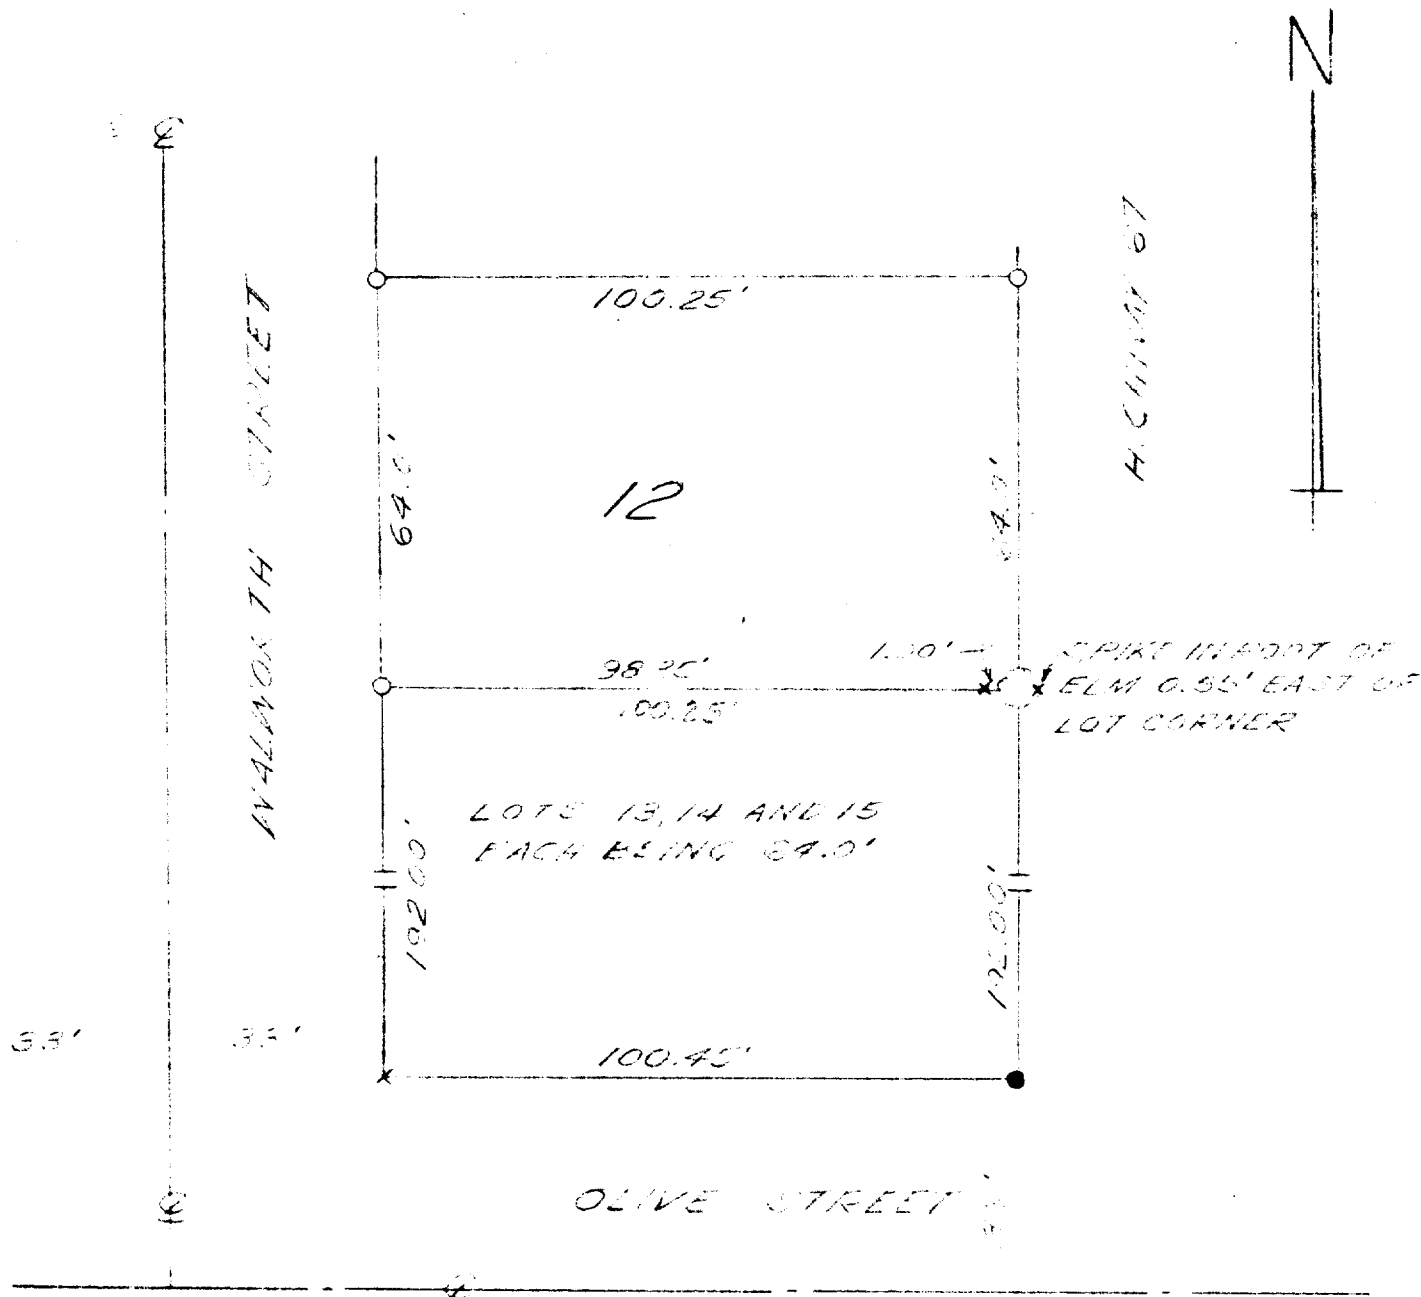

SURVEY AND PLAT BY

JENSEN & JOHNSON

CIVIL ENGINEERS AND SURVEYORS

Elkhorn, Wisconsin

LEGEND

- O — Iron Pipe
- — Concrete Monument
- Scale 1" = 30'
- X = SPIKE

WE CERTIFY: That we have surveyed the above described property and that the plat shown hereon is an accurate survey and a true representation thereof and correctly shows the exterior boundary lines and all divisions of said property.

Date MARCH 30, 1962

LLOYD L. JENSEN, Partner

Wisconsin Registered Land Surveyor, No. S-211

WFS-6