



Plat of Survey

of



Lot 8 of Jewell's Subdivision,

located in the Southeast 1/4 of Section 1, Town
1 North, Range 16 East, Village of Williams Bay,
Walworth County, Wisconsin.

Surveyed for: **Century 21 Affiliated**
50 West Geneva Street * P.O. Box 387
Williams Bay, Wisconsin. 53191

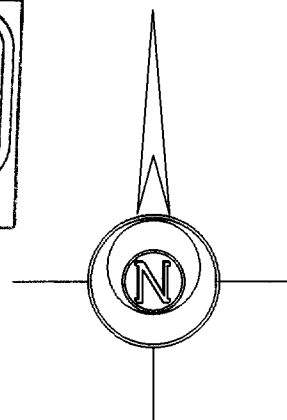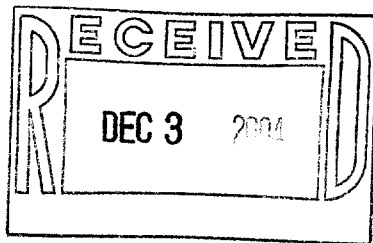

Bearings reference to previous
surveys of record.

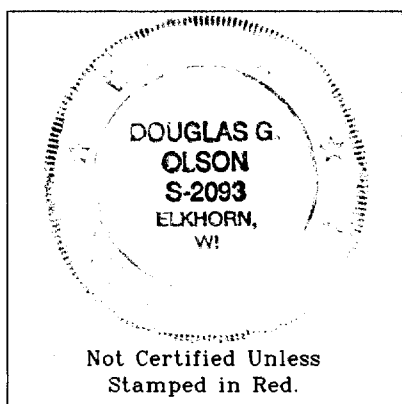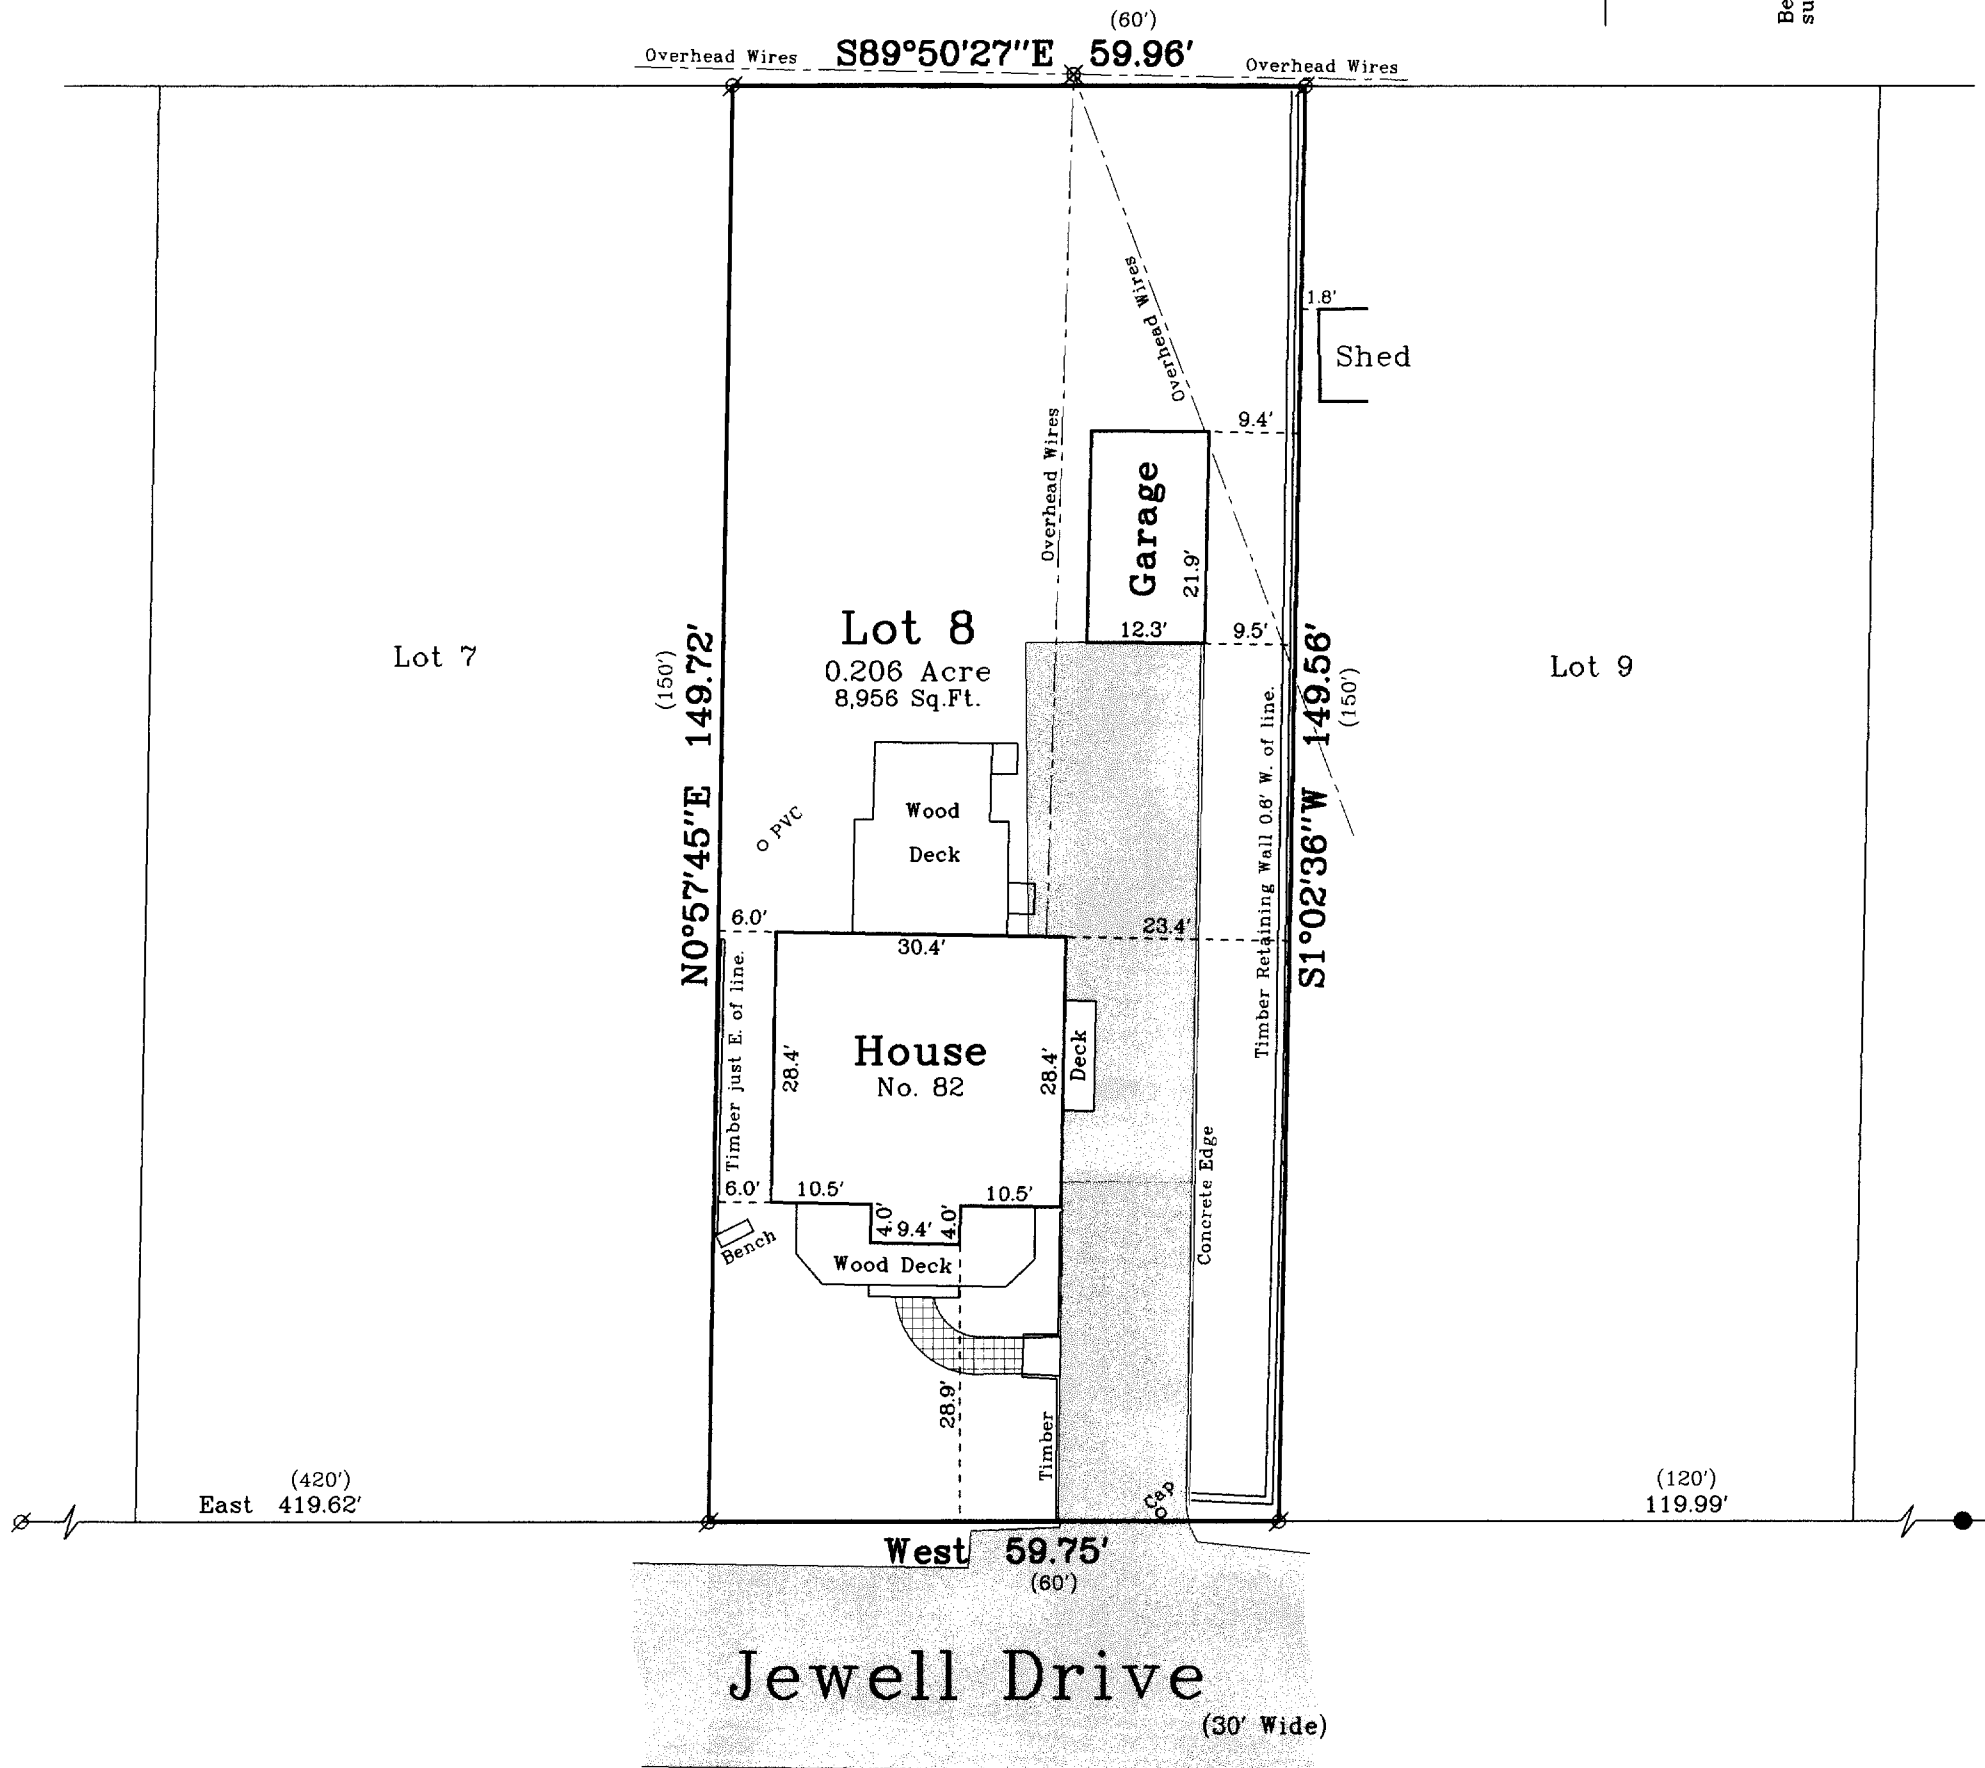

Copyright c 2004 by Jensen & Olson Land Surveying, LLC.

All rights reserved. No part of this survey plat may be reproduced or transmitted in any form by any means - graphic, electronic, or mechanical, including photocopying, tracing, or information storage and retrieval systems - without permission in writing from Douglas G. Olson, Jensen & Olson Land Surveying, LLC.

I hereby certify that I have surveyed the above described property and the map hereon is correct to the best of my professional knowledge and belief and shows the size and location of the property, its exterior boundaries, the location and dimensions of all visible structures thereon, boundary fences, apparent easements and roadways and visible encroachments, if any.

This survey is made for the exclusive use of the present owners of property, and also those who purchase, mortgage or guarantee title thereto, within one year from the date hereof.

Douglas G. Olson
Wisconsin Registered Land Surveyor - 2093

Notes:

- 1) This survey plat is not certified unless signed and sealed in red ink.
- 2) This survey is subject to Wisconsin lien laws. This Plat of Survey is the notice of intent to file lien. Lien waiver required.

Legend

- Ø Found Iron Pipe
- Found Iron Rod
- () Recorded Information
- ⊗ Utility Pole
- ▨ Asphalt Surface
- ▧ Brick Walk

Jensen & Olson Land Surveying, LLC

45 South Wisconsin Street P.O. Box 322
Elkhorn, Wisconsin. 53121
Telephone: (262) 723-3434
Facsimile: (262) 723-8044

Scale: 1" = 20'



Survey date: October 11, 2004.

Revisions:

Sheet 1 of 1 Sheets.

Job Reference Number:

WJ-7

011-1863 2004.158