

PLAT OF SURVEY **-OF-**

LOT 101 IN BLOCK 1 IN LAKEWOOD TRAILS NORTH SUBDIVISION, LOCATED IN THE NORTHWEST 1/4 AND THE NORTHEAST 1/4 OF THE NORTHWEST 1/4 OF SECTION 1, IN TOWNSHIP 1 NORTH, RANGE 16 EAST, IN THE VILLAGE OF WILLIAMS BAY, COUNTY OF WALWORTH, STATE OF WISCONSIN.

SURVEY FOR: PLAN IT DESIGN
 SURVEY LOCATION: 428 FAIR OAKS DRIVE


SCALE: 1" = 30'

LEGEND
 ○ FOUND IRON ROD
 ● SET IRON PIPE
 1021.0 EXISTING ELEVATION

CURVE DATA
 CENTRAL ANGLE = 15°42'37"
 RADIUS = 193.00'
 CHORD = 52.75'
 CHORD BEARING = S02°50'38.5"E

"I hereby certify that I have surveyed the above described property and that the above map is a correct representation thereof and shows the size and location of the property, its exterior boundaries, the location of all visible structures and dimensions of all principal buildings thereon, boundary fences, apparent easements, roadways and encroachments, if any."

"This survey is made for the use of the present owners of the property, and those who purchase, mortgage, or guarantee the title thereto within one year from date hereof."



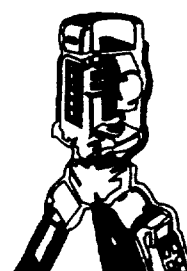


B.W. SURVEYING, INC.

LAND SURVEYS
 MAPPING AND PLANNING
 412 N. PINE STREET
 BURLINGTON, WI 53105
 (262)-767-0225

I HEREBY CERTIFY THAT THE EXISTING FOUNDATION SHOWN ON THIS PLAT OF SURVEY IS LOCATED AS SHOWN THUS (), DATED THIS 22ND DAY OF SEPTEMBER, 2004.

Robert J. Wetzel
 ROBERT J. WETZEL S-1778

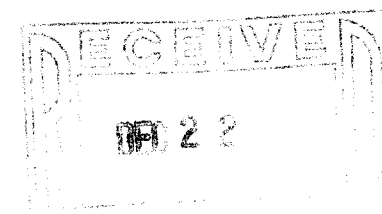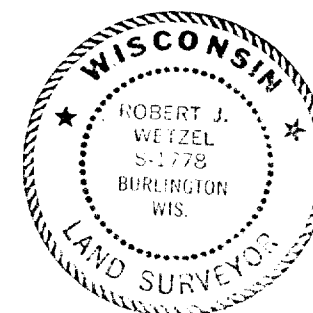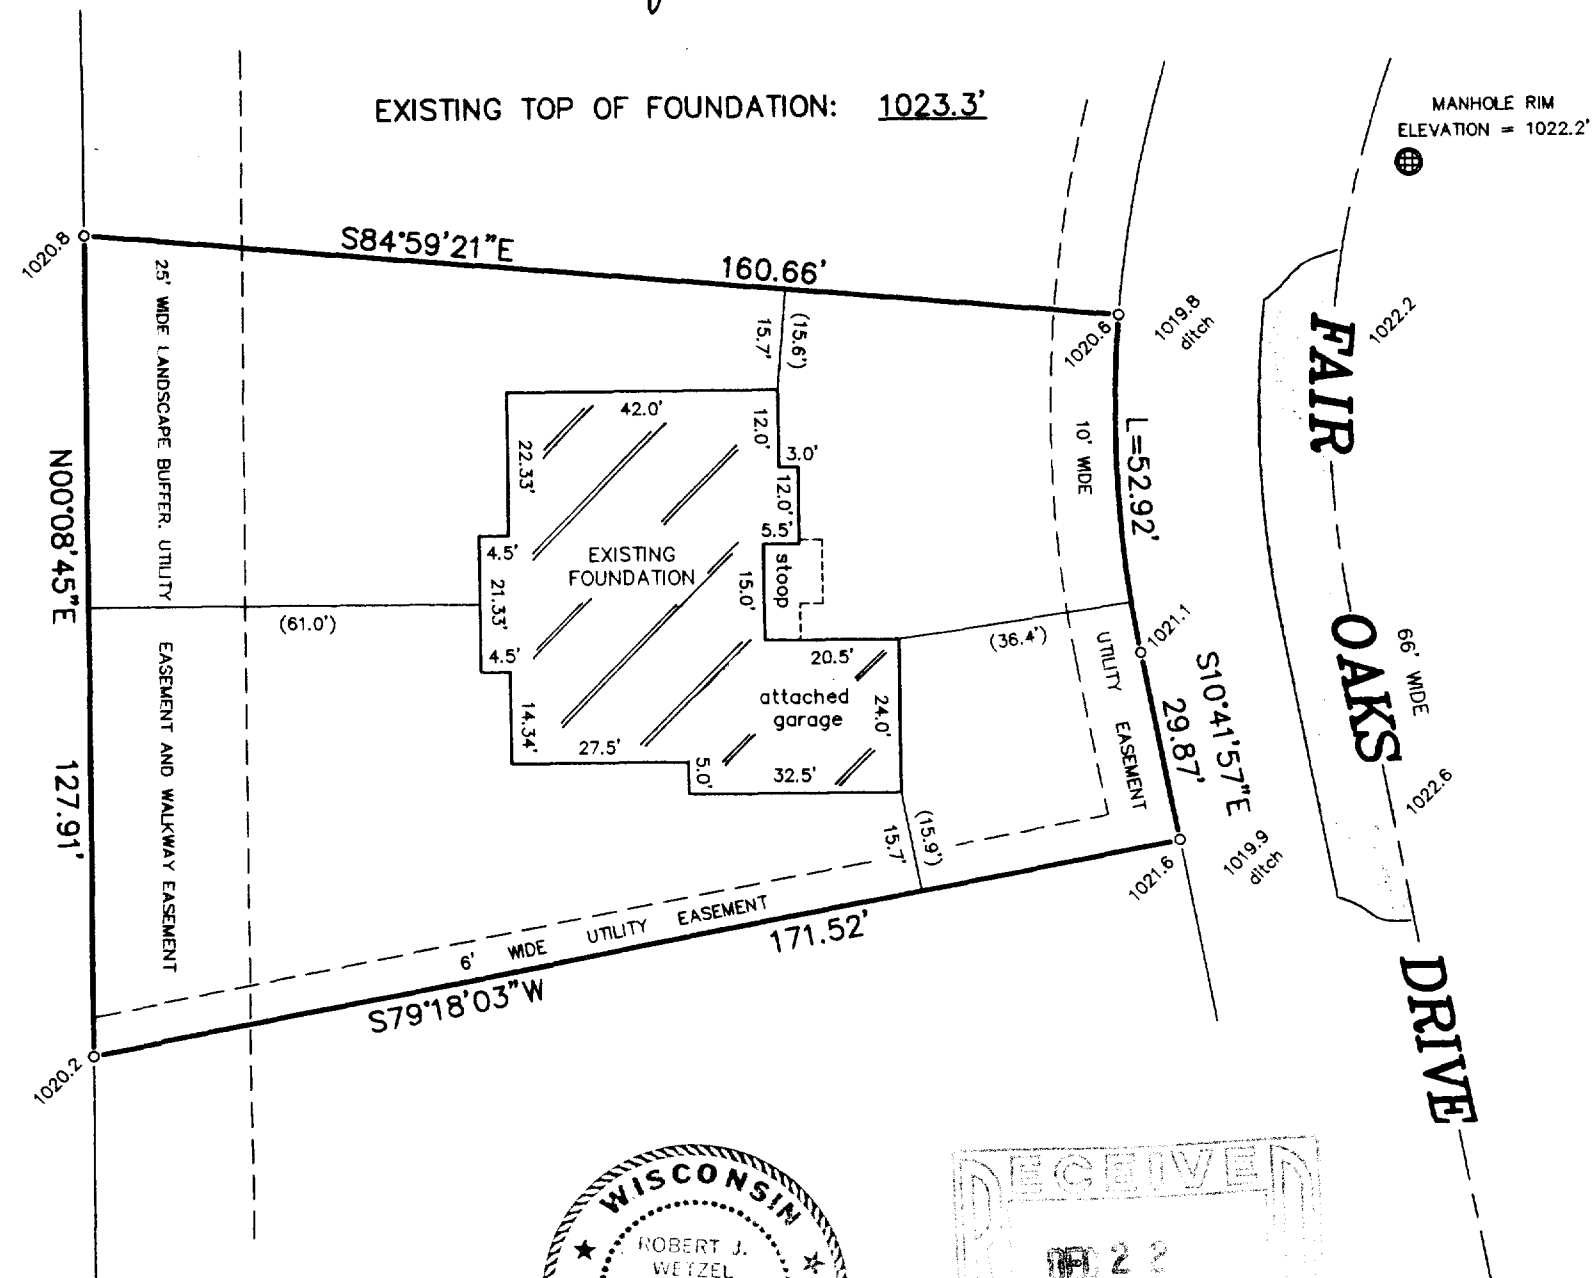

Robert J. Wetzel
 ROBERT J. WETZEL S-1778

THIS IS NOT AN ORIGINAL PRINT
 UNLESS THIS SEAL IS RED.

AUGUST 30, 2004
 DATE

6376
 JOB NUMBER

WLAKN-1

011-1866