


PLAT OF SURVEY

OF

LOT 188 OF CEDAR POINT PARK
2ND ADDITION TO WILLIAMS BAY,
WISCONSIN

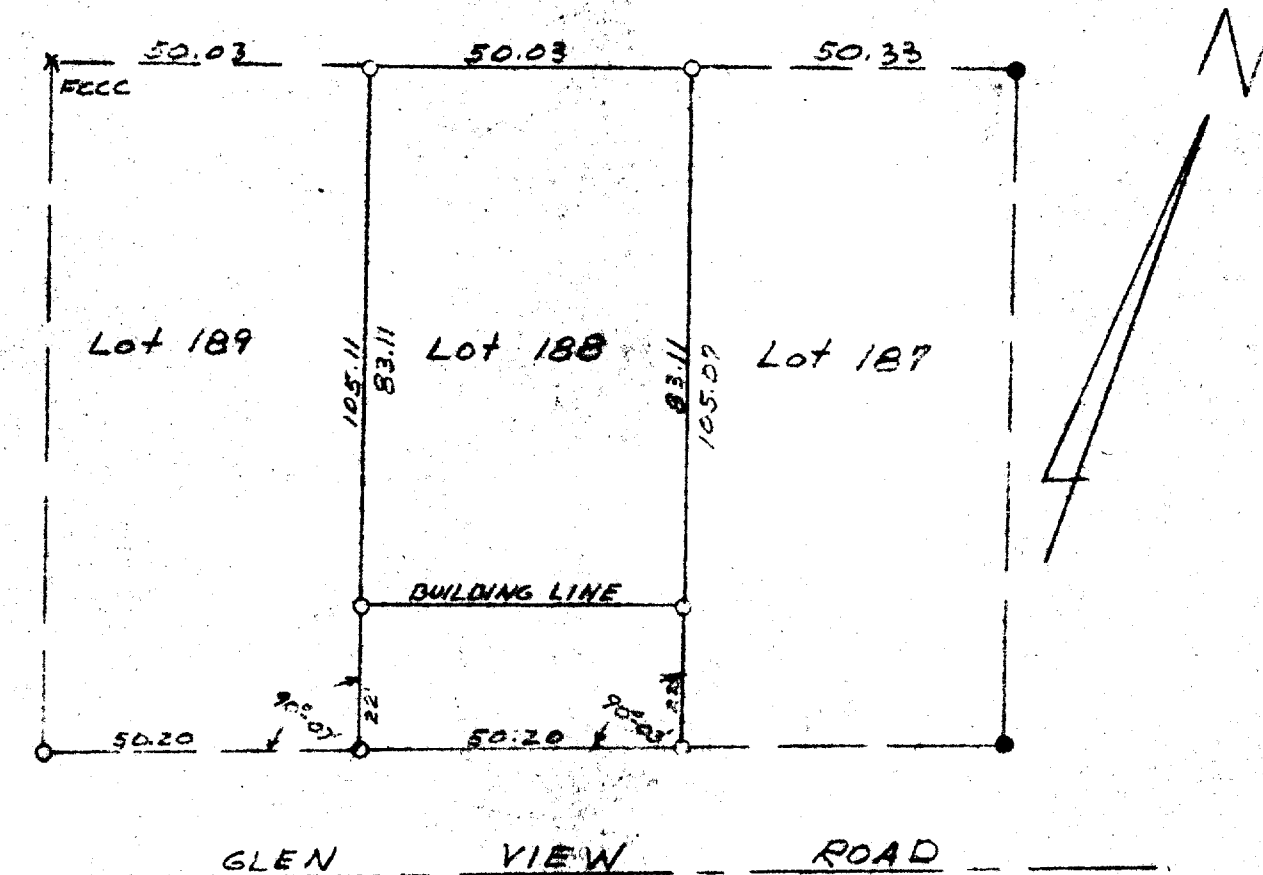

SURVEY AND PLAT BY
JENSEN & JOHNSON
CIVIL ENGINEERS AND SURVEYORS

Elkhorn, Wisconsin

LEGEND

- — Iron Pipe
 - — Concrete Monument
- Scale 1" = 30'

WE CERTIFY: That we have surveyed the above described property and that the plat shown herein is an accurate survey and a true representation thereof and correctly shows the exterior boundary lines and all divisions of said property.

Date SEPT. 1903

Lloyd L. Jensen
LOYD L. JENSEN, Partner

Wisconsin Registered Land Surveyor, No. 8-211

WCP2-78

11-186