


PLAT OF SURVEY

OF

LOTS 230, 231 &
232 OF THE 3RD
ADDITION TO
CEDAR POINT
PARK OF WD
BAY, WISCONSIN

CIRCLE PARKWAY

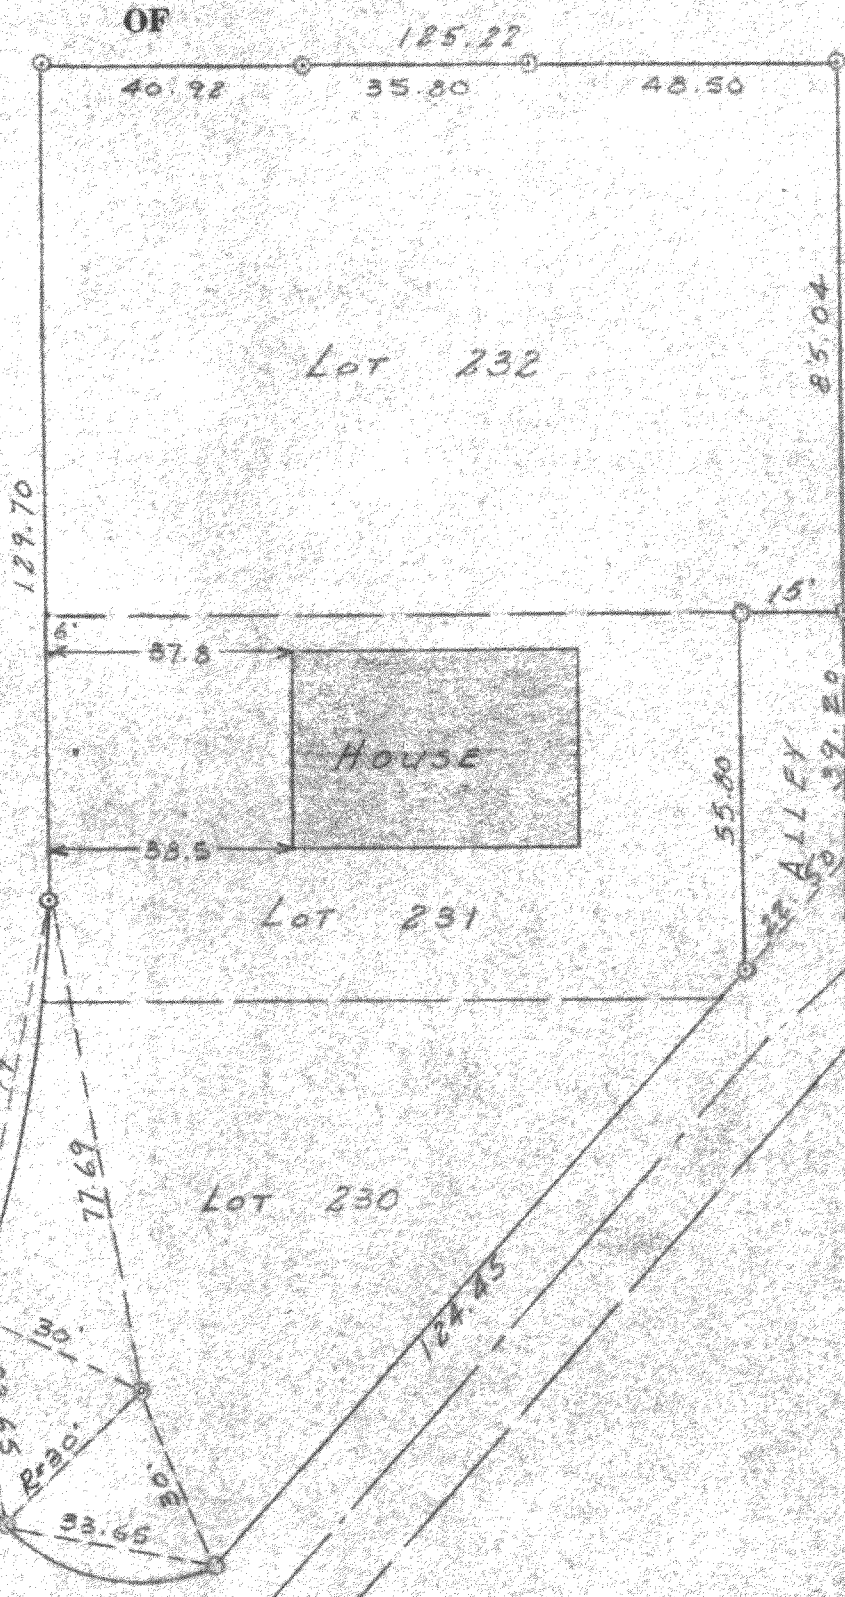

SURVEY AND PLAT BY

JENSEN & JOHNSON
CIVIL ENGINEERS AND SURVEYORS

Elkhorn, Wisconsin

LEGEND

- — Iron Pipe
 - — Concrete Monument
- Scale 1" = 40'

WE CERTIFY: That we have surveyed the above described property and that the plat shown hereon is an accurate survey and a true representation thereof and correctly shows the exterior boundary lines and all divisions of said property.

Date SEPT. 1963

Lloyd L. Jensen
LLOYD L. JENSEN, Partner

Wisconsin Registered Land Surveyor, No. S-211

11-187

11-187