


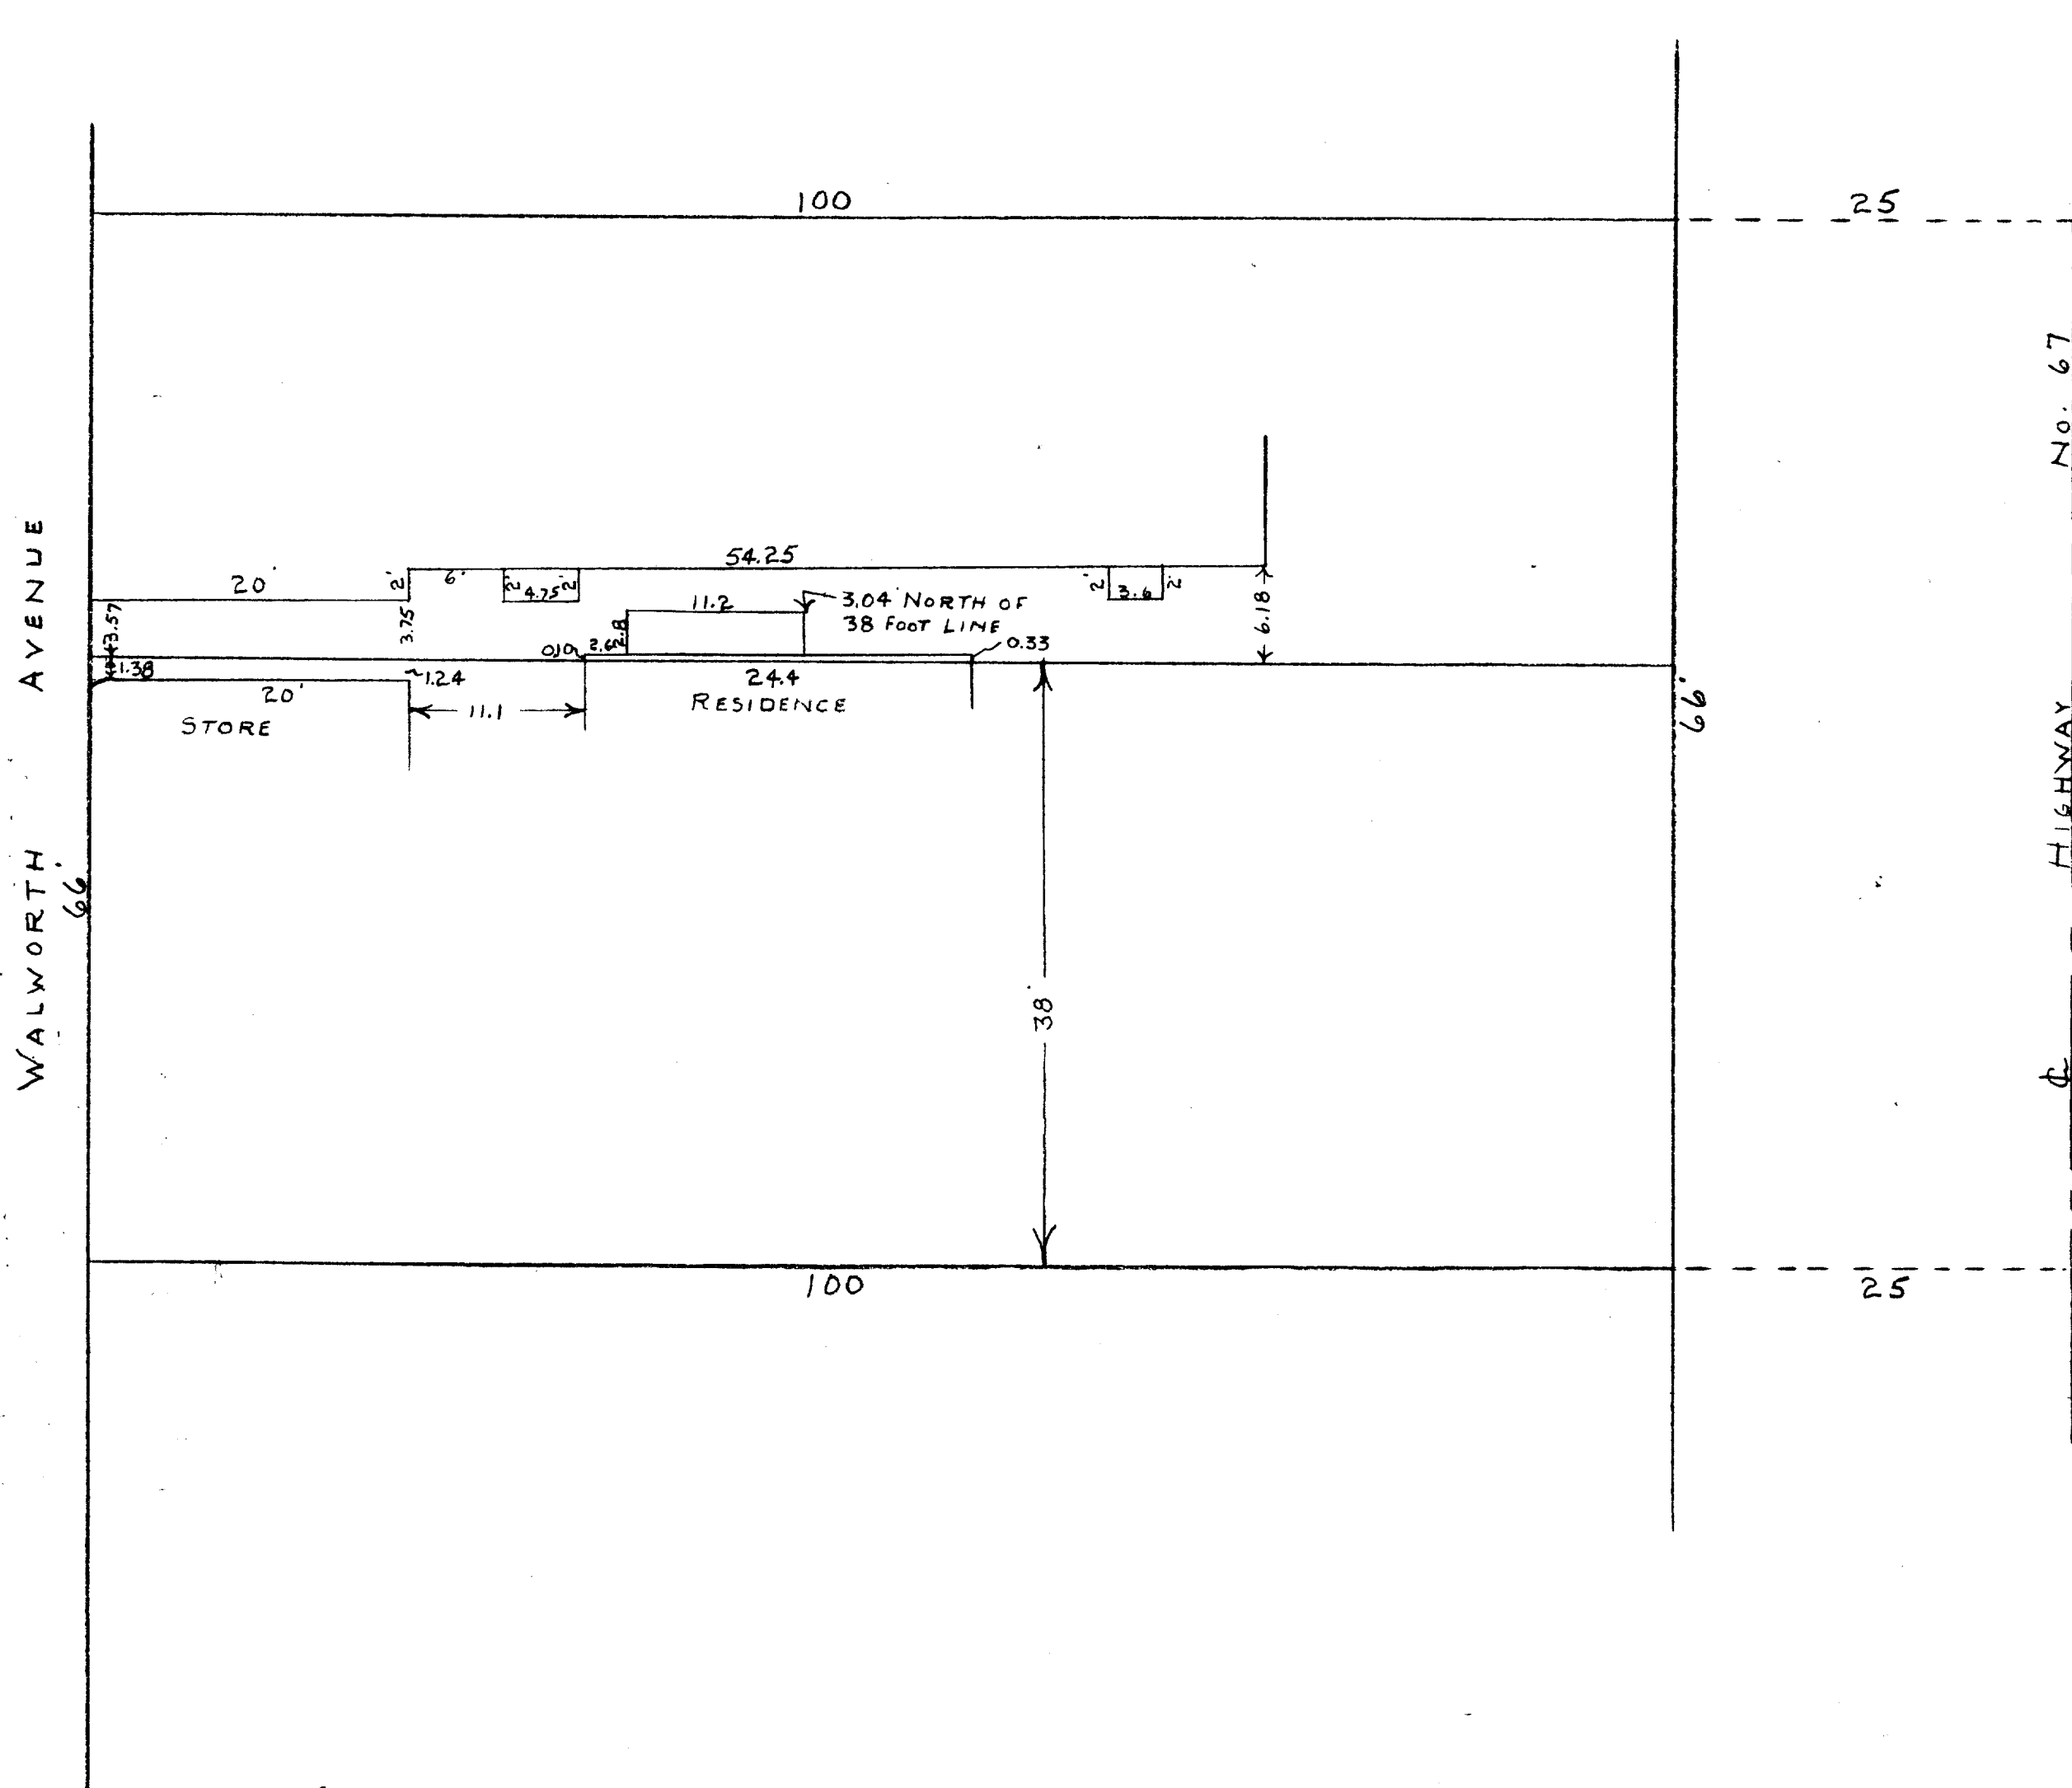

SKETCH SHOWING THE BUILDING LOCATION IN RELATION TO A LINE DRAWN
 PARALLEL TO AND 38 FEET NORTH OF THE SOUTH LINE OF LOT 7,
 BLOCK 1, ORIGINAL TOWN, WILLIAMS BAY, WISCONSIN
 DEC, 1955

George T. Dunham
 GEORGE T. DUNHAM, SURVEYOR
 DELAVAN, WISCONSIN