


OF

CHERRY ST.

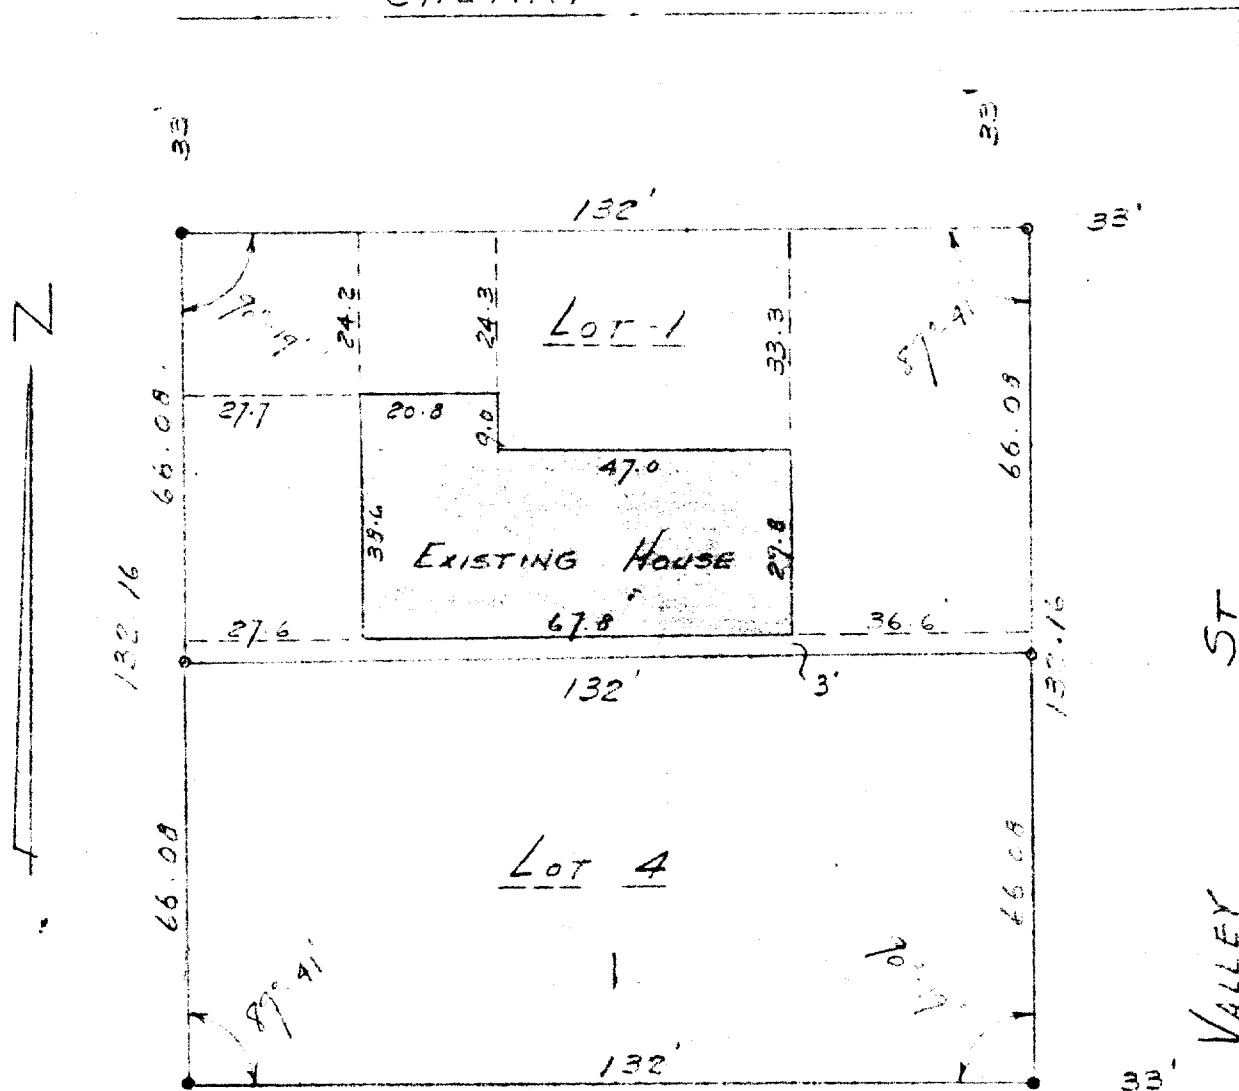

Elkhorn, Wisconsin

LEGEND

- — Iron Pipe
● — Concrete Monument
Scale 1" = 30'

WE CERTIFY: That we have surveyed the above described property and that the plat shown hereon is an accurate survey and a true representation thereof and correctly shows the exterior boundary lines and all divisions of said property.

Date Oct. 1964

Lloyd L Jensen
LLOYD L JENSEN, Partner

Wisconsin Registered Land Surveyor, No. S-211

11-1907