


denotes iron pipe

project BENCHMARK - paint spot
in center of pavement = 1017.30



Scale
1" = 30'

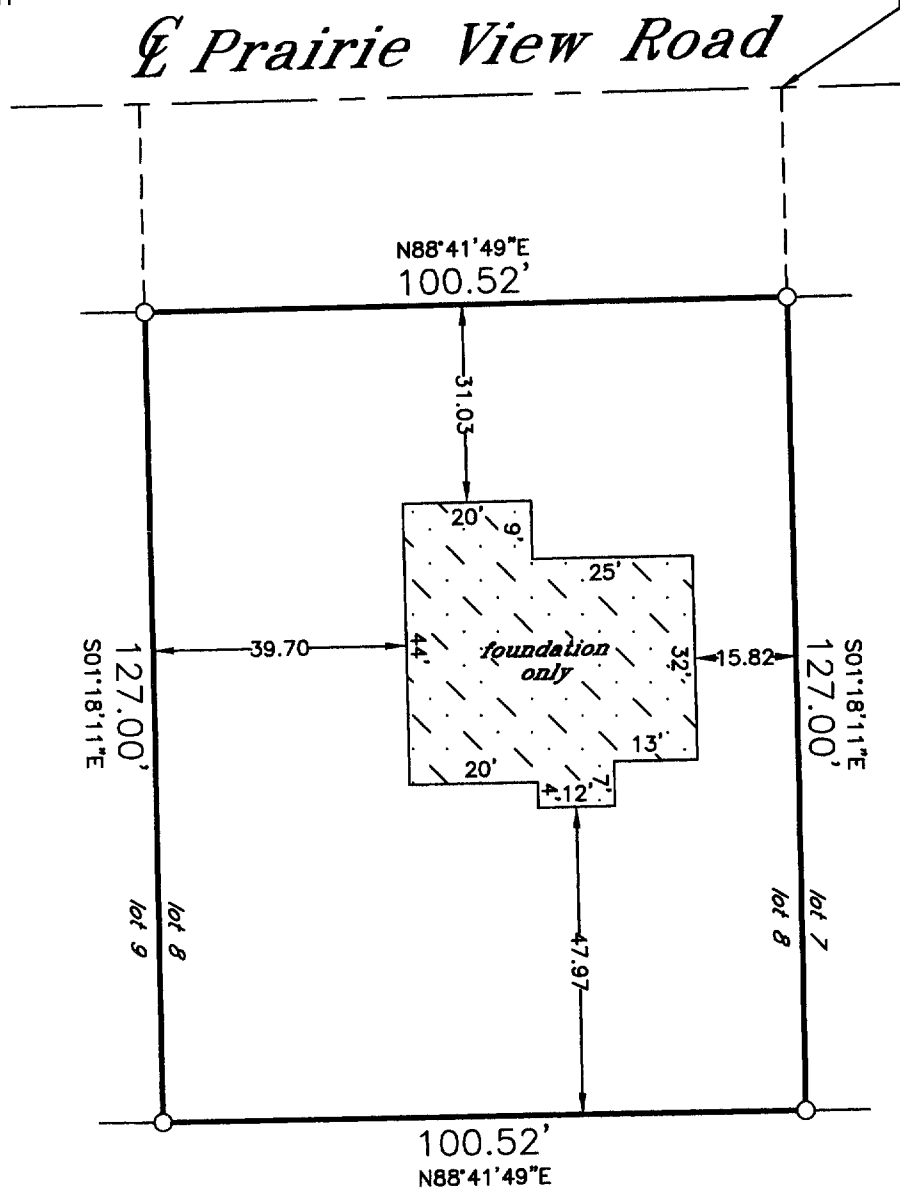

top of foundation
elevation = 1019.71

* outside finish grade = EL 1018.70
(advisory only) - top of foundation = EL 1019.45 (advisory only) unless otherwise determined in writing by Village Engineering Department

* Verify exact number with Village Engineering Department

Proposed building field staked true size. Contractor to verify all dimensions before building by same and adhere to drainage plan in effect for this subdivision. Refer to a current title report for easements or restrictions which may affect the use of this site that are not shown on the recorded subdivision plat.

J.K.R. SURVEYING, INC.
8121 22ND AVENUE
KENOSHA, WI 53143




I hereby certify that this property was surveyed under my direction and this plat is a true representation thereof.

[Signature]

Reg. Land Surveyor
February 11, 2005
Revised 3/8/05
March 15, 2005
Revised 4/29/05

Plat of Survey of
LOT 8 BLOCK 1 IN
PRAIRIE VIEW
in NE1/4 Section 2-1-16
VILLAGE OF WILLIAMS BAY
WALWORTH COUNTY, WIS.

-for-
James Construction

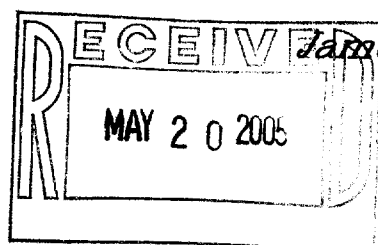

WPU 00008

011-1915