


denotes iron pipe

* Verify exact number with Village Building Inspector

Scale
1" = 40'

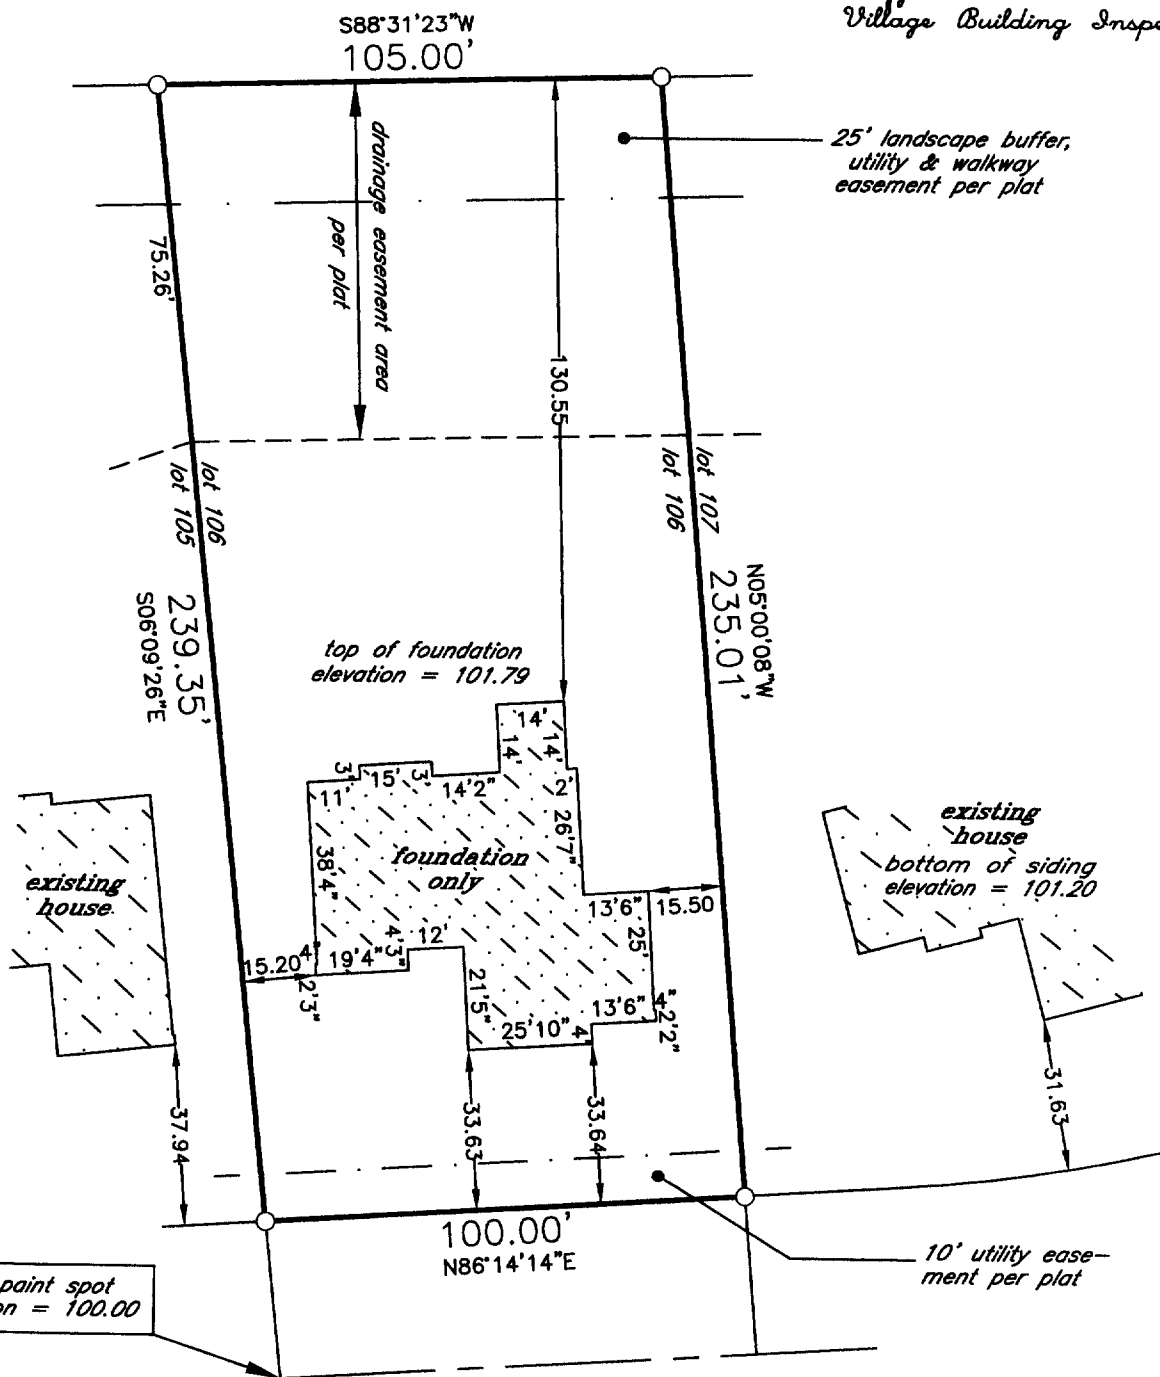

℄ Fair Oaks Drive

* outside finish grade = EL 101.00 (advisory only) - top of foundation = EL 101.67 (advisory only) unless otherwise determined in writing by Village Building Inspector

Proposed building field staked true size. Contractor to verify all dimensions before building by same and adhere to drainage plan in effect for this subdivision. Refer to a current title report for easements or restrictions which may affect the use of this site that are not shown on the recorded subdivision plat.

J.K.R. SURVEYING, INC.
8121 22ND AVENUE
KENOSHA, WI 53143



I hereby certify that this property was surveyed under my direction and this plat is a true representation thereof.


[Signature]

Reg. Land Surveyor

April 20, 2005
Revised 6/14/05

Plat of Survey of
LOT 106 BLOCK 1 IN
LAKEWODD TRAILS NORTH SUBDIVISION
in NW1/4 Section 1-1-16
VILLAGE OF WILLIAMS BAY
WALWORTH COUNTY, WIS.

-for-
Maerzke Bros., Inc.

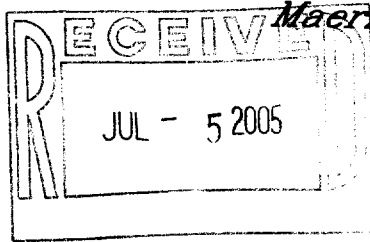

011-1924

WLAKN 00006