


PLAT OF SURVEY

OF

LOT 119, PLAT OF THE ORIGINAL CEDAR
POINT PARK SUBDIVISION, LOCATED IN
SECTION 6, T 1 N R 17 E, VILLAGE OF
WILLIAMS BAY, WALWORTH COUNTY WISCONSIN.

CLEVELAND PARKWAY
50.00' WIDE

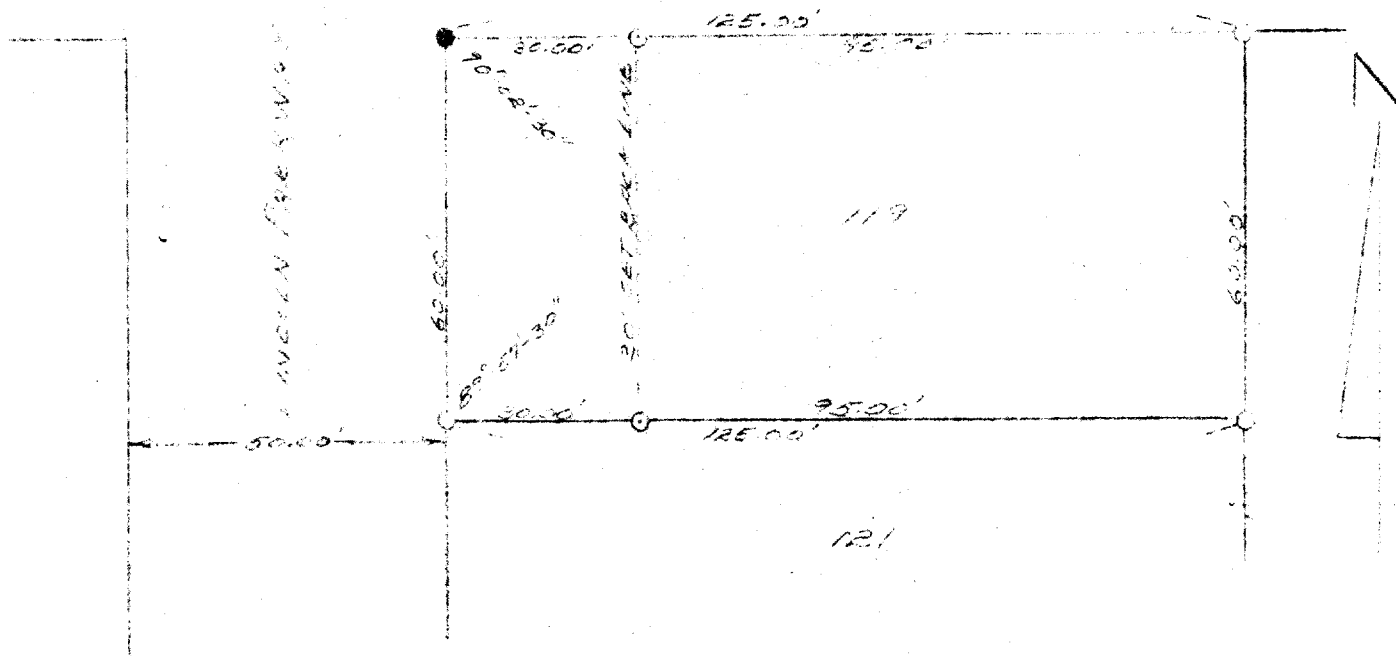

SURVEY AND PLAT BY

JENSEN & JOHNSON
CIVIL ENGINEERS AND SURVEYORS

Elkhorn, Wisconsin

LEGEND

- O — Iron Pipe
 - — Concrete Monument
- Scale 1" = 30'

WE CERTIFY: That we have surveyed the above described property and that the plat shown hereon is an accurate survey and a true representation thereof and correctly shows the exterior boundary lines and all divisions of said property.

Date JAN 1965

Lloyd L. Jensen
LOYD L. JENSEN, Partner

Wisconsin Registered Land Surveyor, No. S-211

WCP-92

11-192 T

11-192