


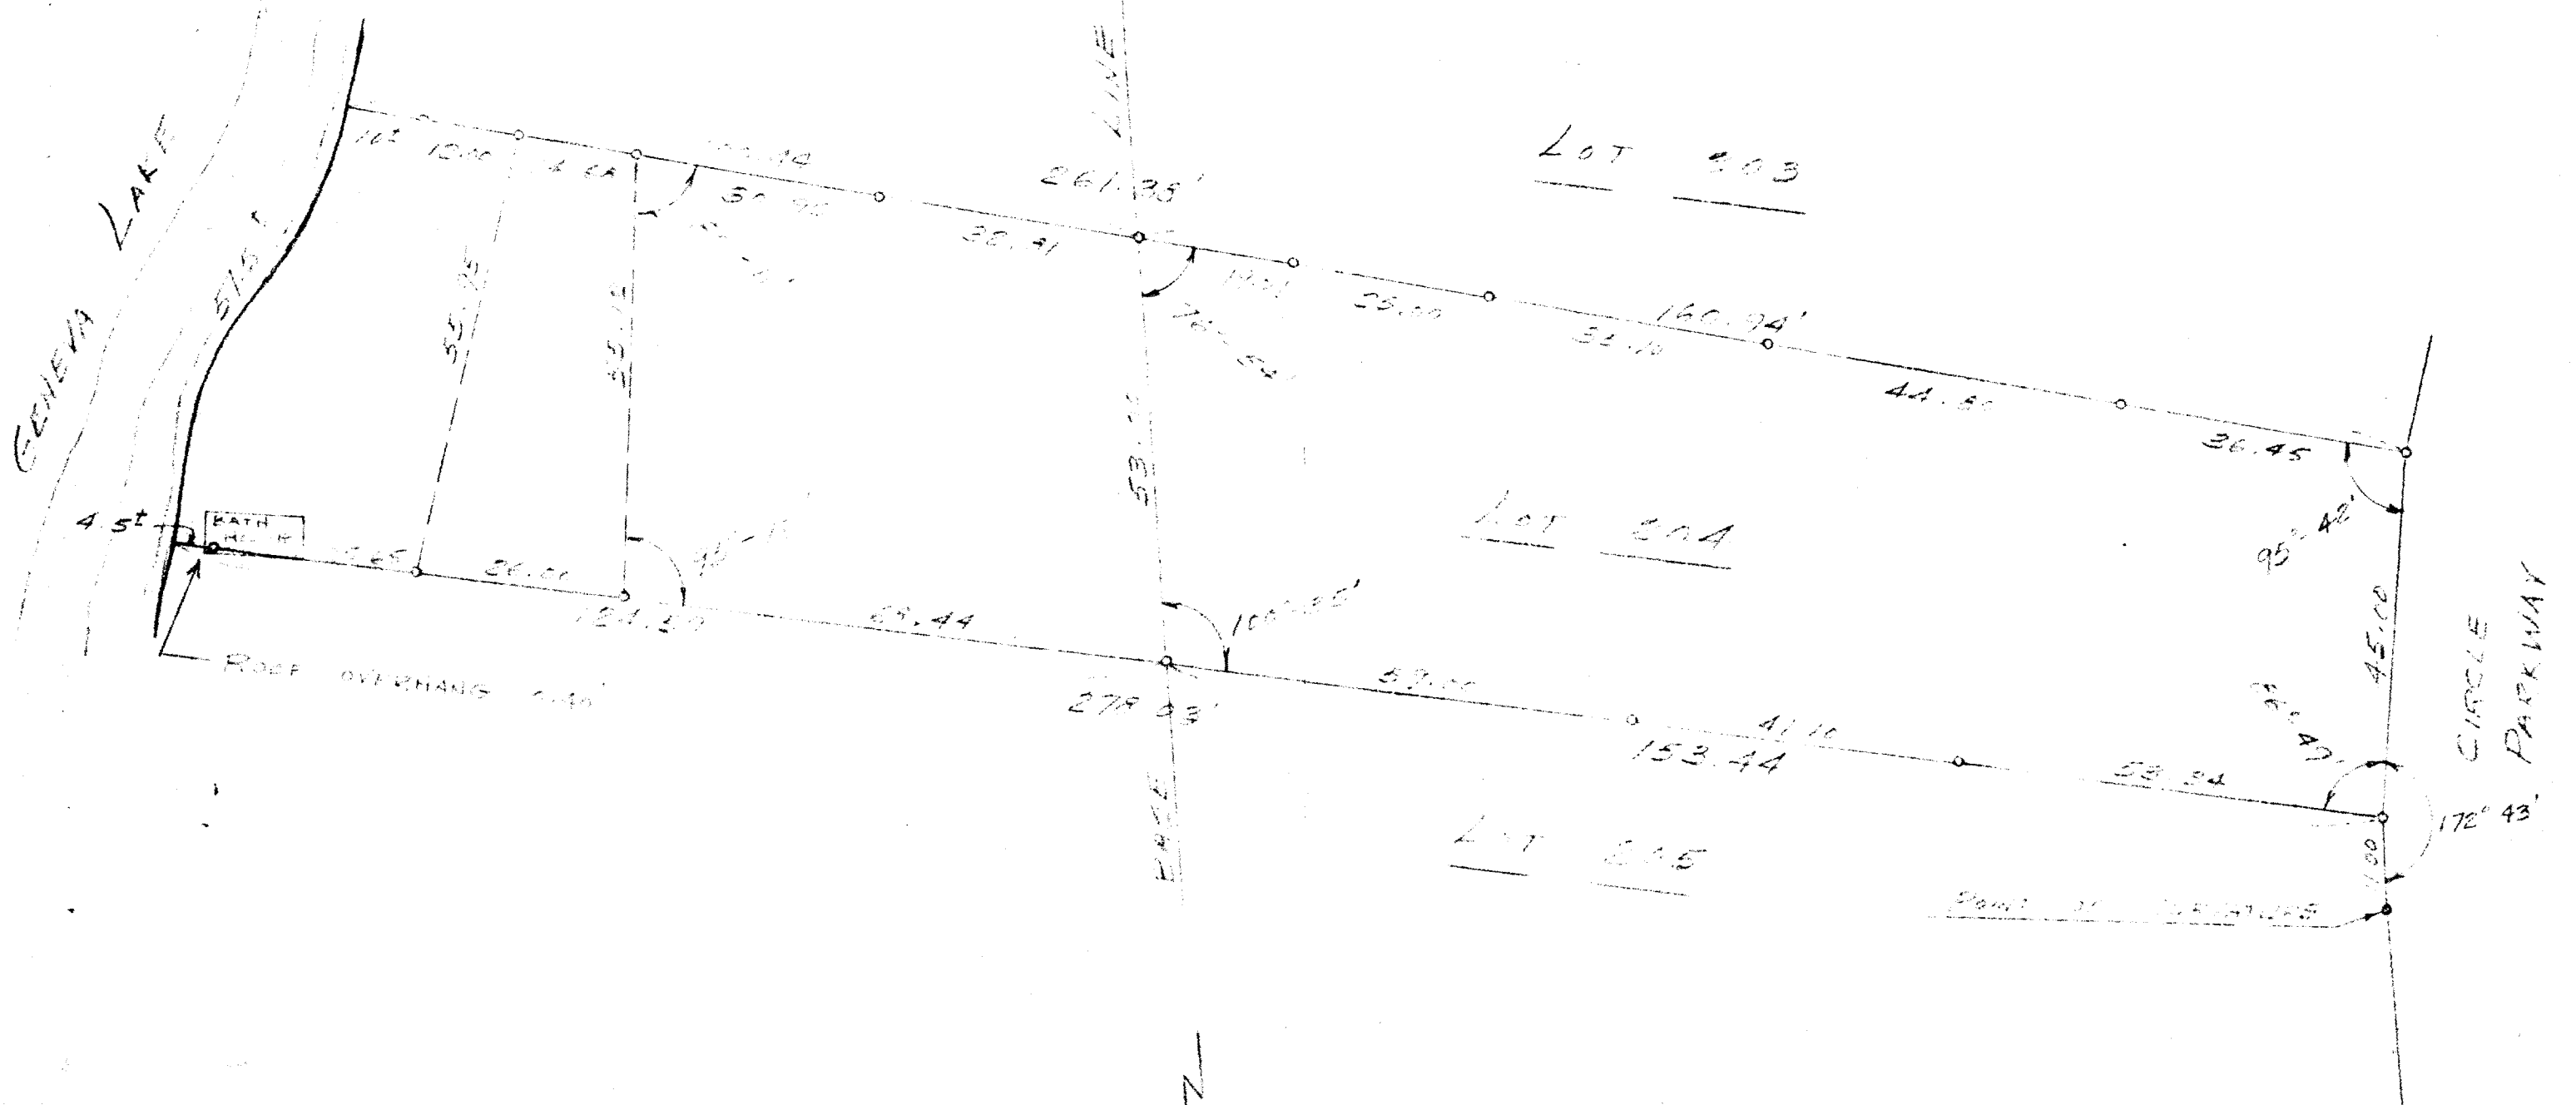

PLAT OF SURVEY OF

LOT 204, 300 ADDITION
CEDAR POINT PARK, WALWORTH
COUNTY WISCONSIN.

Lloyd L. Jensen
SURVEYOR

SCALE 1" = 20'

DATE AUGUST 1964