


PLAT OF SURVEY

OF

LOT 11 - BLOCK 2
UNIVERSITY HEIGHTS
VILLAGE OF WILLIAMS BAY
WALWORTH COUNTY, WISCONSIN

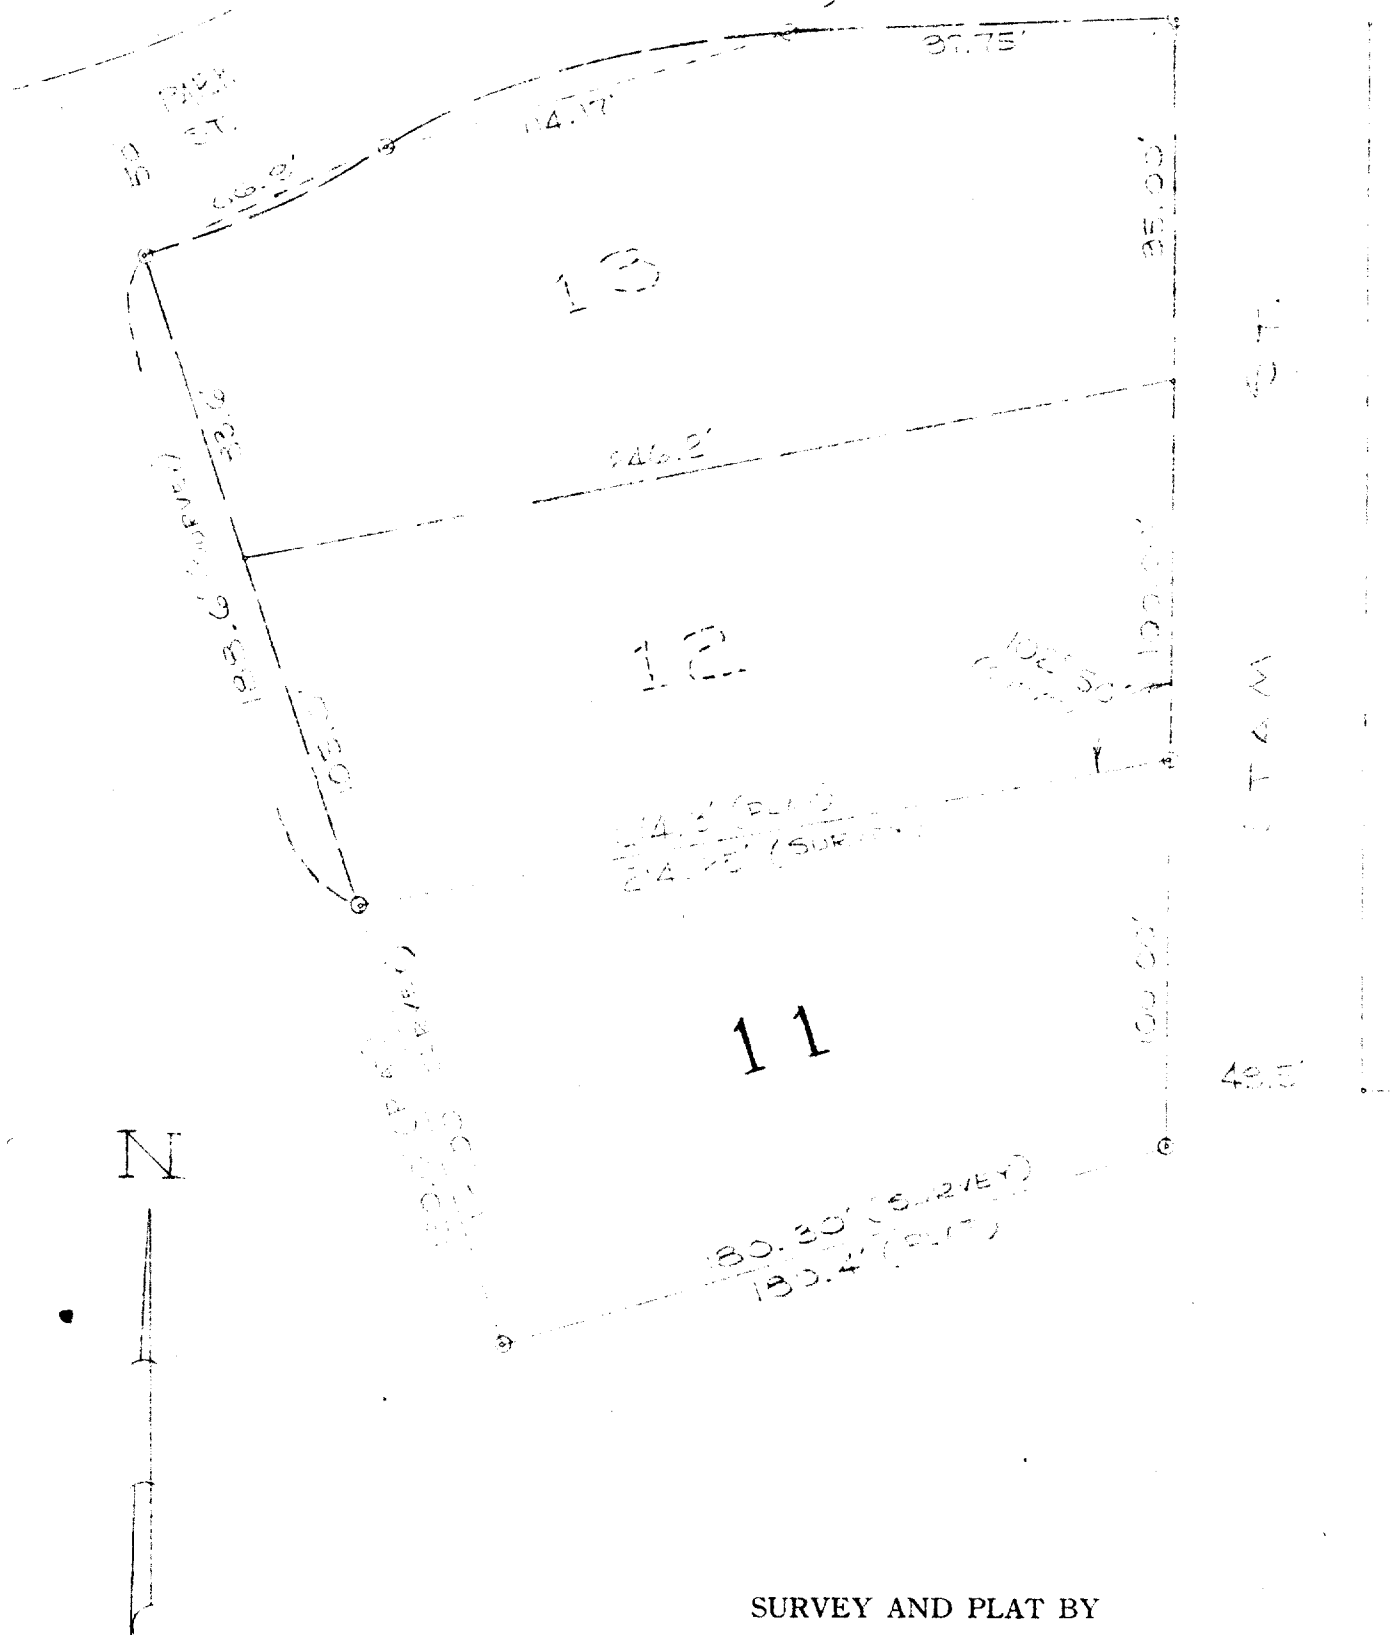

N

LEGEND

- — Iron Pipe
 - — Concrete Monument
- Scale 1" = 50'

SURVEY AND PLAT BY
JENSEN & JOHNSON
CIVIL ENGINEERS AND SURVEYORS

Elkhorn, Wisconsin

WE CERTIFY: That we have surveyed the above described property and that the plat shown hereon is an accurate survey and a true representation thereof and correctly shows the exterior boundary lines and all divisions of said property.

Date February 19, 1963

Lloyd J. Jensen
LLOYD J. JENSEN, Partner

Wisconsin Registered Land Surveyor, No. S-211

WUH-13

11-197