


Scale
1" = 30'

address: 406 Maple Lane

denotes iron
pipe found

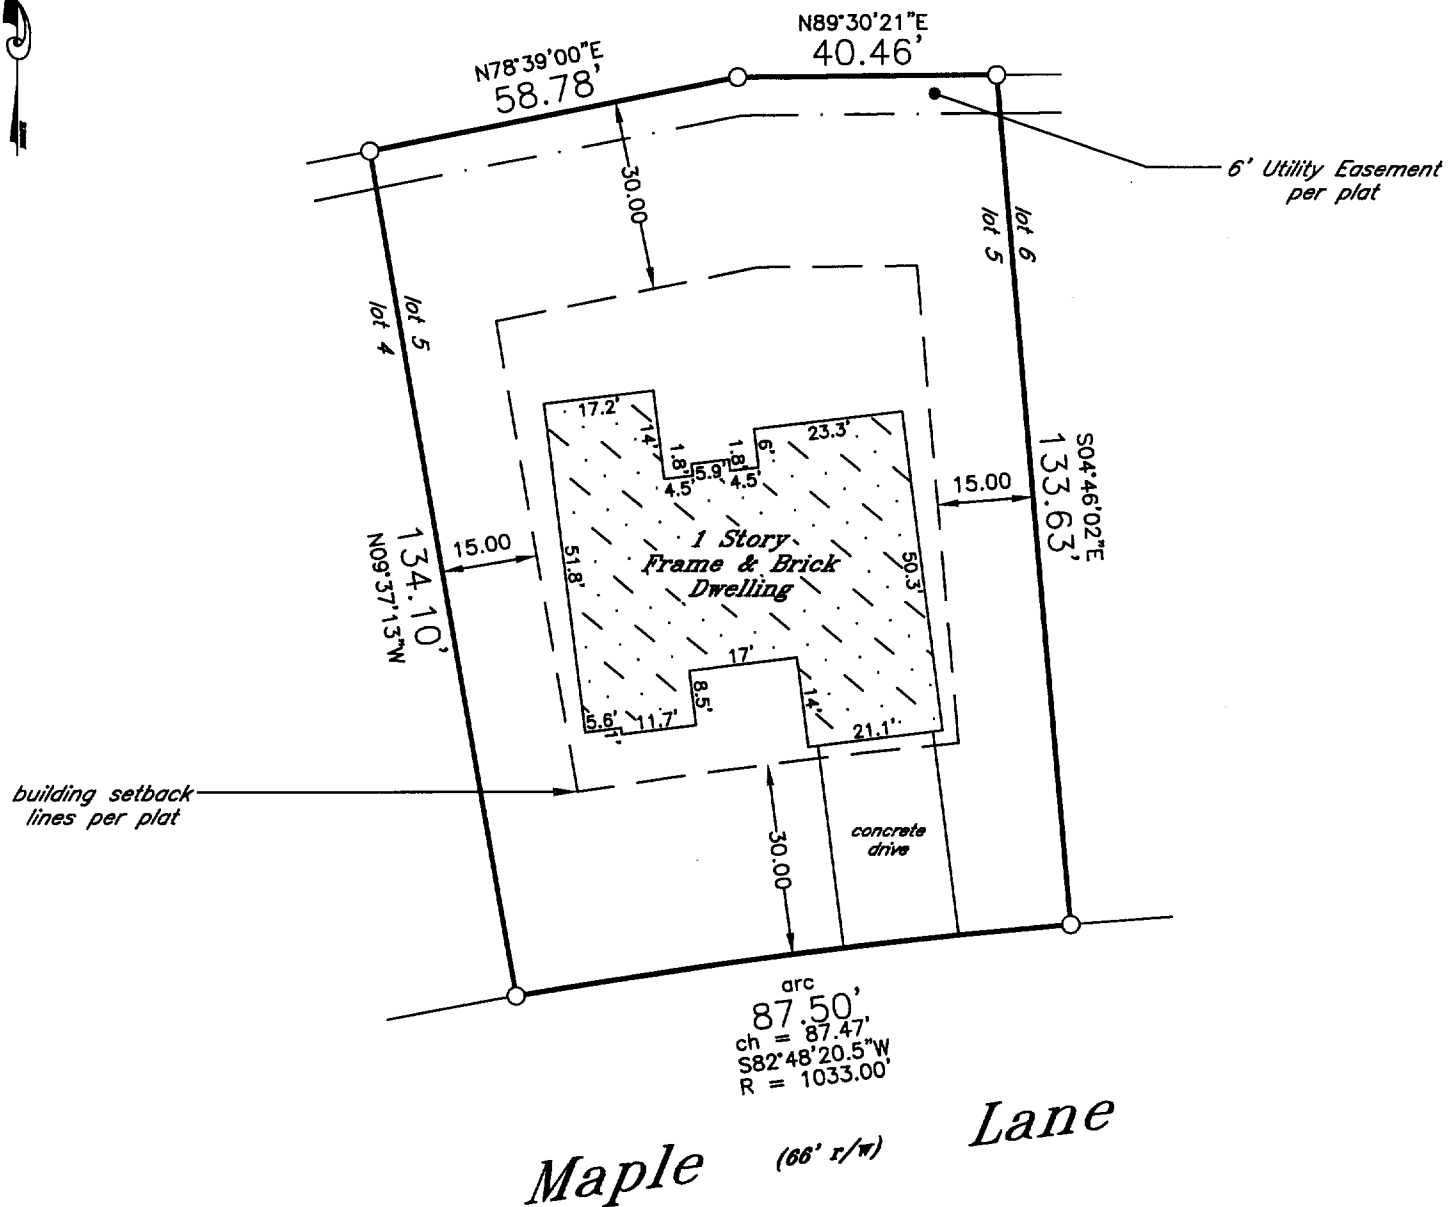

tax key no.: WLAK-95

Refer to a current title report for easements or restrictions which may affect the use of this site that are not shown on the recorded subdivision plat.


J.K.R. SURVEYING, INC.
8121 22ND AVENUE
KENOSHA, WI 53143



I hereby certify that
this property was
surveyed under my
direction and this
plat is a true re-
presentation thereof.

[Signature]

Reg. Land Surveyor
July 16, 2005

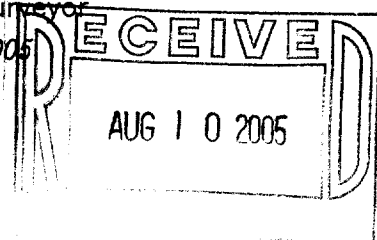

Plat of Survey of
LOT 5 BLOCK 6
LAKEWOOD TRAILS SUBDIVISION
in NW1/4 Section 1-1-16
VILLAGE OF WILLIAMS BAY
WALWORTH COUNTY, WIS.

-for-
James Construction

011-1980