


ABELL SURVEYING & MAPPING

1140 SEQUOIA STREET • DELAVAN, WISCONSIN 53115
262-728-6737



N

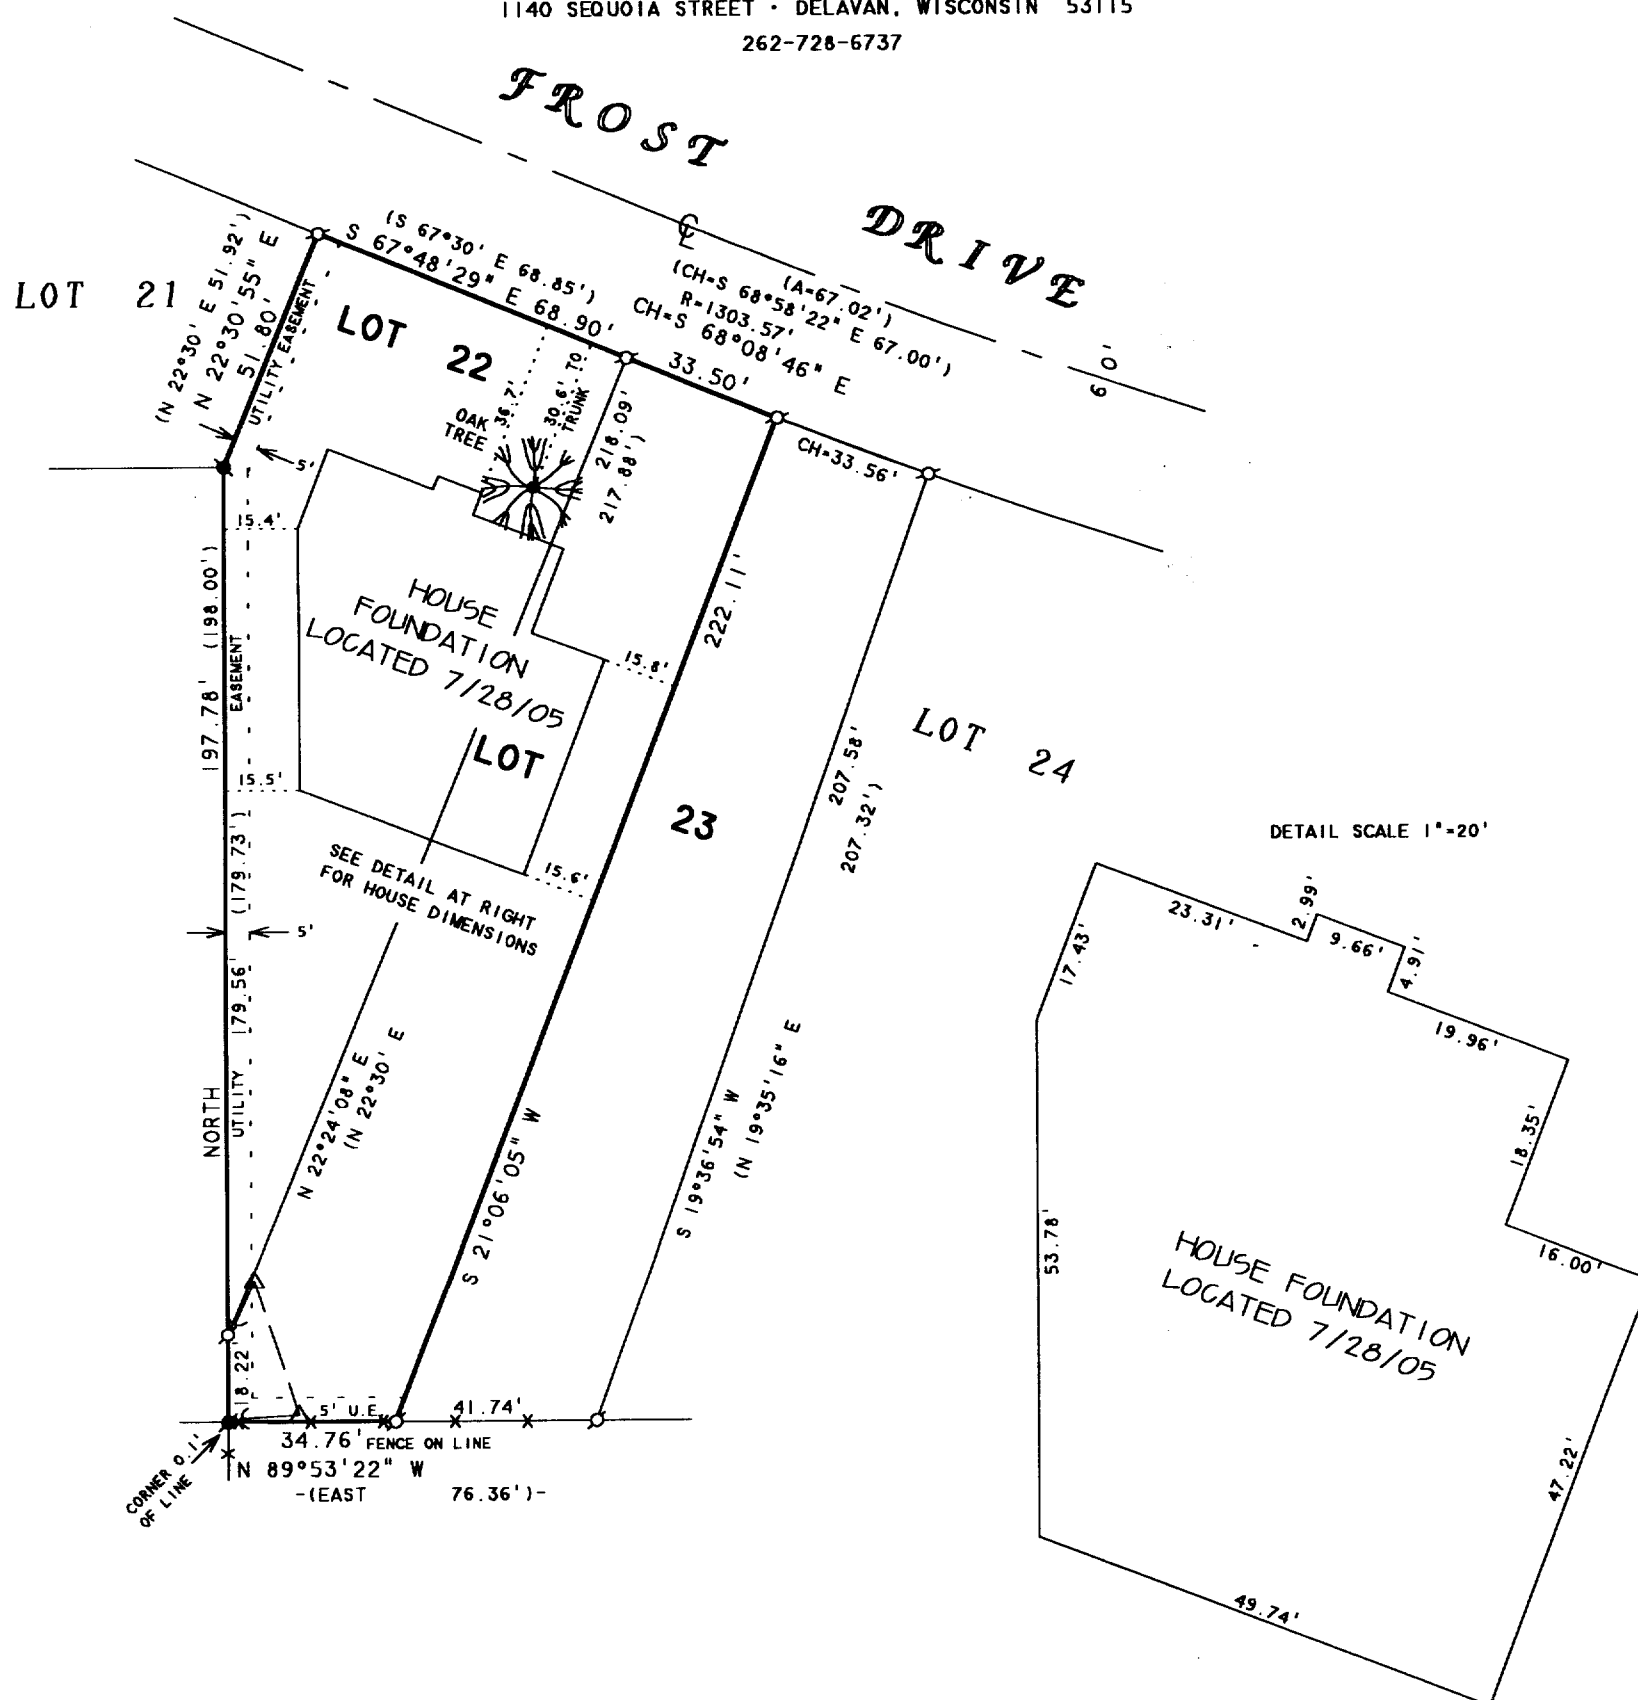

SCALE 1"=40'

LEGEND

- - IRON PIPE FOUND
- - CONCRETE MONUMENT FOUND
- △ - UTILITY POLE
-) - GUY WIRE
-) - OVERHEAD UTILITY LINES
- * - CHAINLINK FENCE
- () - RECORDED AS

REVISED DATE: JUNE 27, 2005
REVISED TO SHOW NEW PROPOSED
HOUSE LOCATION.

REVISED DATE: JULY 29, 2005
REVISED TO SHOW FOUNDATION
LOCATION.

ORDERED BY: ADVANTAGE HOMES, INC.
2017 N. HARMONY TOWN HALL ROAD
JANESVILLE, WI 53546

PLAT OF SURVEY OF

LOT 22 AND THE WEST 1/2 OF LOT 23, BAYWOOD
HEIGHTS ADDITION NO. 1, LOCATED IN THE
VILLAGE OF WILLIAMS BAY, WALWORTH COUNTY,
WISCONSIN, CONTAINING 0.40 ACRES.

I HEREBY CERTIFY THAT I HAVE SURVEYED THE ABOVE DESCRIBED PROPERTY AND THAT THE
ABOVE MAP IS A TRUE REPRESENTATION THEREOF AND SHOWS THE SIZE AND LOCATION OF
THE PROPERTY, ITS EXTERIOR BOUNDARIES, THE LOCATION OF ALL VISIBLE STRUCTURES
AND DIMENSIONS OF ALL PRINCIPAL BUILDINGS THEREON, BOUNDARY FENCES, APPARENT
EASEMENTS, ROADWAYS AND VISIBLE ENCROACHMENTS, IF ANY, TO THE BEST OF MY
KNOWLEDGE AND BELIEF.

THIS SURVEY IS MADE FOR THE USE OF THE PRESENT OWNERS OF THE PROPERTY, AND ALSO
THOSE WHO PURCHASE, MORTGAGE, OR GUARANTEE THE TITLE THERETO WITHIN ONE (1) YEAR
FROM DATE HEREON.

David F. Abell

DAVID F. ABELL
WISCONSIN REGISTERED LAND SURVEYOR, S-1596

May 13, 2005

DATE: May 13, 2005 JOB NUMBER - 96141E
NOTE: THIS IS NOT A CERTIFIED COPY UNLESS SEALED.

WBW1 00002

011-1991