


SOUTHWEST CORNER OF
THE NW 1/4 OF THE NW 1/4
OF SECTION 6 T1N R1E

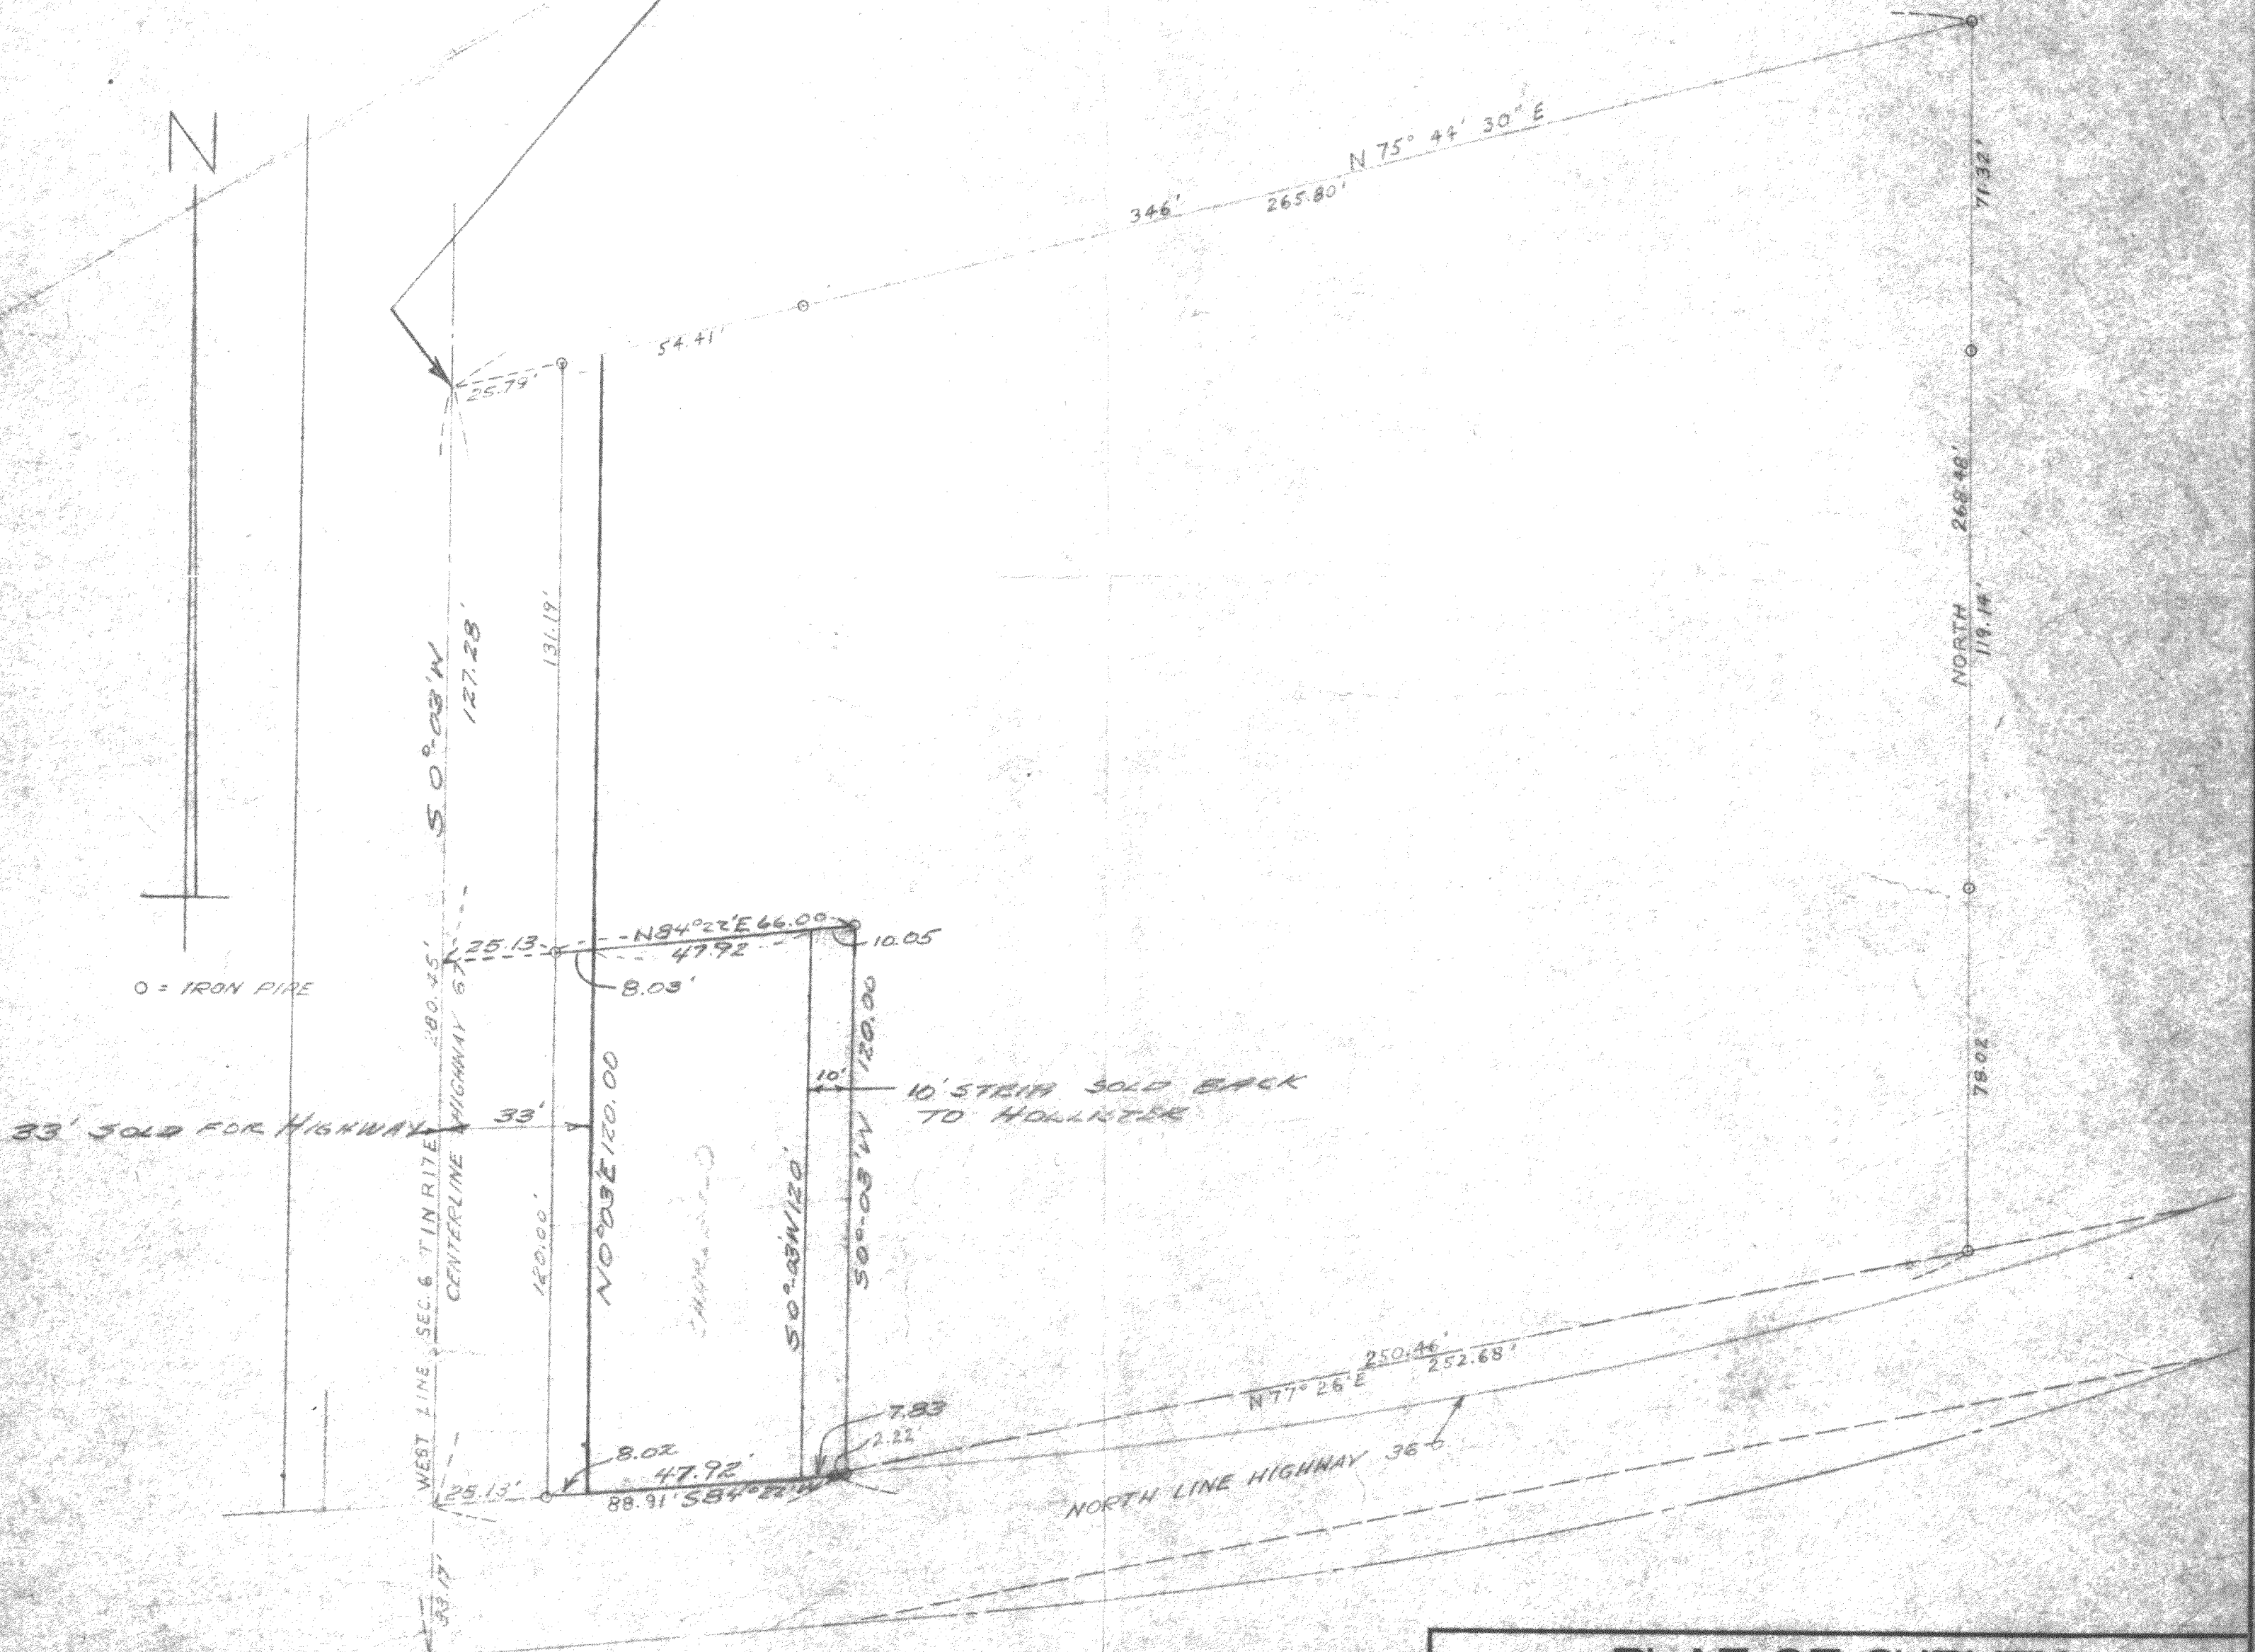

PLAT OF SURVEY OF

LANDS OWNED BY THE HOLLISTER
LUMBER CO. IN THE NW 1/4 OF
SECTION 6 T1N R1E, IN THE
VILLAGE OF WILLIAMS BAY,
WALWORTH COUNTY, WISC.

REVISED 6-19-69

L. J. J.

L. J. J.
SURVEYOR

SCALE 1" = 30'

DATE NOVEMBER 1969