


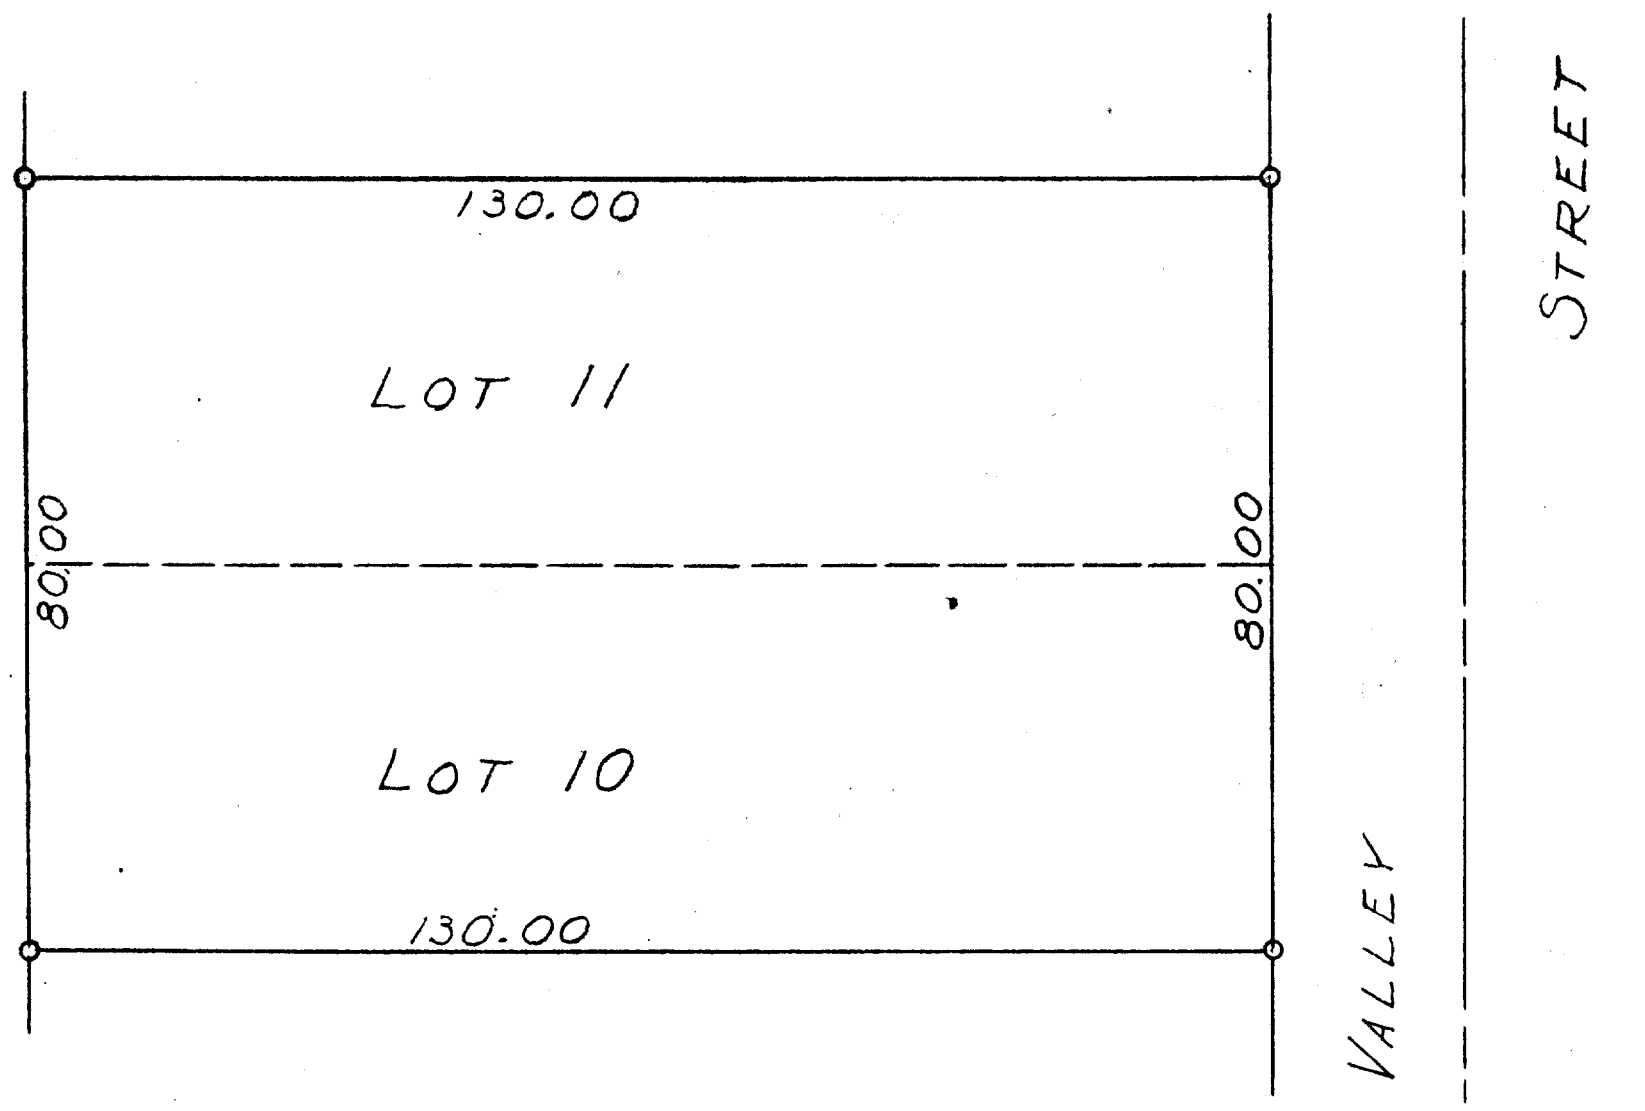

SCALE ~ 1" = 20'
O ~ IRON PIPE

PLAT OF SURVEY OF LOTS 10 AND 11, CARLSON'S ADDITION
TO THE VILLAGE OF WILLIAM'S BAY, WALWORTH COUNTY, WISCONSIN.
AUGUST 12, 1957
REVISED: SEPT. 5, 1957

George T. Dunham
GEORGE T. DUNHAM, SURVEYOR
DELAN, WISCONSIN

11-20