


PREPARED FOR
CARLTON W. LOHRENTZ & ASSOCIATES
ATTORNEYS AT LAW
C/O CARLTON LOHRENTZ
1655 N. ARLINGTON HEIGHTS RD.
SUITE 102E
ARLINGTON HEIGHTS IL. 60004


PLAT OF SURVEY

PATHFINDER SURVEYING INC.
N3705 WILLOW BEND LANE
LAKE GENEVA WI. 53147

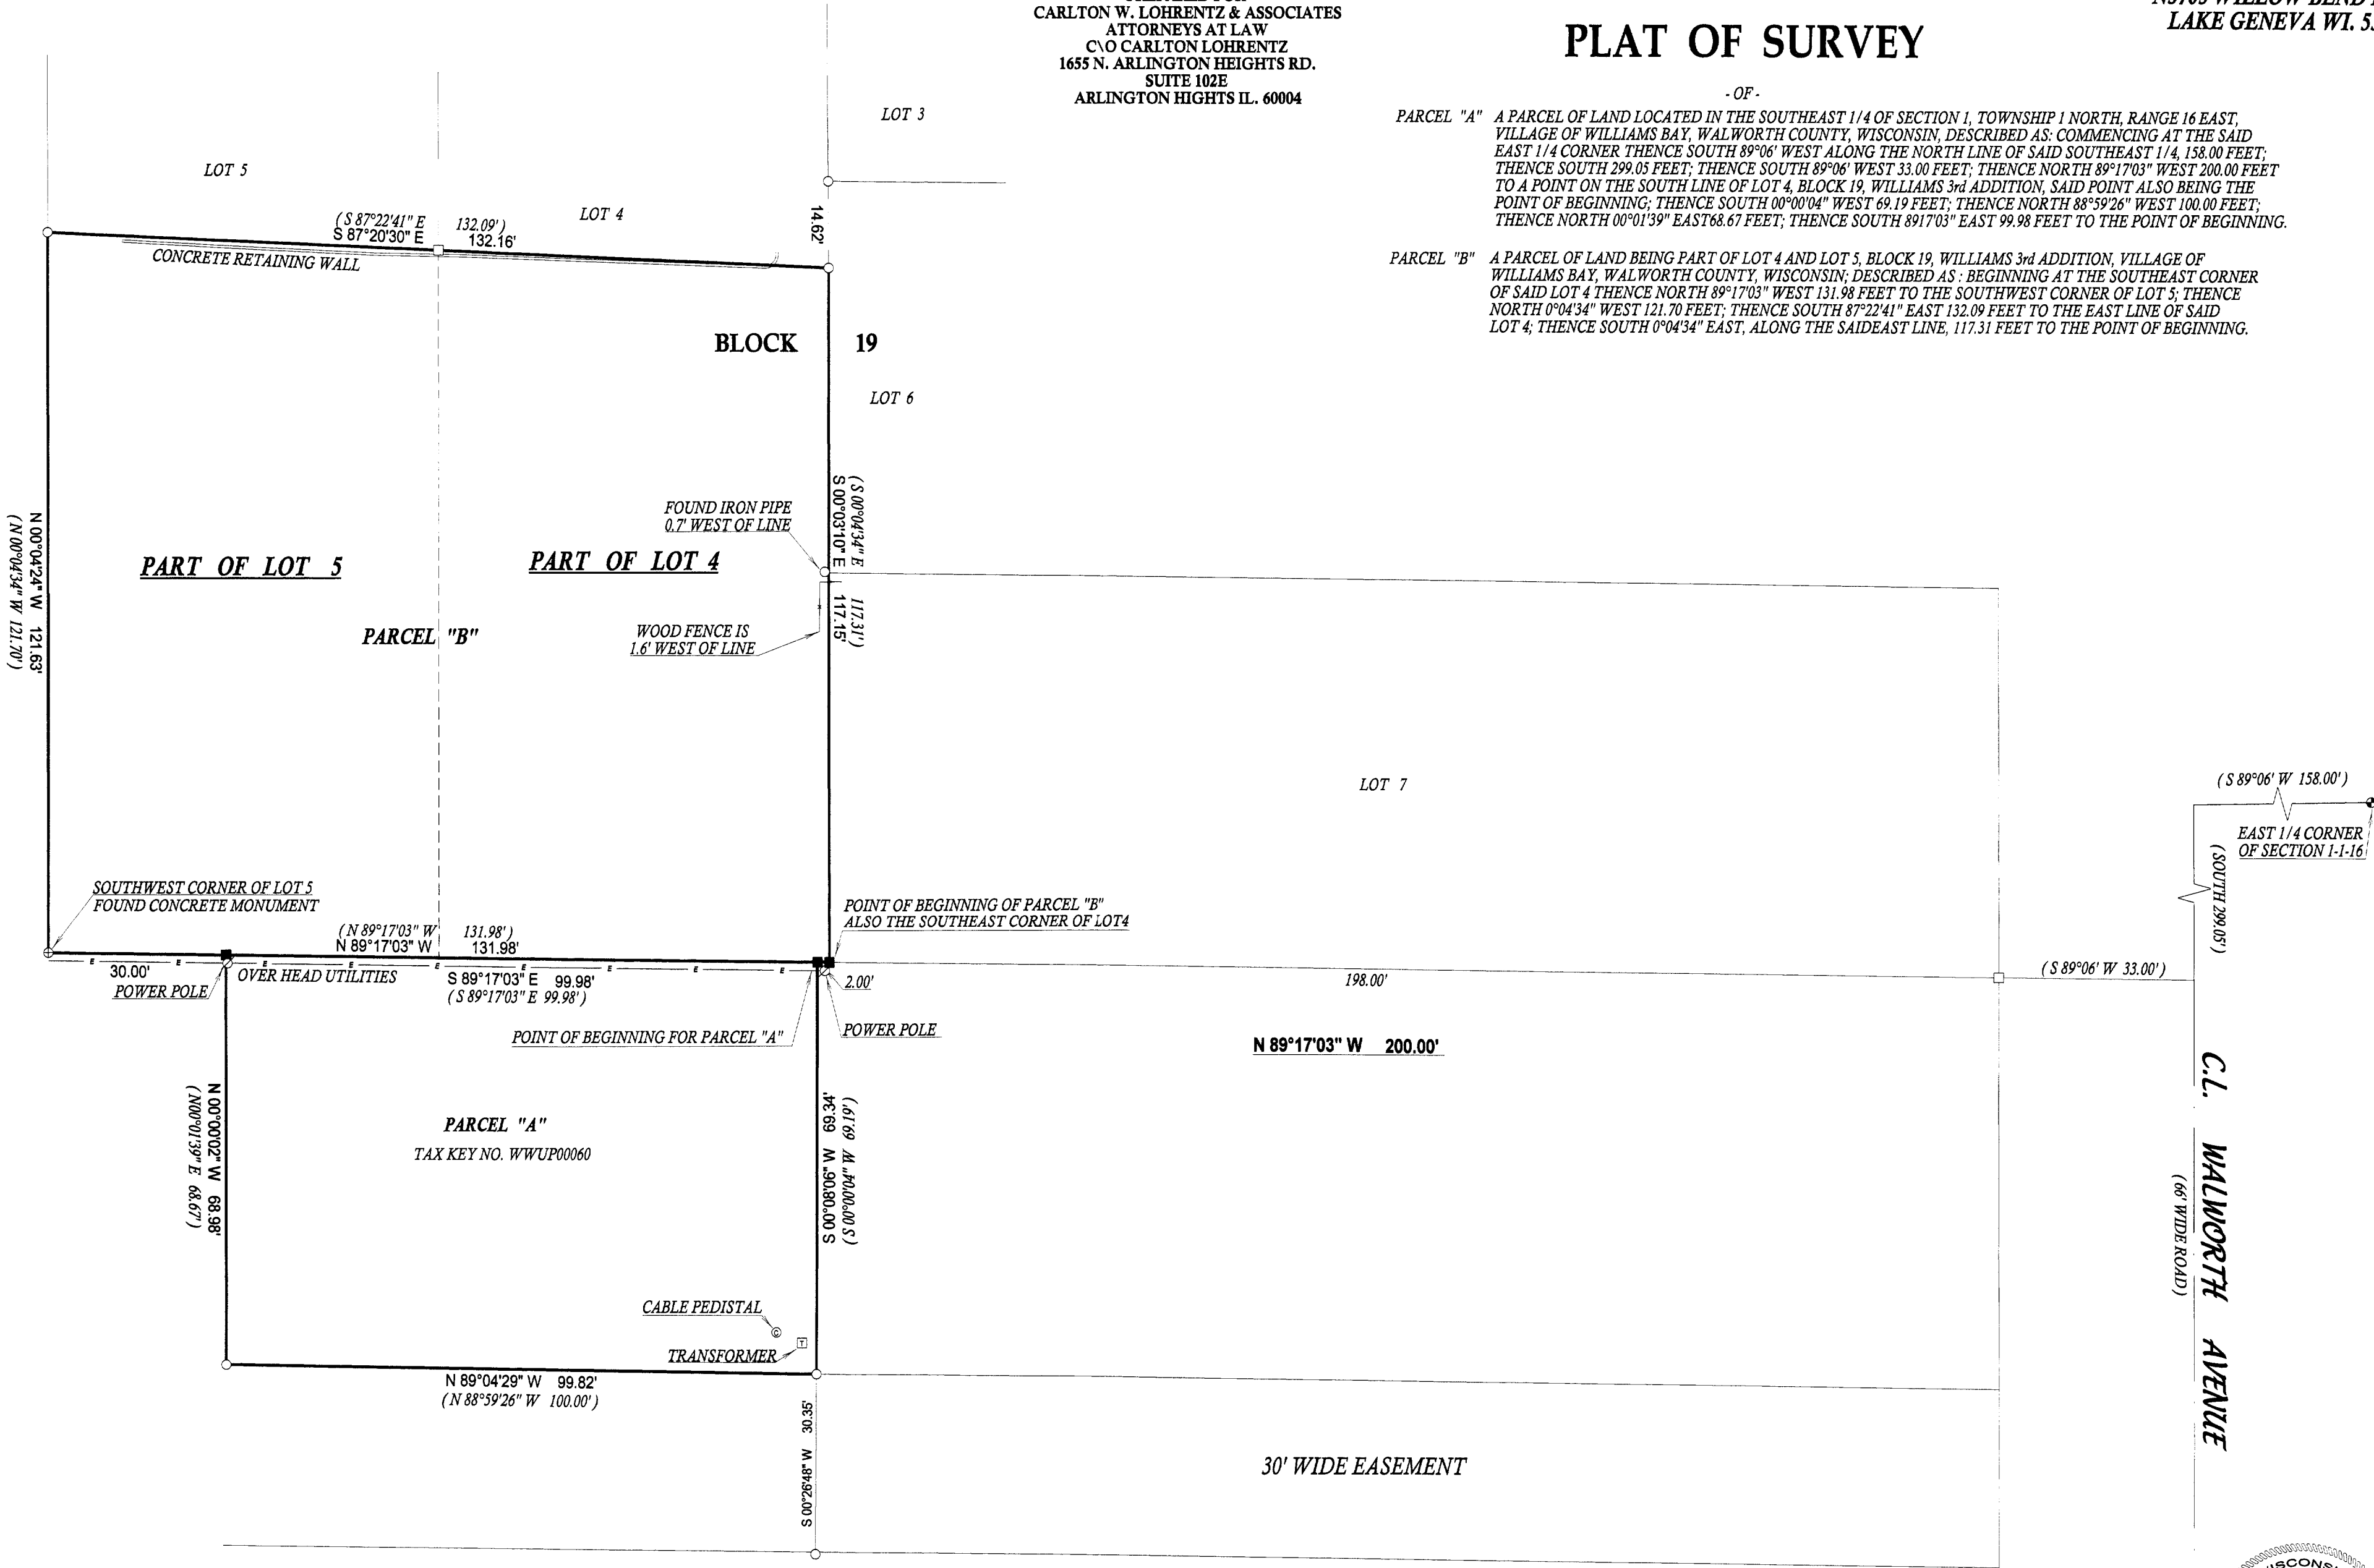

PARCEL "A" A PARCEL OF LAND LOCATED IN THE SOUTHEAST 1/4 OF SECTION 1, TOWNSHIP 1 NORTH, RANGE 16 EAST, VILLAGE OF WILLIAMS BAY, WALWORTH COUNTY, WISCONSIN, DESCRIBED AS: COMMENCING AT THE SAID EAST 1/4 CORNER THENCE SOUTH 89°06' WEST ALONG THE NORTH LINE OF SAID SOUTHEAST 1/4, 158.00 FEET; THENCE SOUTH 299.05 FEET; THENCE SOUTH 89°06' WEST 33.00 FEET; THENCE NORTH 89°17'03" WEST 200.00 FEET TO A POINT ON THE SOUTH LINE OF LOT 4, BLOCK 19, WILLIAMS 3rd ADDITION, SAID POINT ALSO BEING THE POINT OF BEGINNING; THENCE SOUTH 00°00'04" WEST 69.19 FEET; THENCE NORTH 88°59'26" WEST 100.00 FEET; THENCE NORTH 00°01'39" EAST 68.67 FEET; THENCE SOUTH 89°17'03" EAST 99.98 FEET TO THE POINT OF BEGINNING.

PARCEL "B" A PARCEL OF LAND BEING PART OF LOT 4 AND LOT 5, BLOCK 19, WILLIAMS 3rd ADDITION, VILLAGE OF WILLIAMS BAY, WALWORTH COUNTY, WISCONSIN, DESCRIBED AS: BEGINNING AT THE SOUTHEAST CORNER OF SAID LOT 4 THENCE NORTH 89°17'03" WEST 131.98 FEET TO THE SOUTHWEST CORNER OF LOT 5; THENCE NORTH 0°04'34" WEST 121.70 FEET; THENCE SOUTH 87°22'41" EAST 132.09 FEET TO THE EAST LINE OF SAID LOT 4; THENCE SOUTH 0°04'34" EAST, ALONG THE SAIDEAST LINE, 117.31 FEET TO THE POINT OF BEGINNING.

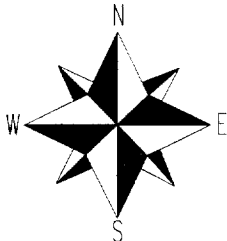


() = recorded as
□ = found iron bar
○ = found iron pipe
● = set iron pipe
■ = set iron bar
SCALE 1" = 20'

JOB # 05-559
TAX ID # WWUP00060 AND WOP00250A

COMPARE LEGAL DESCRIPTION ABOVE AND DRAWING WITH DEED, FOR BUILDING RESTRICTIONS AND EASEMENTS NOT SHOWN, REFER TO DEED, ABSTRACT SOURCES AND LOCAL MUNICIPAL CODES. NOTIFY THE SURVEYOR IMMEDIATELY OF ANY DISCREPANCY.
"I hereby certify that I have surveyed the above described property and that the above map, to the best of my knowledge and belief, is a true representation thereof and shows the size and location of all visible structures, apparent easements and encroachments if any."
This survey is made for the present owners of the property, and those who purchase, mortgage, or guarantee the title thereto, within one year from the date hereof.

DEC 14
SMC

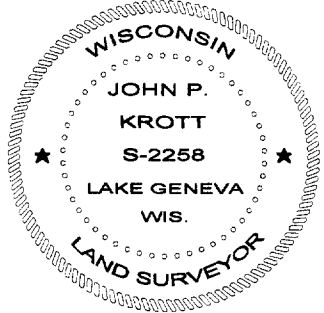

JOHN P. KROTT S - 2258
Wisconsin Registered Land Surveyor
(original if signed in red)

DATED THIS THE 20th DAY OF OCTOBER 2005.

011-2016