

PATHFINDER SURVEYING INC.
W2888 KRUEGER RD. UNIT "D"
LAKE GENEVA WI. 53147
(262) 248-3697

PLAT OF SURVEY

OF


PREPARED FOR
SCOTT FORESTER
PO BOX 716
WILLIAMS BAY WI. 53191

A PART OF BLOCK 4 OF THE ORIGINAL PLAT OF THE VILLAGE OF WILLIAMS BAY DESCRIBED BY METES AND BOUNDS AS FOLLOWS, TO-WIT: BEGINNING AT A POINT IN THE EAST LINE OF SAID BLOCK WHICH IS 56 FEET NORTH OF THE SOUTHEAST CORNER THEREOF; RUN THENCE WEST PARALLEL WITH, AND AT AN EVEN AND EQUAL DISTANCE OF 56 FEET NORTH FROM THE SOUTH LINE OF SAID BLOCK, 132 FEET; RUN THENCE NORTH 37 FEET PARALLEL WITH THE EAST LINE OF SAID BLOCK; RUN THENCE EAST 132 FEET TO THE EAST LINE OF SAID BLOCK; RUN THENCE SOUTH IN SAID EAST LINE 37 FEET TO THE PLACE OF BEGINNING, WALWORTH COUNTY, WISCONSIN.

DRIVE WAY RIGHT OF
WAY EASEMENT AS
SHOWN ON PREVIOUS
SURVEY OF RECORD

(132.00')
S 89°47'32" E 131.91'

(37.0')
N 00°07'03" W 37.39'

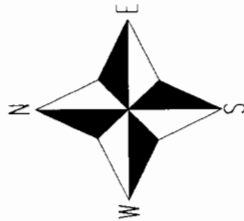

- () = recorded as
- = found iron bar
- = found iron pipe
- = set iron pipe
- = set iron bar



SCALE 1" = 20'

JOB # 06-331

TAX KEY # WOP00057

C.L. WALWORTH AVENUE

(66' WIDE ROAD)

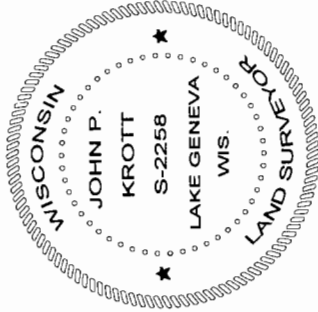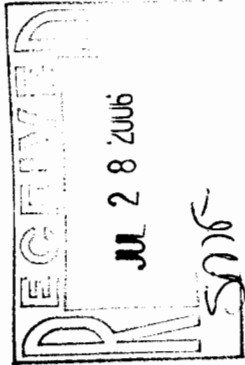

John P. Krott

JOHN KROTT S - 2258
Wisconsin Registered Land Surveyor
(original if signed in red)

DATED THIS THE 7th DAY OF JULY 2006.

COMPARE LEGAL DESCRIPTION ABOVE AND DRAWING WITH DEED. FOR BUILDING RESTRICTIONS AND EASEMENTS NOT SHOWN REFER TO DEED. ABSTRACT SOURCES AND LOCAL MUNICIPAL CODES. NOTIFY THE SURVEYOR IMMEDIATELY OF ANY DISCREPANCY.

"I hereby certify that I have surveyed the above described property and that the above map, to the best of my knowledge and belief, is a true representation thereof and shows the size and location of all visible structures, apparent easements and encroachments if any."

This survey is made for the present owners of the property, and those who purchase, mortgage, or guarantee the title thereto, within one year from the date hereof.

WOP .. 57

011-2071