




APR 22 2006

8/22/2006 X:\Projects\5925\Individuals\Block_1\Lot_1\ASBLT

MPV-1

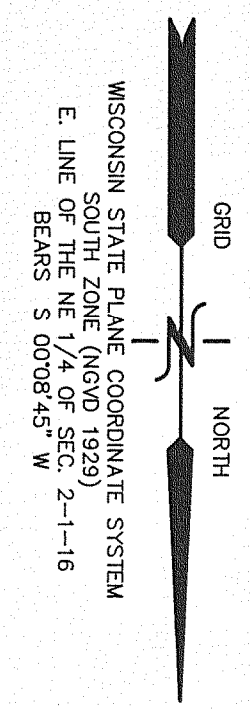

- LEGEND
- = FOUND IRON PIPE STAKE, 1 3/8" O.D.
 - = FOUND IRON REBAR STAKE, 3/4" DIA.
 - = FOUND CONCRETE COUNTY MONUMENT WITH BRASS CAP
 - = SET SOLID ROUND IRON BAR STAKE, 1 5/16" x 30" x 4.60 lbs./ft.
 - = SET IRON REBAR STAKES, 3/4" x 24" x 1.50 lbs./ft.
- ALL OTHER LOT AND OUTLOT CORNERS ARE SET IRON REBAR STAKES, 3/4" x 24" x 1.50 lbs./ft.
- {xxx} = RECORDED AS

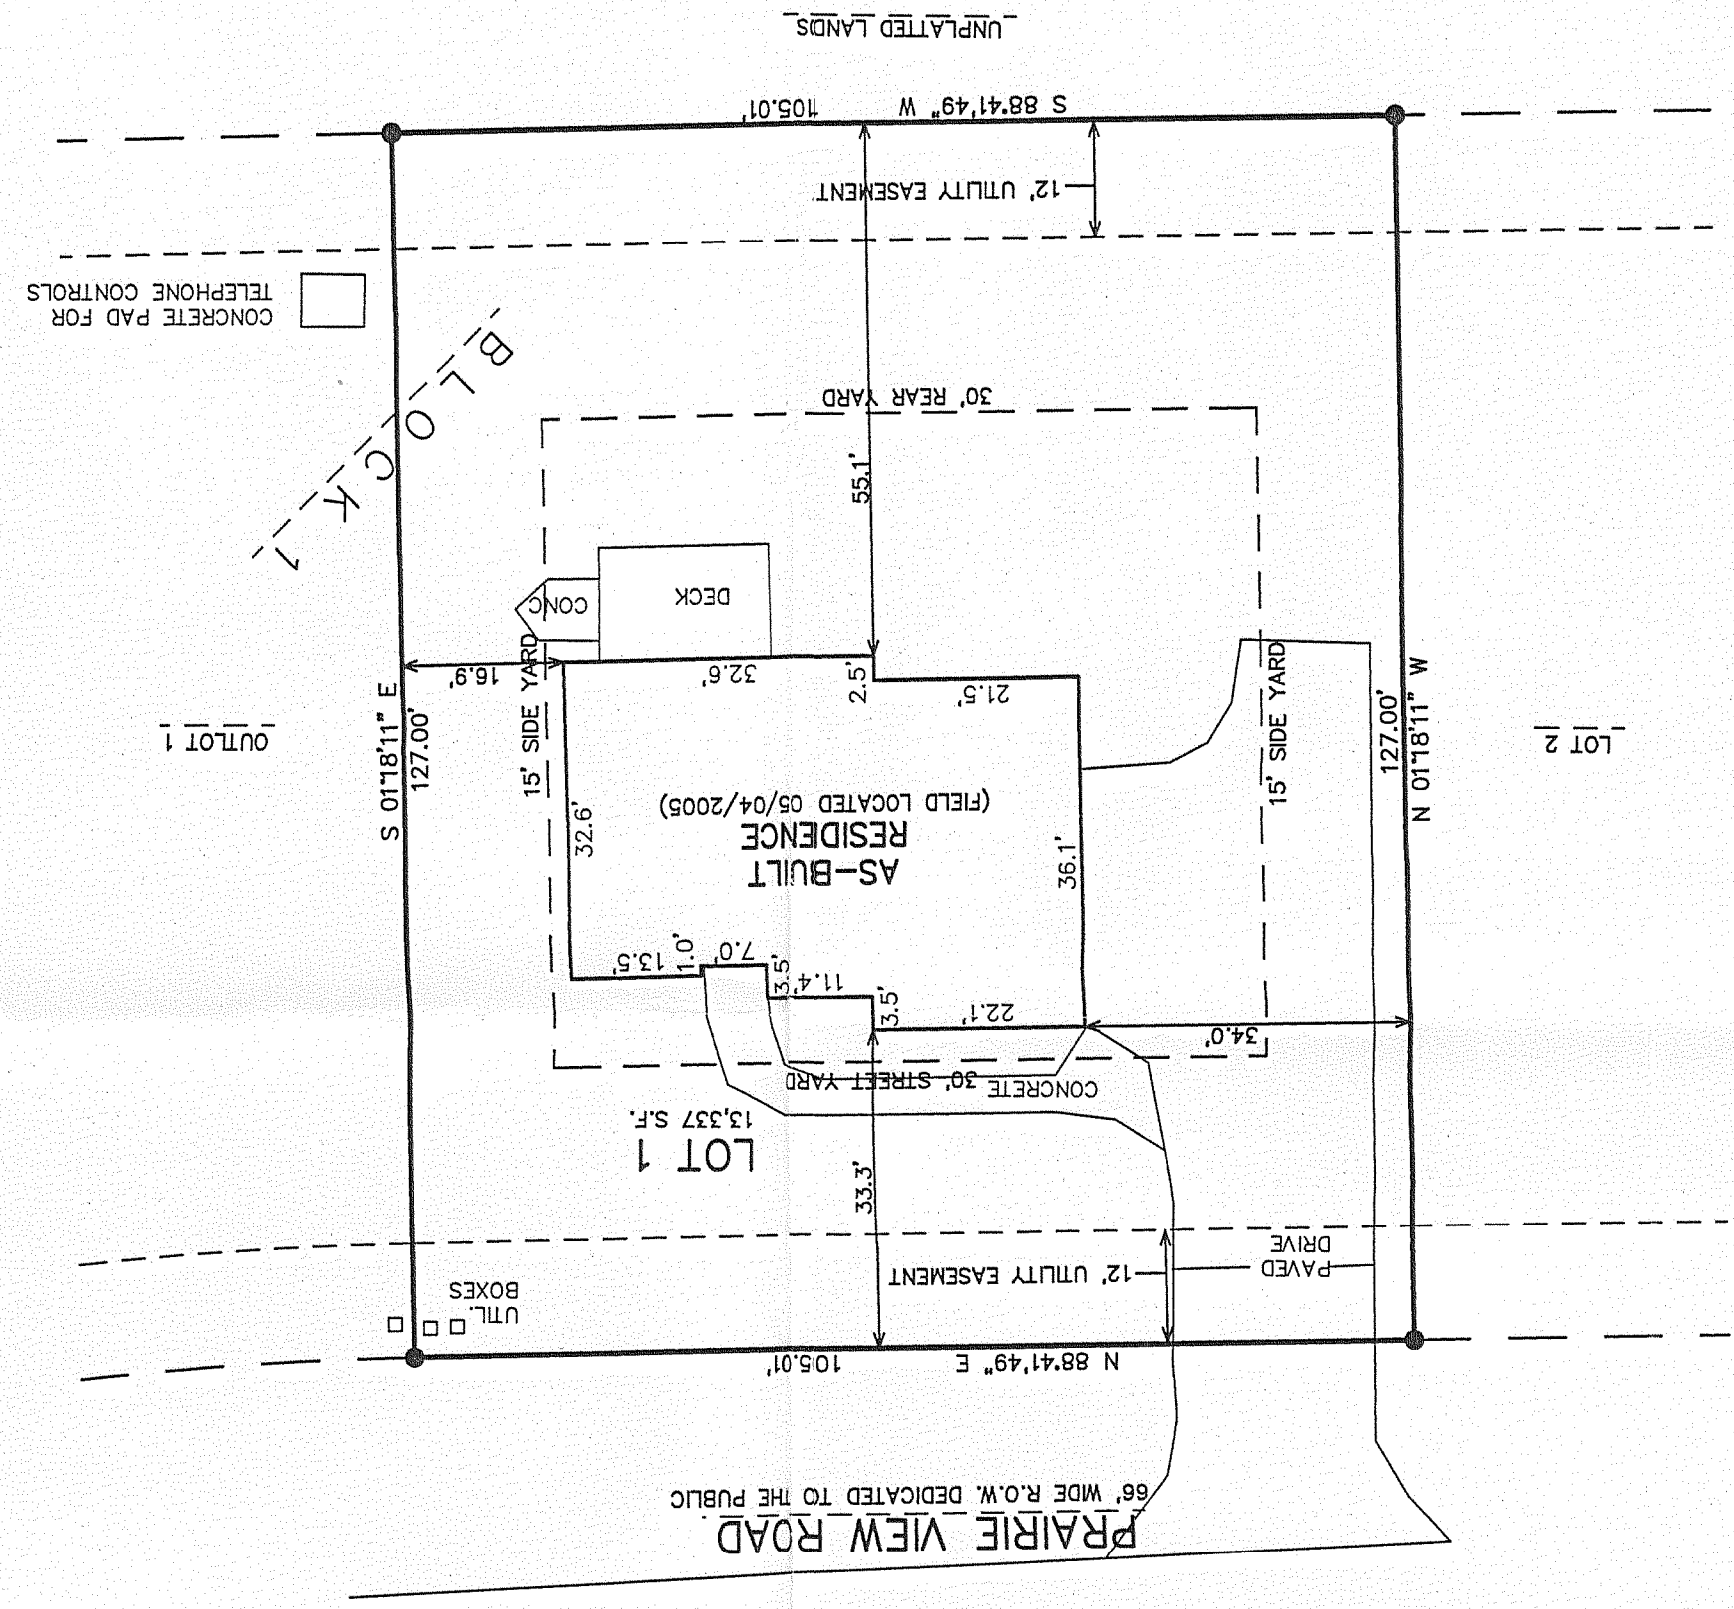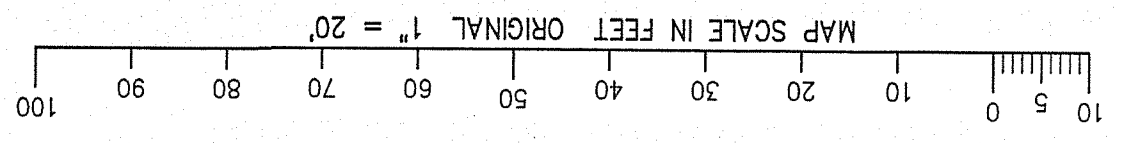

PLAT OF SURVEY


LOT 1, BLOCK 1 OF PRAIRIE VIEW SUBDIVISION

REC. IN CAB. C, SLIDE 195, AS DOC. NO. 623223

LOCATED IN PART OF THE NW 1/4 AND NE 1/4 OF THE NE 1/4

OF SECTION 2, TOWN 1 NORTH, RANGE 16 EAST, VILLAGE OF WILLIAMS BAY,

WALWORTH COUNTY, WISCONSIN

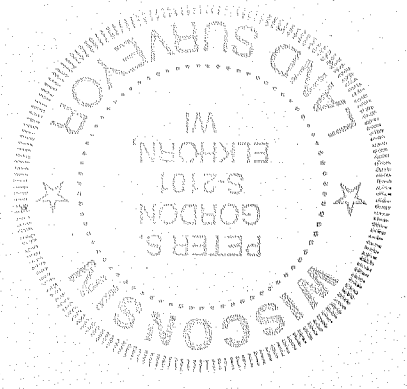

PETER S. GORDON

DATED: DECEMBER 16, 2004

I HEREBY CERTIFY THAT THE ABOVE DESCRIBED PROPERTY HAS BEEN SURVEYED UNDER MY DIRECTION AND THAT THE ABOVE MAP IS A TRUE REPRESENTATION THEREOF AND SHOWS THE SIZE AND LOCATION OF THE PROPERTY, ITS EXISTING BOUNDARIES, THE LOCATION OF ALL VISIBLE STRUCTURES, APPARENT EASEMENTS, ROADS, AND BUILDINGS THEREON, BOUNDARY FENCES, APPARENT EASEMENTS, ROADS, AND VISIBLE ENCROACHMENTS, IF ANY. THIS SURVEY IS MADE FOR THE USE OF THE PRESENT OWNERS OF THE PROPERTY, AND ALSO THOSE WHO PURCHASE, MORTGAGE, OR GUARANTEE THE TITLE HERETO WITHIN ONE YEAR FROM THE DATE HEREOF.

NOTE: COPIES OF THIS MAP TO WHICH THE FOLLOWING CERTIFICATE WILL APPLY SHOW THE SURVEYOR'S ORIGINAL SEAL AND SIGNATURE IN RED INK. COPIES BY ANY OTHER MEANS MAY HAVE ALTERATIONS WHICH DO NOT REPRESENT THE SURVEYOR'S WORK PRODUCT.

PROJECT NO. 5825.01.01

DATE: 12/16/2004

SHEET NO. 1 OF 1

REVISIONS

03/16/2005 TO SHOW SIZE AND LOCATION OF PROPOSED RESIDENCE

05/04/2005 TO SHOW SIZE AND LOCATION OF AS-BUILT RESIDENCE

08-22-2006 UPDATE IMP'TS

FARRIS, HANSEN & ASSOCIATES, INC.

ENGINEERING - ARCHITECTURE - SURVEYING

7 RIDGEWAY COURT P.O. BOX 437

ELKHORN, WISCONSIN 53121

OFFICE: (262) 723-2098 FAX: (262) 723-5886

WORK ORDERED BY -

JORDT BUILDERS

1916 HOBBS DRIVE

DELAVER, WI. 53115

