
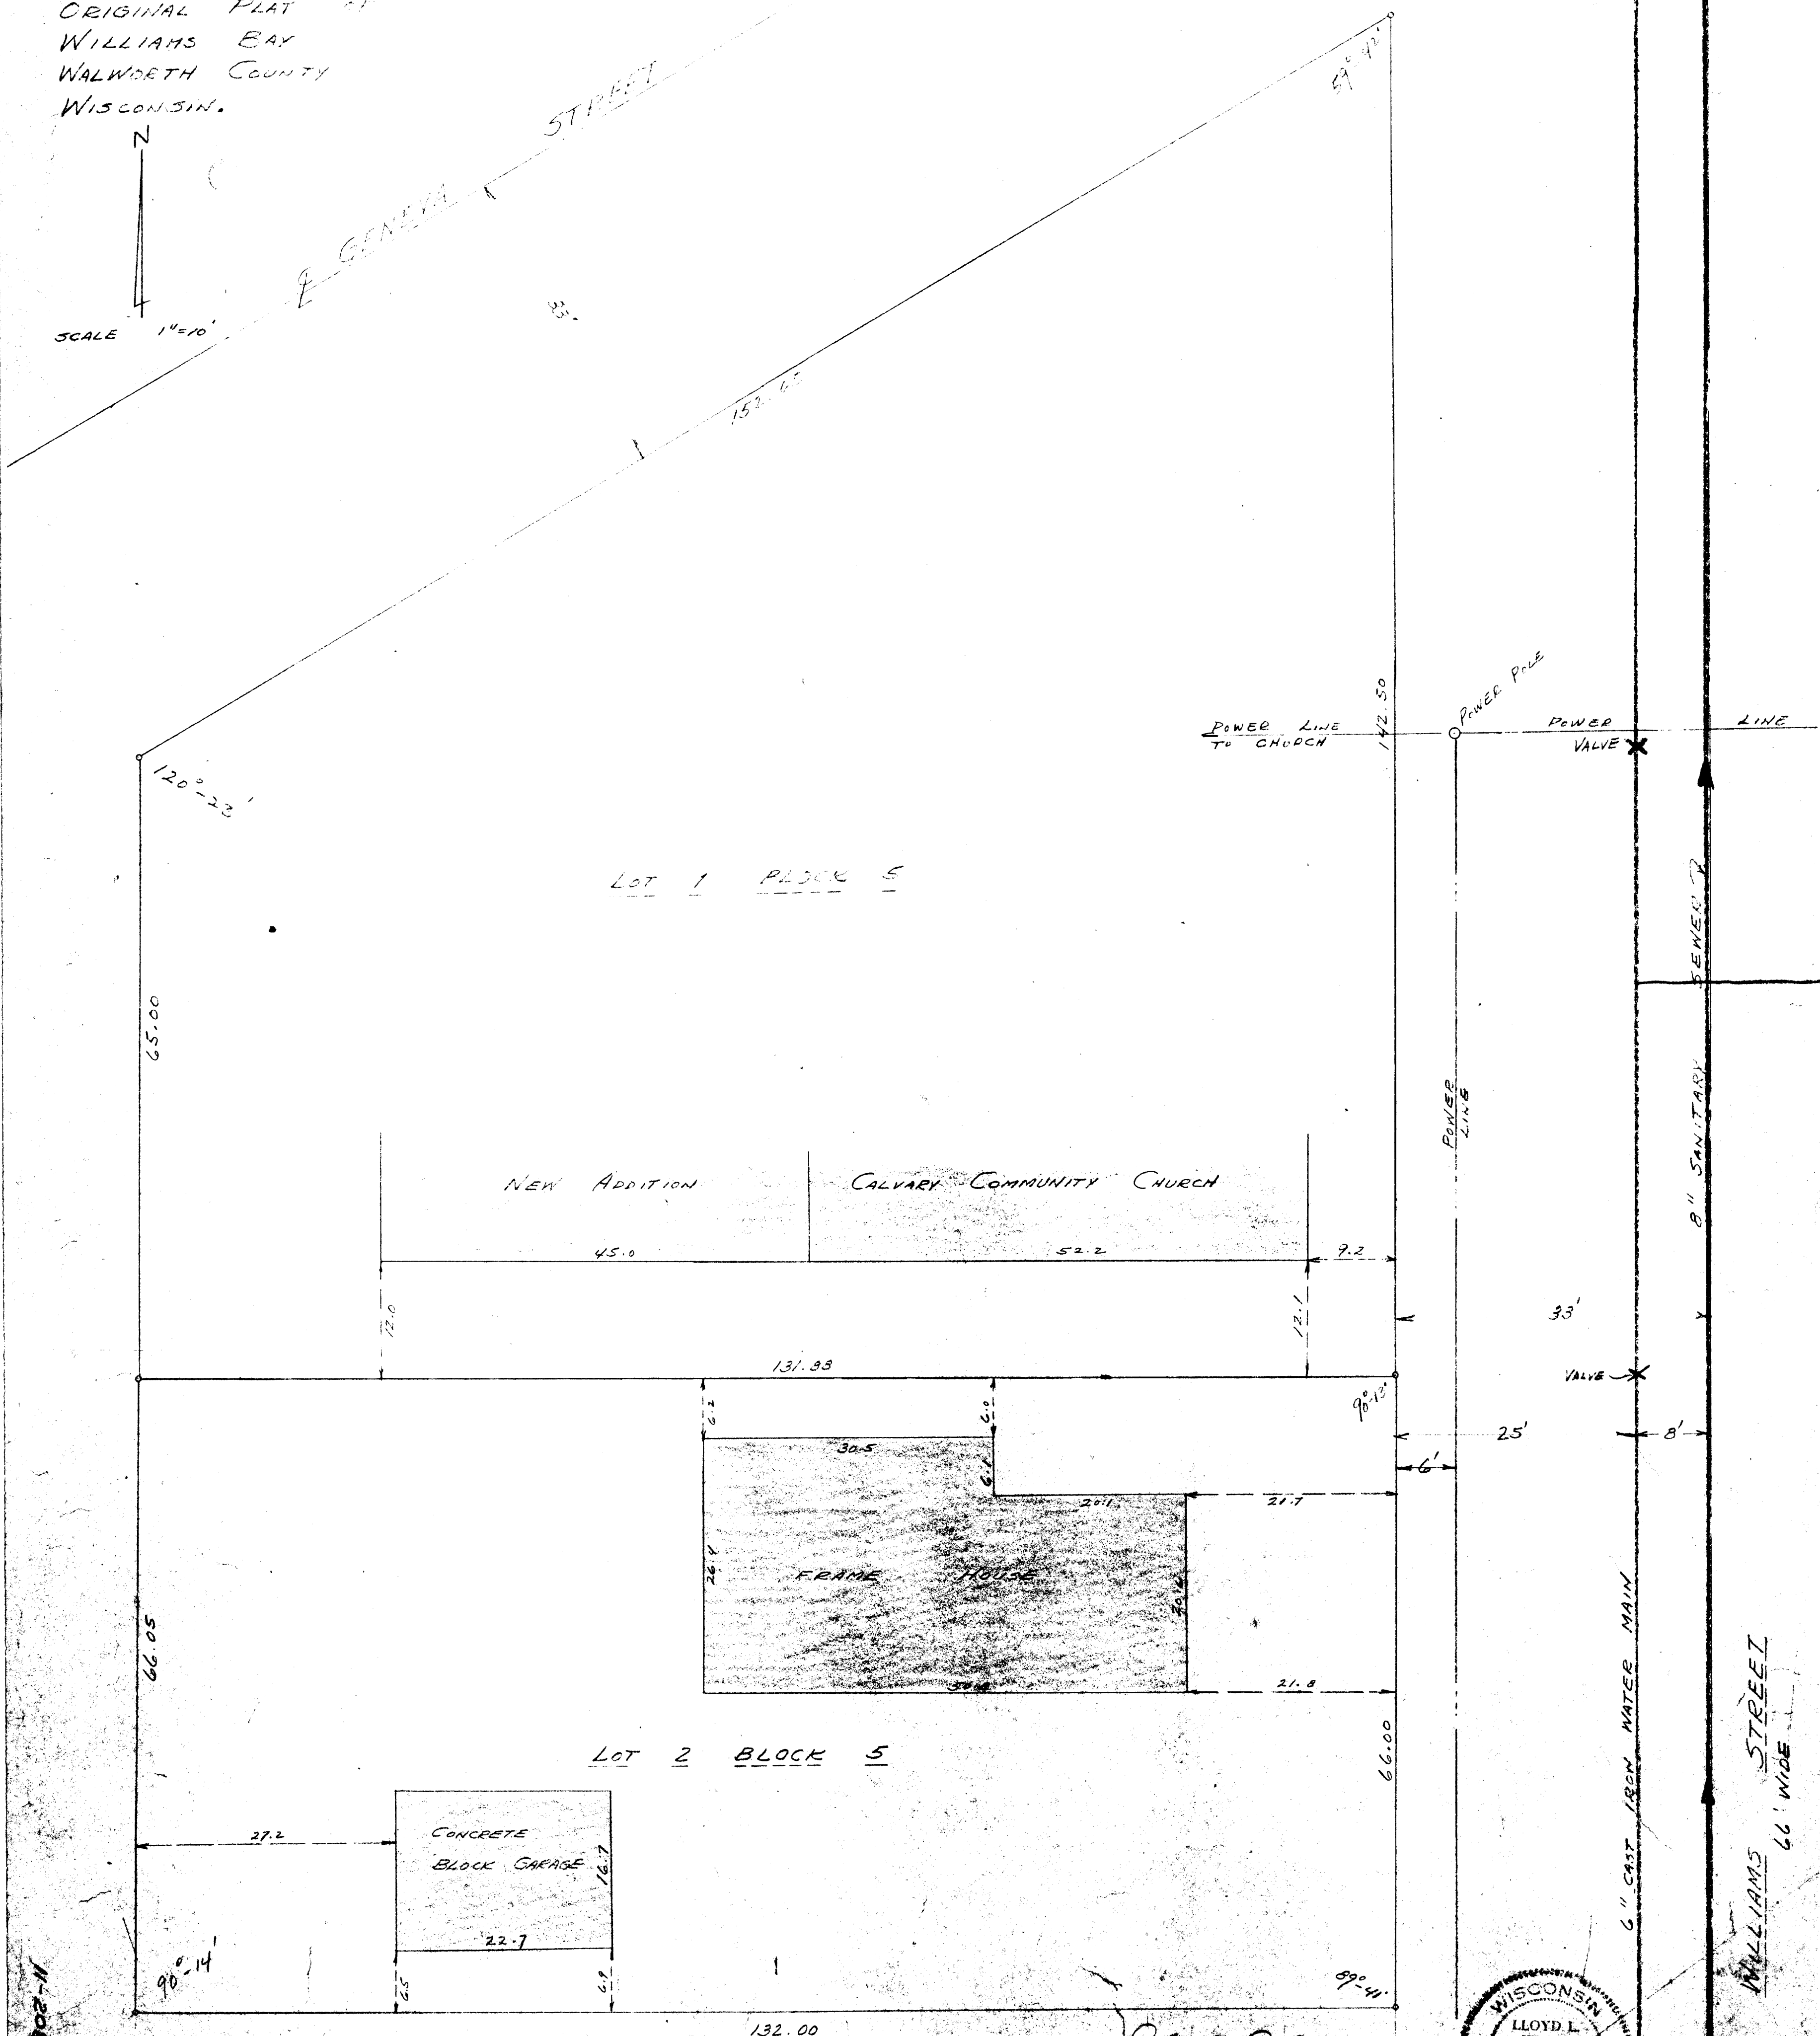


PLAT OF SURVEY

LOTS 1 AND 2 BLOCK 5
ORIGINAL PLAT OF
WILLIAMS BAY
WALWORTH COUNTY
WISCONSIN.

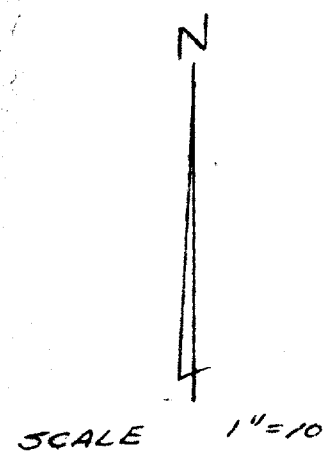


LEGEND

○ - IRON STAKE

OP-68 + OP-69

APR 15, 1967

Lloyd L. Jensen
LLOYD L. JENSEN

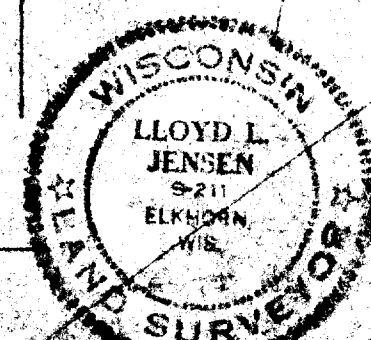

WILLIAMS STREET
66' WIDE