



#34/72

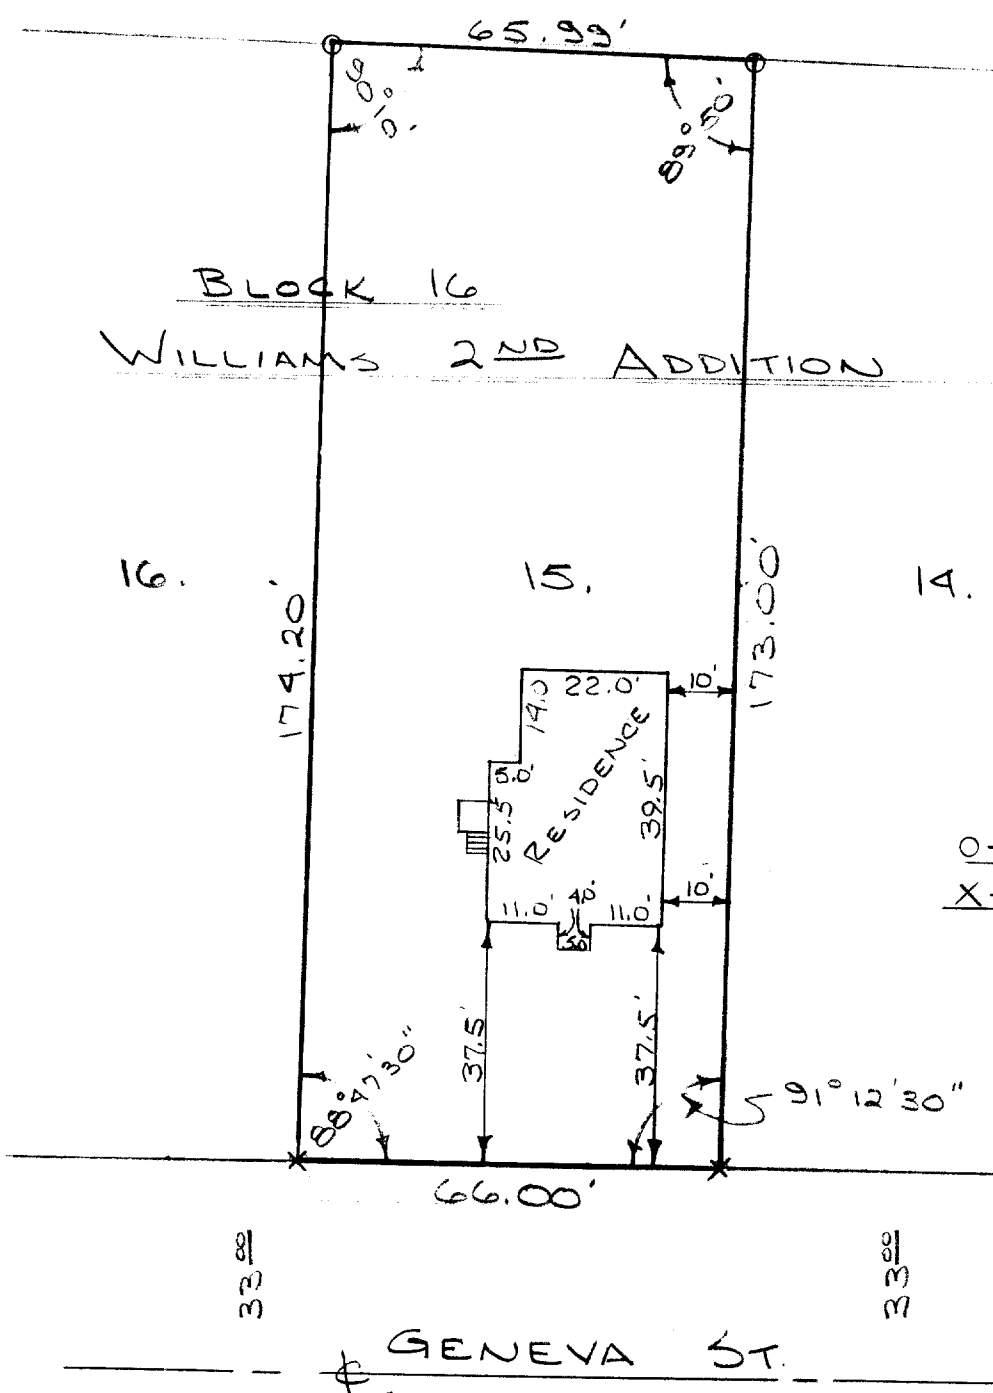

O-INDICATES IRON PIPE  
X-INDICATES CHISLED X

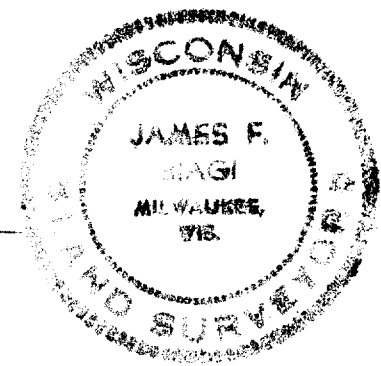

**DESCRIPTION:**  
All of Lot number Fifteen (15) in Block number Sixteen (16) of Williams 2nd Addition, to the Village of Williams Bay, Walworth County, Wisconsin.

**CERTIFICATE:**  
I, James F. Biagi, surveyor, do hereby certify that I have surveyed the lands hereon described.

July 24, 1972

*James F. Biagi*  
James F. Biagi RLS #272

woof-229

11-208