


SCALE - 1" = 20'
O = IRON PIPE

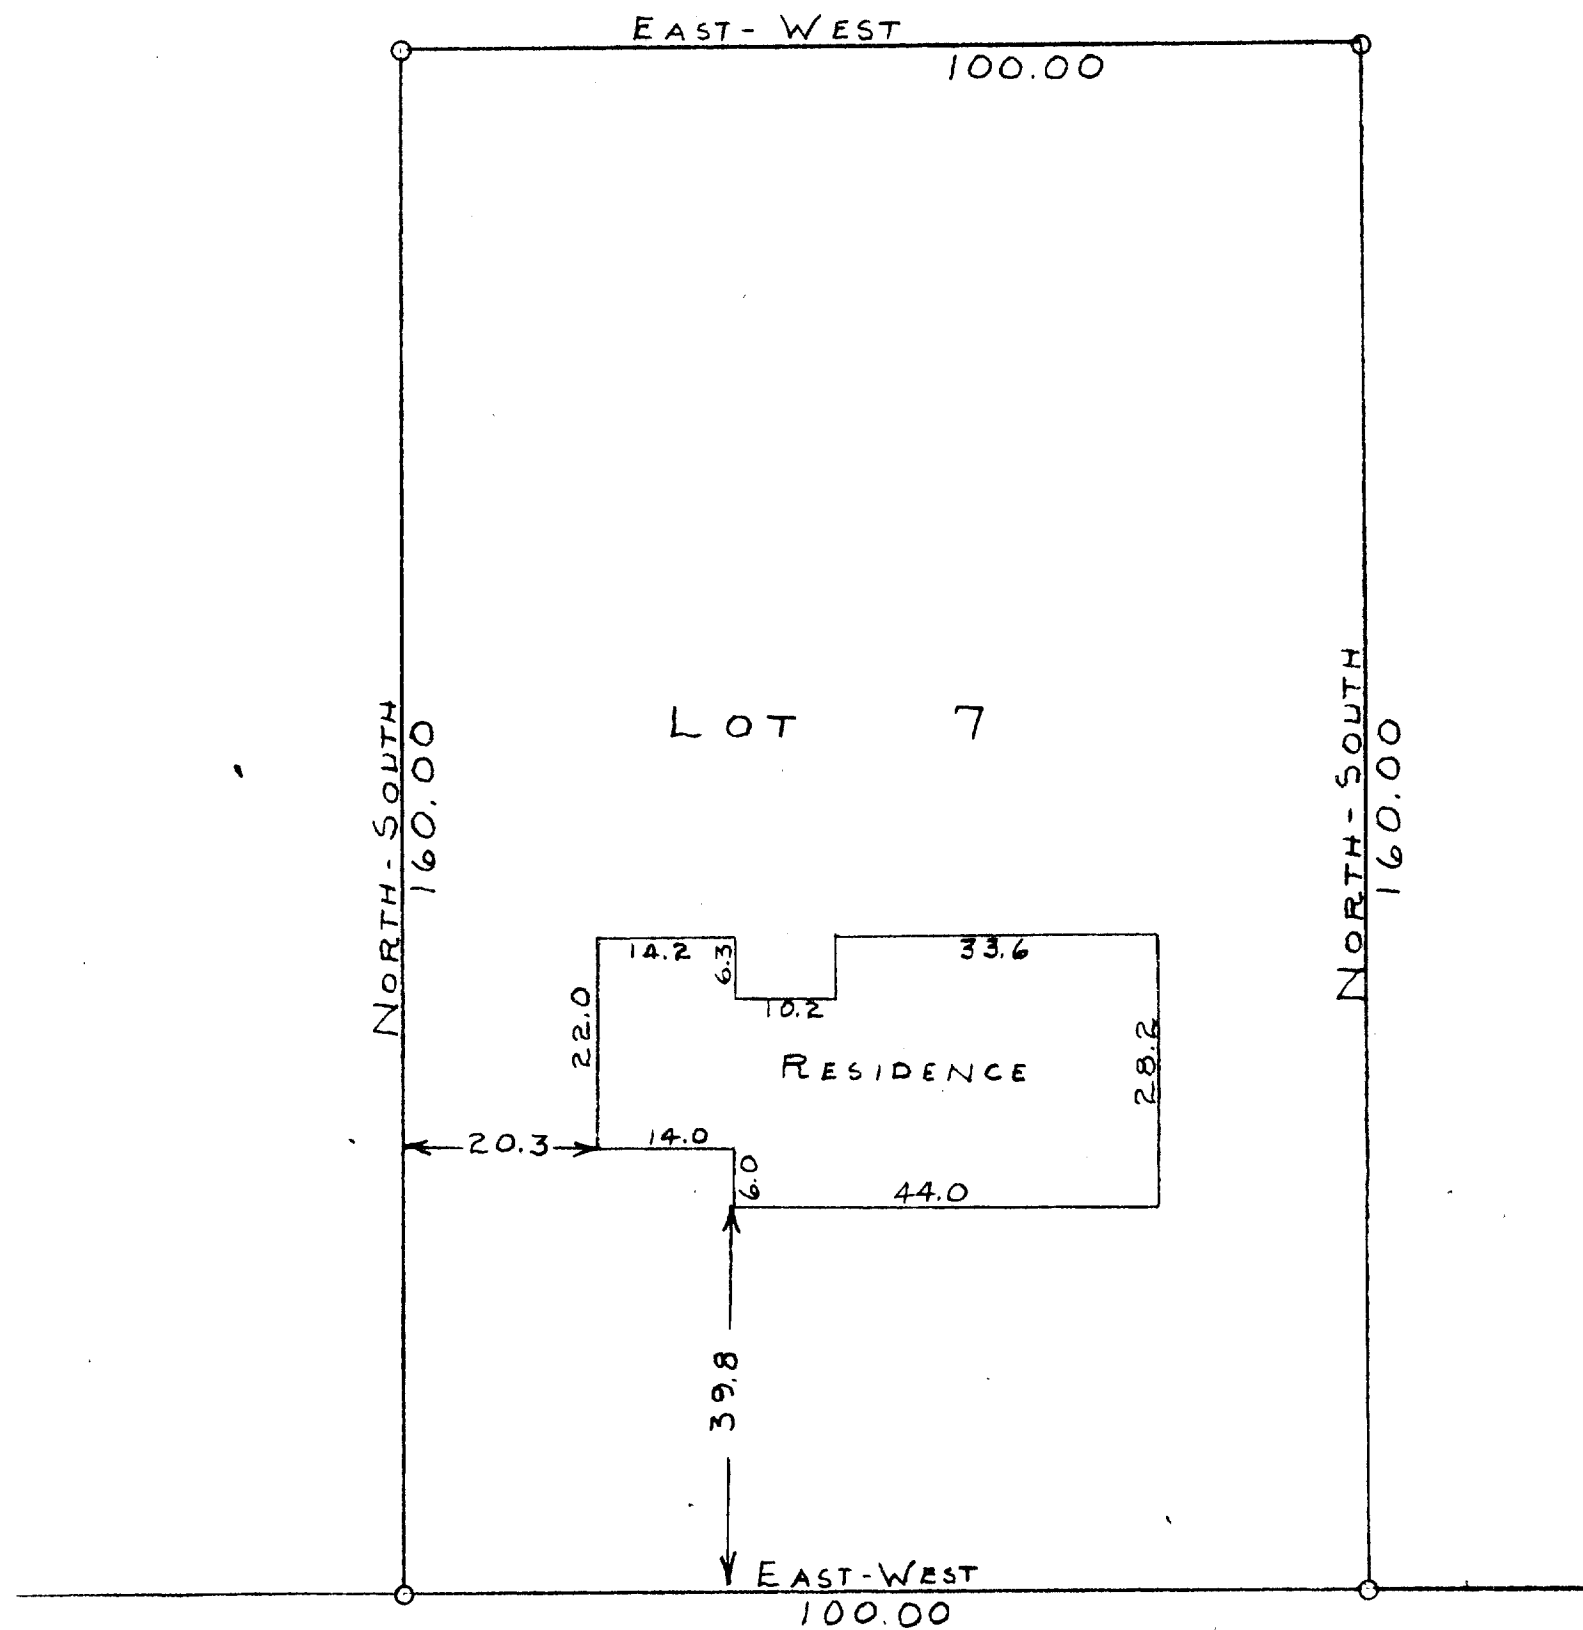

17' WIDE PARCEL DEDICATED FOR HIGHWAY R.O.W.

STATE HIGHWAY

No. 36

STATE OF WISCONSIN)
WALWORTH COUNTY)

I, GEORGE T. DUNHAM, DO HEREBY CERTIFY THAT I HAVE SURVEYED THE
PROPERTY DESCRIBED AS FOLLOWS:

LOT 7 OF BAYWOOD HEIGHTS SUBDIVISION LOCATED IN THE VILLAGE OF
WILLIAMS BAY, WALWORTH COUNTY, WISCONSIN

AND THAT THE PLAT SHOWN ABOVE IS A CORRECT REPRESENTATION OF THE PROPERTY
LINES AND OF THE IMPROVEMENTS LOCATED THEREON
MARCH 27, 1958

George T. Dunham
GEORGE T. DUNHAM, SURVEYOR
DELAVER, WISCONSIN 11-21

WBW-7