

11-212 J

1st 118 CEDAR POINT PAGE

2nd 118 CEDAR POINT PAGE

3rd 118 CEDAR POINT PAGE

4th 118 CEDAR POINT PAGE

5th 118 CEDAR POINT PAGE


6th 118 CEDAR POINT PAGE

7th 118 CEDAR POINT PAGE

8th 118 CEDAR POINT PAGE

9th 118 CEDAR POINT PAGE

10th 118 CEDAR POINT PAGE

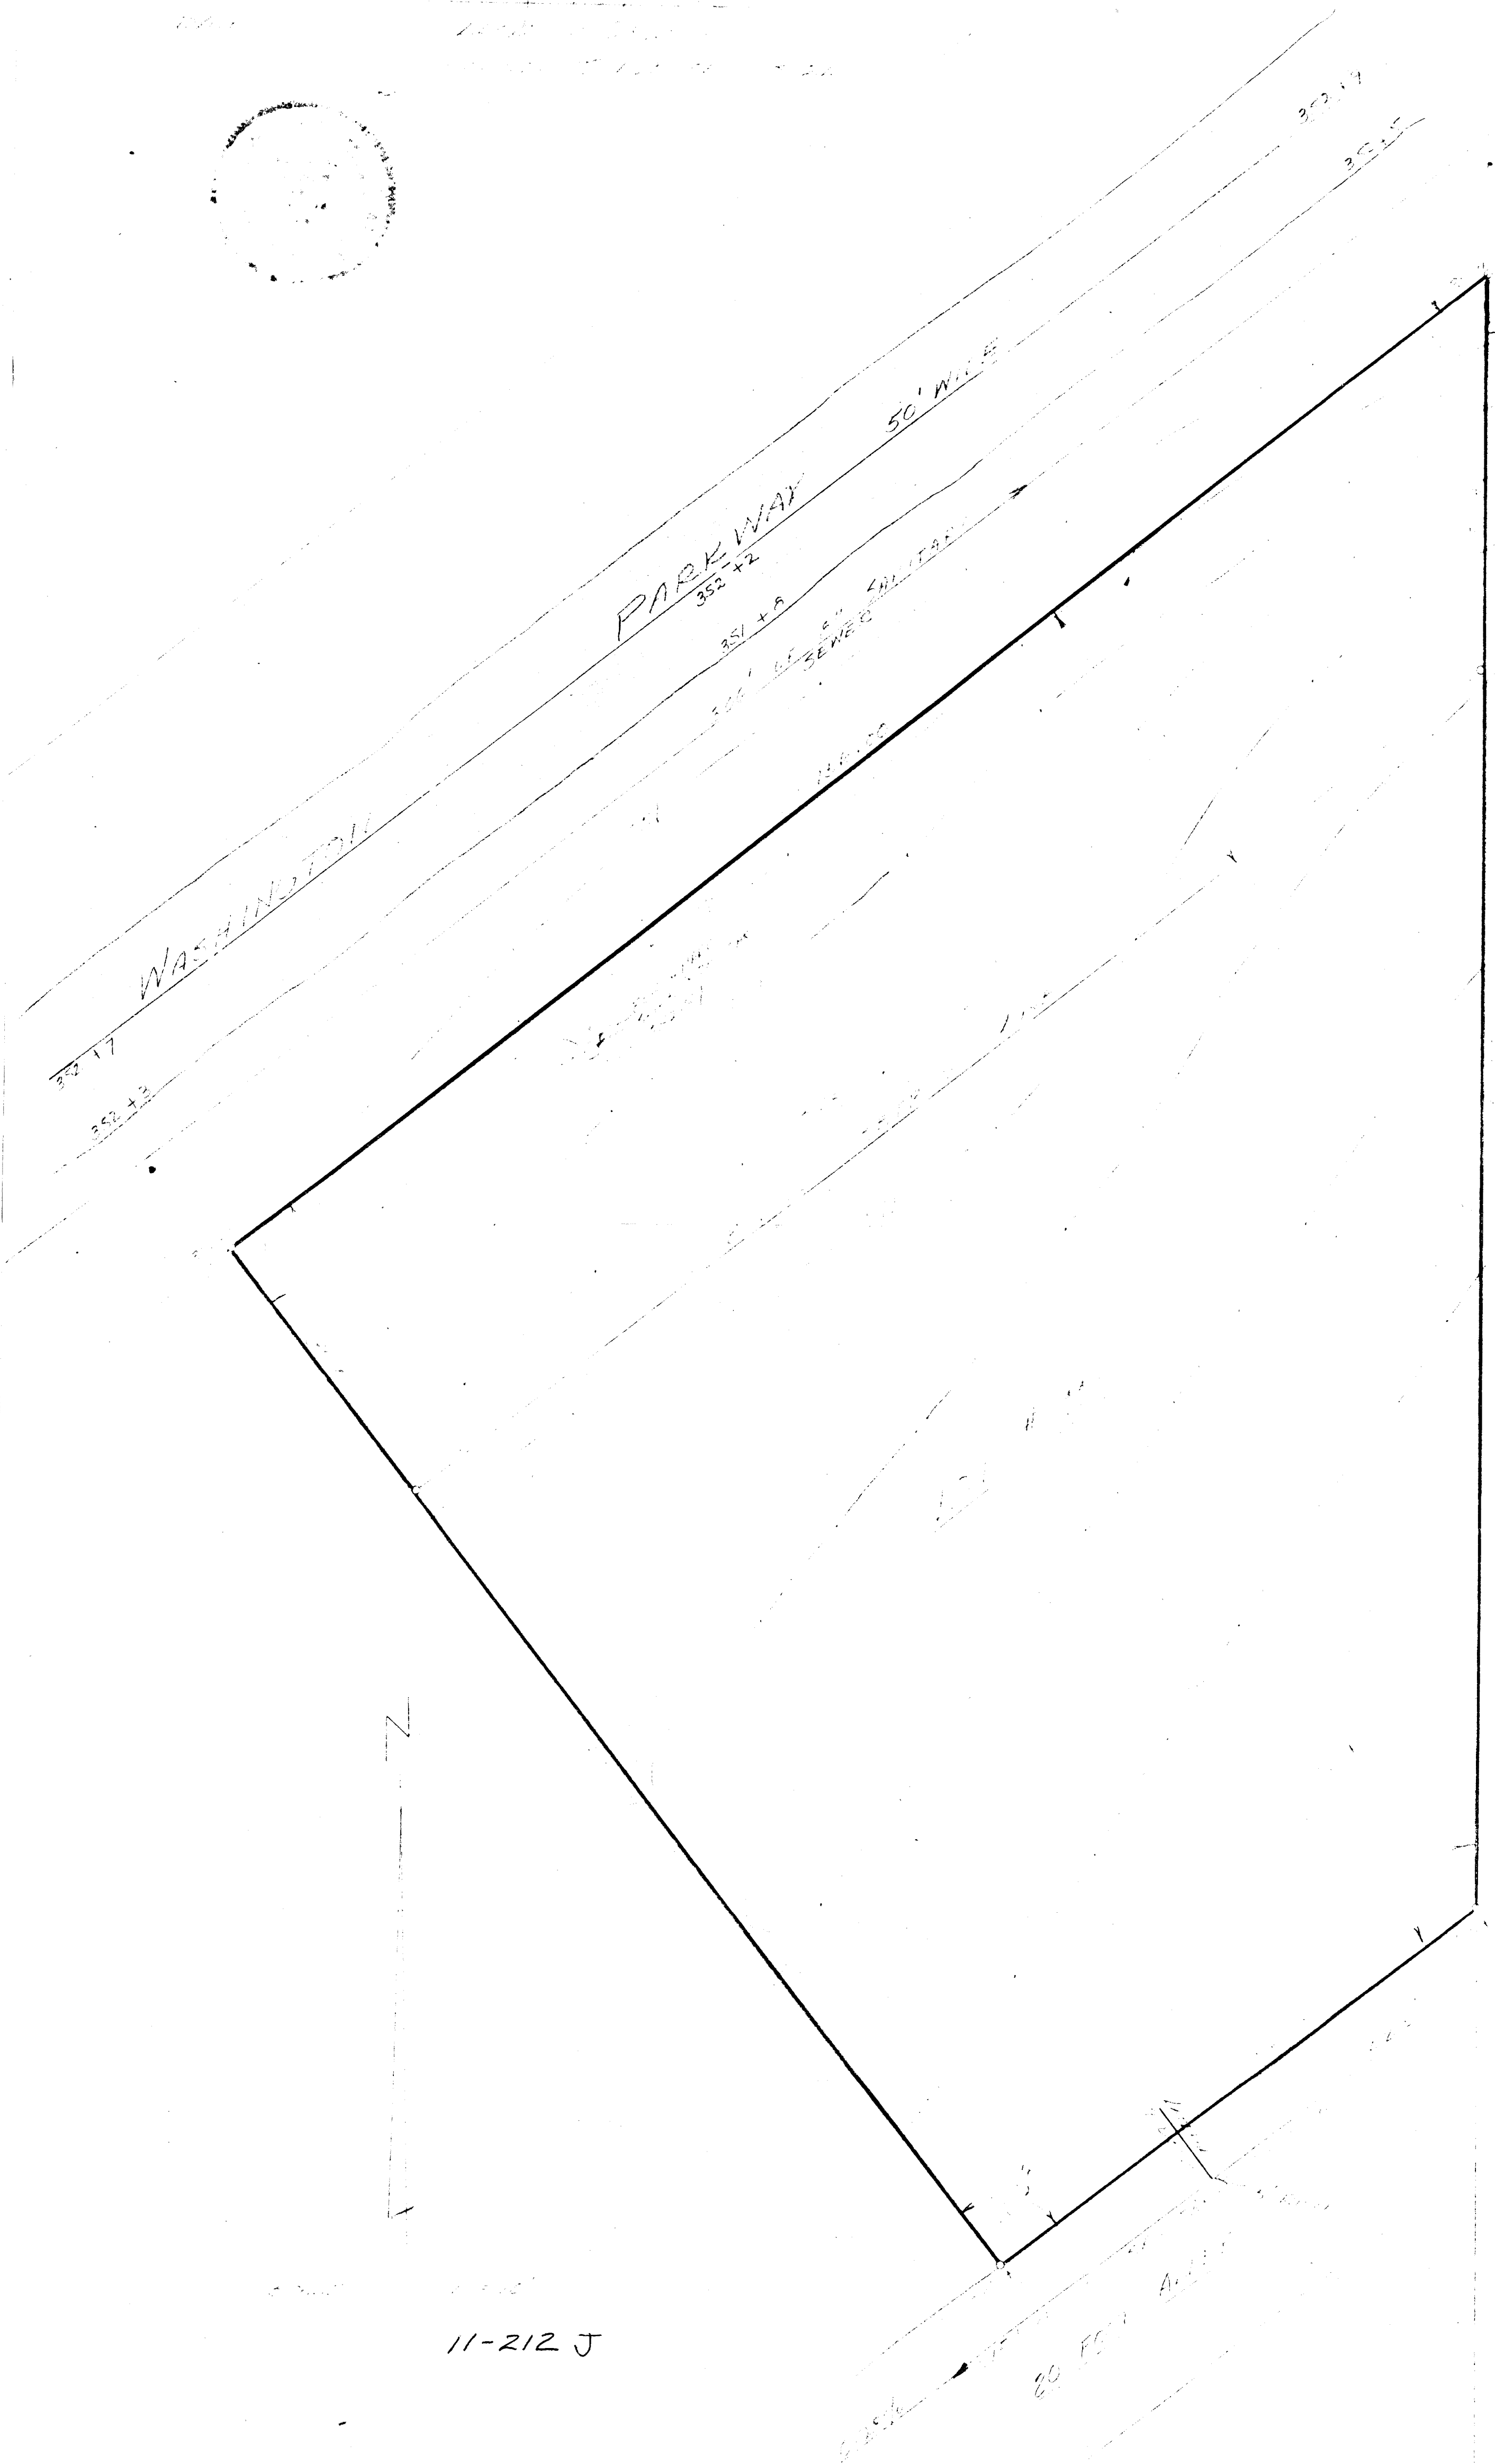

11-212 J