



Scale
1" = 30'

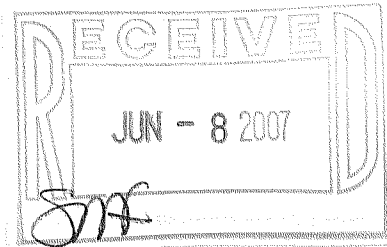

*
Verify exact number with
Village Engineering Department

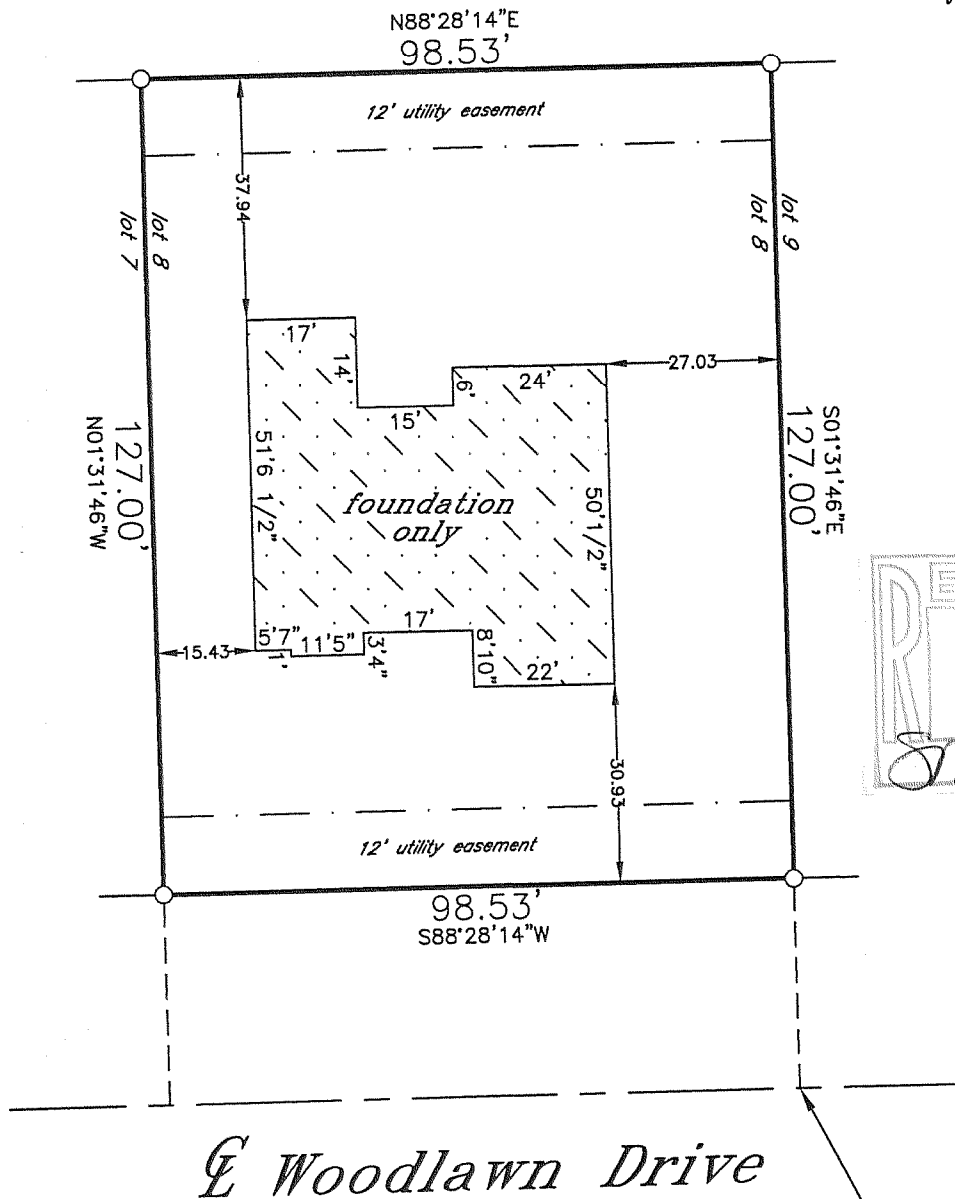

top of foundation
elevation = 1018.02


*
outside finish grade = EL 1017.00
(advisory only) - top of founda-
tion = EL 1017.75 (advisory only) un-
less otherwise determined in writ-
ing by Village Engineering Department

project BENCHMARK - paint spot
in center of pavement = 1015.38

denotes iron
pipe

*Proposed building field staked true size. Contractor to verify all dimensions be-
fore building by same and adhere to drainage plan in effect for this subdivision.
Refer to a current title report for easements or restrictions which may affect
the use of this site that are not shown on the recorded subdivision plat.*

J.K.R. SURVEYING, INC.
8121 22ND AVENUE
KENOSHA, WI 53143

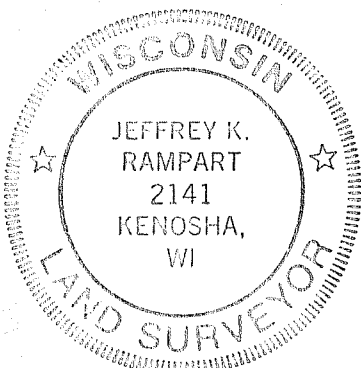

I hereby certify that
this property was
surveyed under my
direction and this
plat is a true re-
presentation thereof.

[Signature]

Reg. Land Surveyor

September 28, 2005
Revised 10/27/05

Plat of Survey of
LOT 8 BLOCK 2 IN
PRAIRIE VIEW

in NE1/4 Section 2-1-16

VILLAGE OF WILLIAMS BAY
WALWORTH COUNTY, WIS.

-for-
James Construction

WPDV-34

011-2139