




PLAT OF SURVEY
LOT 212 OF CEDAR POINT PARK 3rd ADDITION
LOCATED IN PART OF THE VILLAGE OF WILLIAMS BAY, WALWORTH COUNTY, WISCONSIN
TAX PARCEL WCP3 0001A

GENEVA
LAKE

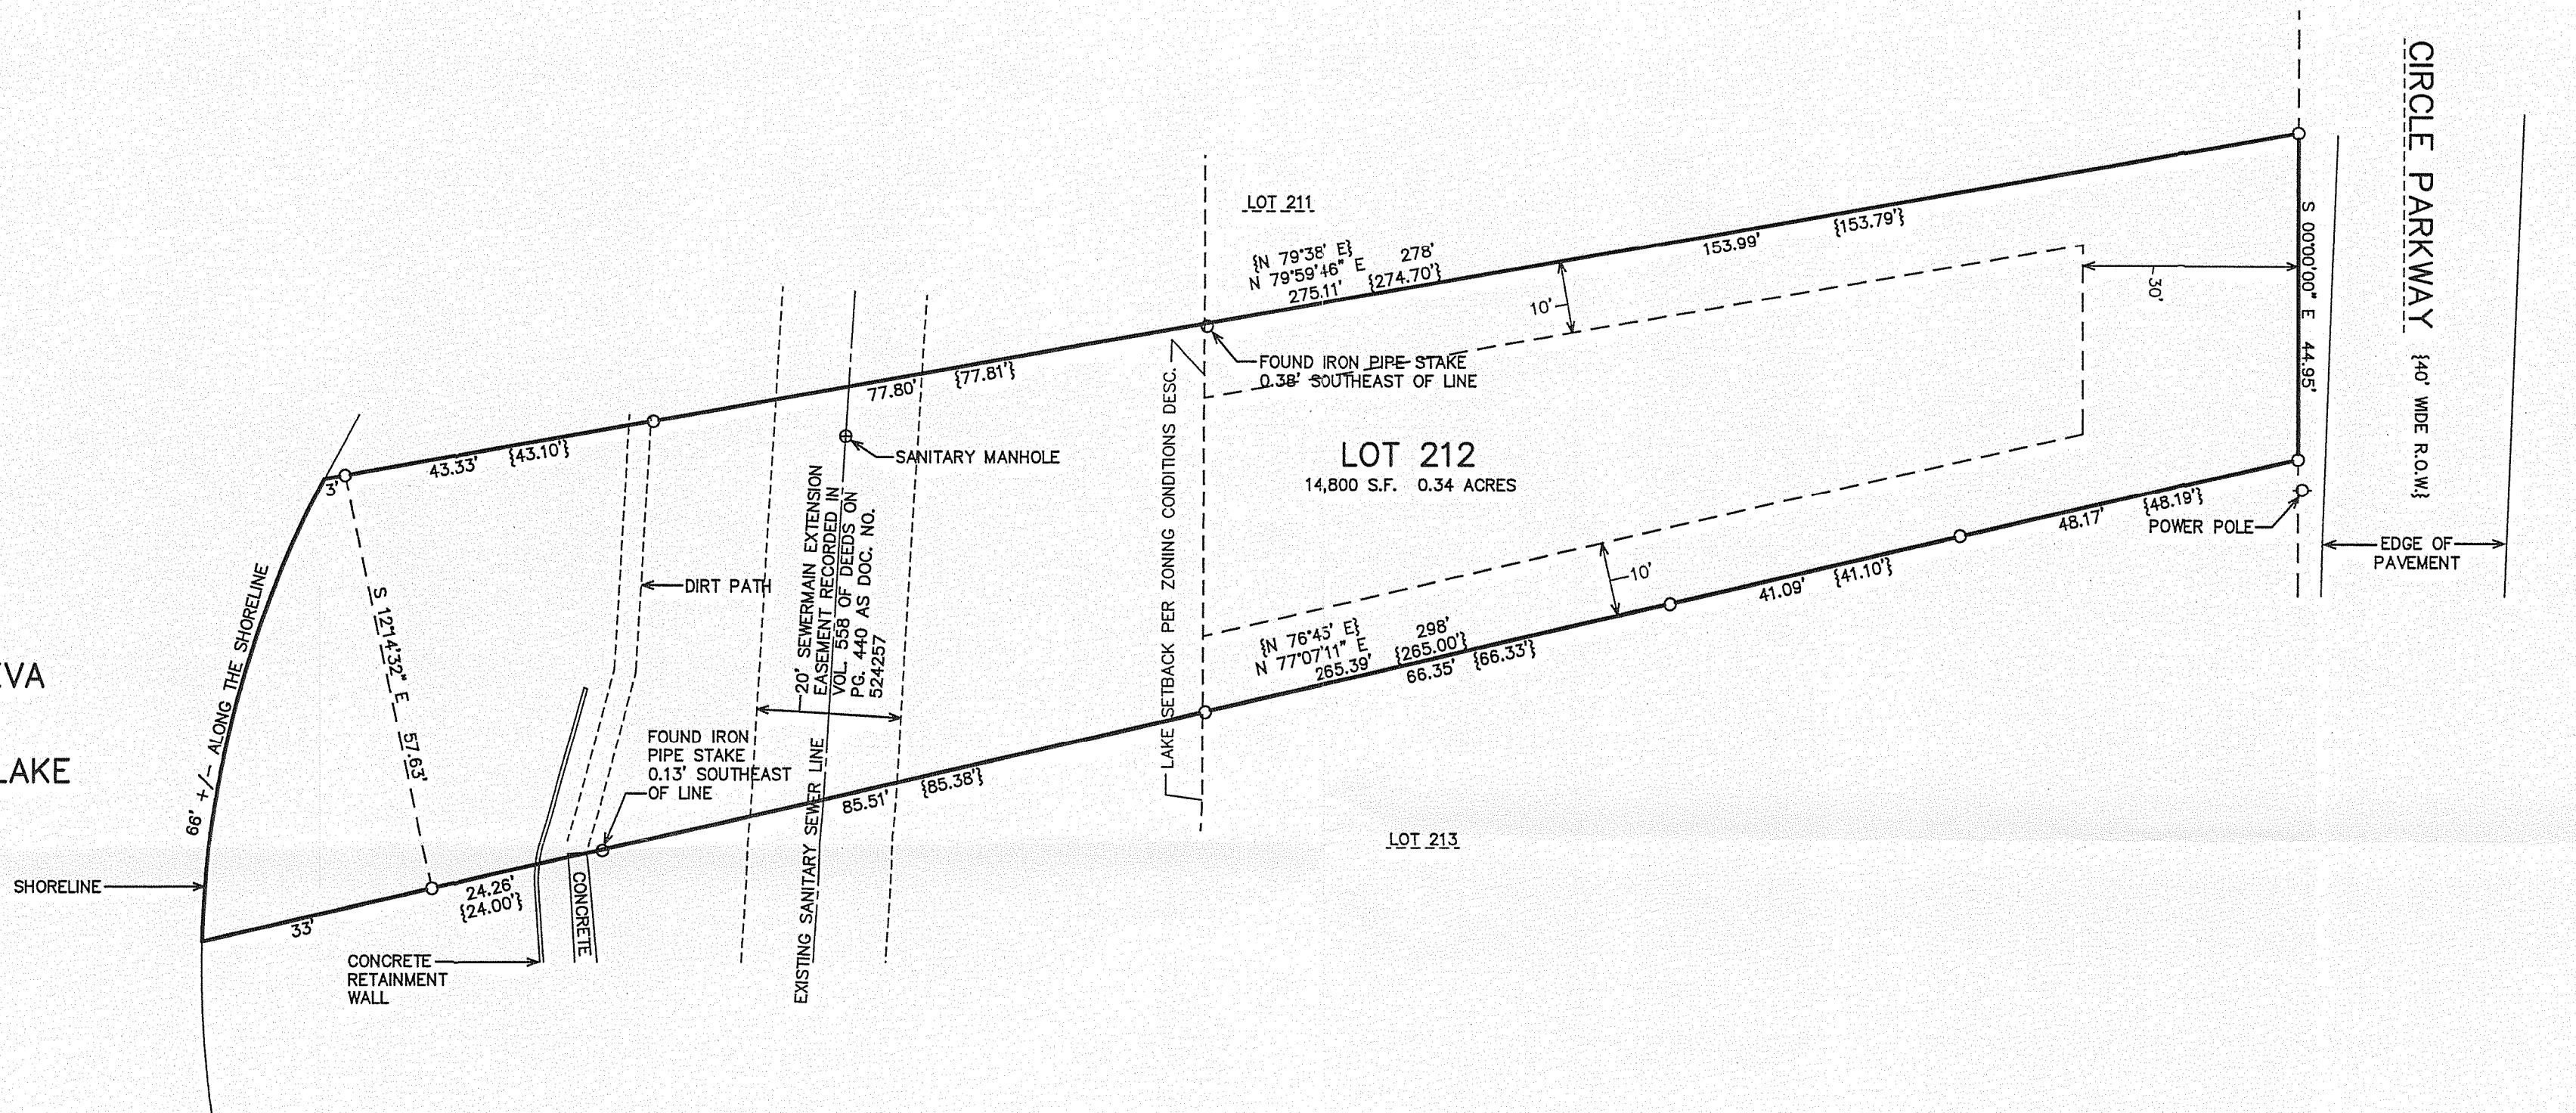

- LEGEND
- = FOUND IRON PIPE STAKE
 - = FOUND IRON REBAR STAKE
 - ✱ = SET SPIKE IN PAVEMENT
 - {XXX} = RECORDED AS

10 5 0 10 20 30 40 50 60 70 80 90 100
MAP SCALE IN FEET ORIGINAL 1" = 20'

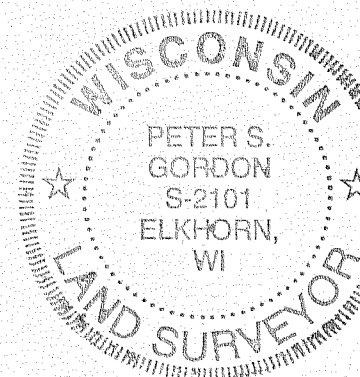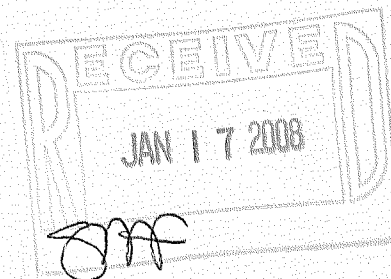

NOTES:


- 1.) WATERMAIN EASEMENT RECORDED IN VOL. 237 OF DEEDS ON PG. 161 AS DOC. NO. 310072 AND WISCONSIN SOUTHERN GAS COMPANY EASEMENT RECORDED IN VOL. 243 OF DEEDS ON PG. 516 AS DOC. NO. 316831 AND SEWERMAIN EXTENSION EASEMENT RECORDED IN VOL. 555 OF DEEDS ON PG. 447 AS DOC. NO. 521854 ALL GRANT TO RIGHT TO INSTALL AND MAINTAIN UTILITIES WITHIN THE PUBLIC RIGHT OF WAYS.
- 2.) EASEMENT RECORDED IN VOL. 484 OF DEEDS ON PG. 601 AS DOC. NO. 472344 DESCRIBES AN EASEMENT ACROSS LOT 203 AND 204 AND DOES NOT AFFECT PROJECT PARCEL.
- 3.) EASEMENT FOR SEWER AND MAIN EXTENSION AS SET FORTH IN DOC. NO. 526072 (SUPPOSE TO BE VOL. 559 OF DEEDS ON PG. 527 AS DOC. NO. 525072) DESCRIBES AN EASEMENT AND RIGHT OF WAY ACROSS LOT 203 AND DOES NOT AFFECT PROJECT PARCEL.

NOTE: COPIES OF THIS MAP TO WHICH THE FOLLOWING CERTIFICATE WILL APPLY SHOW THE SURVEYOR'S ORIGINAL SEAL AND SIGNATURE IN RED INK. COPIES BY ANY OTHER MEANS MAY HAVE ALTERATIONS WHICH DO NOT REPRESENT THE SURVEYOR'S WORK PRODUCT.

I HEREBY CERTIFY THAT THE ABOVE DESCRIBED PROPERTY HAS BEEN SURVEYED UNDER MY DIRECTION AND THAT THE ABOVE MAP IS A TRUE REPRESENTATION THEREOF AND SHOWS THE SIZE AND LOCATION OF THE PROPERTY, ITS EXTERIOR BOUNDARIES, THE LOCATION OF ALL VISIBLE STRUCTURES, AND DIMENSIONS OF ALL PRINCIPLE BUILDINGS THEREON, BOUNDARY FENCES, APPARENT EASEMENTS, ROADWAYS, AND VISIBLE ENCROACHMENTS, IF ANY. THIS SURVEY IS MADE FOR THE USE OF THE PRESENT OWNERS OF THE PROPERTY, AND ALSO THOSE WHO PURCHASE, MORTGAGE, OR GUARANTEE THE TITLE THERETO WITHIN ONE YEAR FROM THE DATE HEREOF.

DATED: JANUARY 4, 2008

PETER S. GORDON

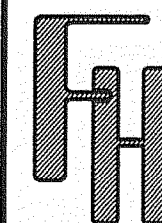

WORK ORDERED BY -
SFLG HOLDINGS, LLC
C/O KEEFE REAL ESTATE, INC.
LAKE GENEVA
WISCONSIN

FARRIS, HANSEN & ASSOCIATES, INC.
ENGINEERING - ARCHITECTURE - SURVEYING
7 RIDGWAY COURT P.O. BOX 437
ELKHORN, WISCONSIN 53121
OFFICE: (262) 723-2098 FAX: (262) 723-5886

REVISIONS

PROJECT NO.
7482
DATE:
11/14/2007
SHEET NO.
1 OF 1

X:\Projects\7482\Docd\SURVEY\LOT212_20071121

WCP3-11A

011-2192