


FARRIS, HANSEN & ASSOCIATES, INC.
 ENGINEERING - ARCHITECTURE - SURVEYING
 7 RIDGWAY COURT - P.O. BOX 437 - ELKHORN, WISCONSIN 53121
 PHONE: (262) 723-2098 FAX: (262) 723-5886

-WORK ORDERED BY-
 SUMMER HAVEN SUBDIVISION ASSOCIATION
 P. O. BOX 1092
 WILLIAMS BAY, WISCONSIN 53191

LEGEND
 ●-FOUND IRON REBAR STAKE
 ○-FOUND IRON PIPE STAKE
 (XXX)-RECORDED AS


ASSIGNED THE WEST LINE OF STUYVESANT PARK
 NORTH

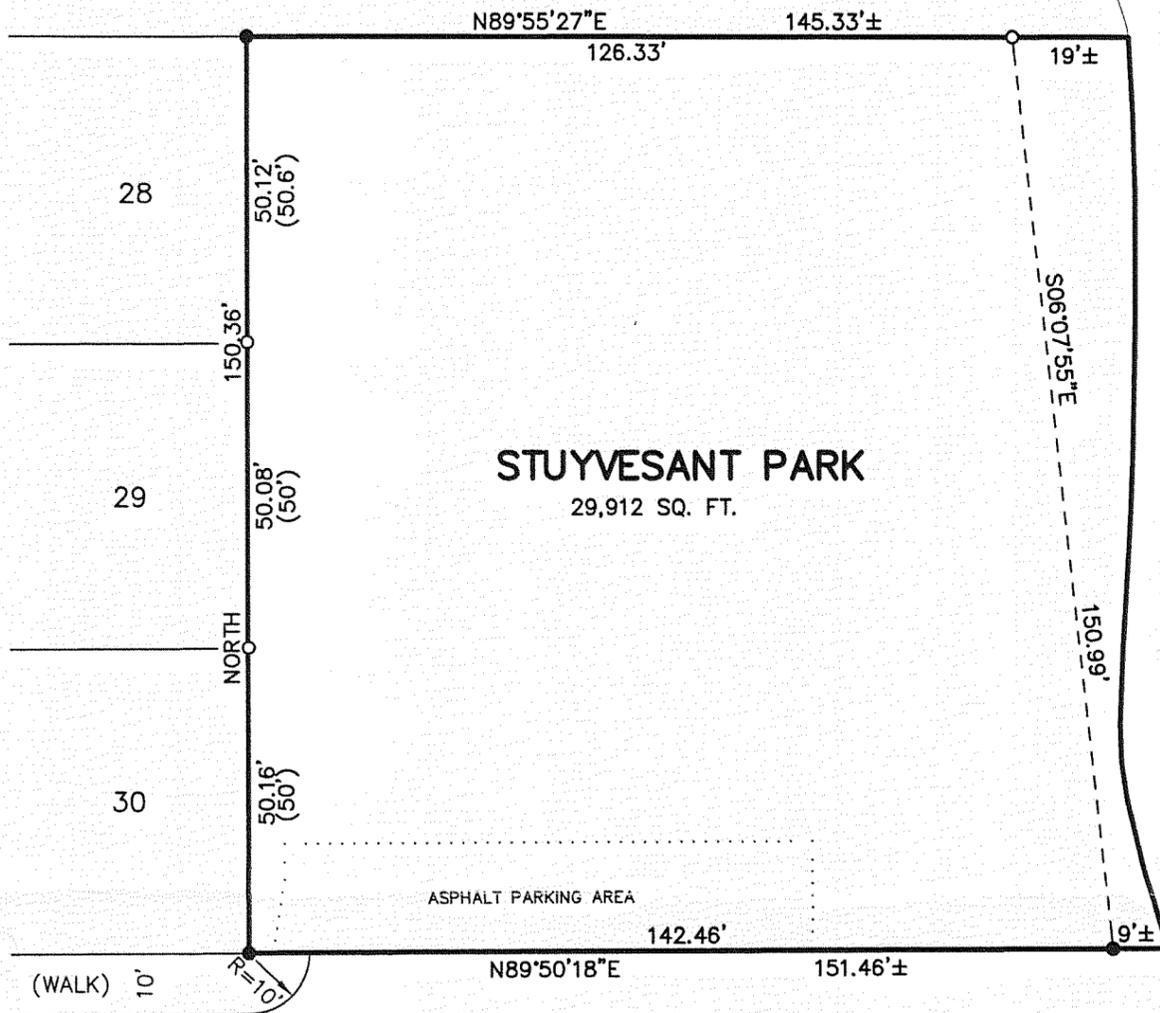

TO LIECHTY DRIVE

BUILDING

PLAT OF SURVEY OF
 STUYVESANT PARK, BEING PART OF SUMMER HAVEN
 SUBDIVISION, LOCATED IN PART OF THE SW 1/4 OF
 SECTION 6, TOWN 1 NORTH, RANGE 17 EAST, VILLAGE OF
 WILLIAMS BAY, WALWORTH COUNTY, WISCONSIN

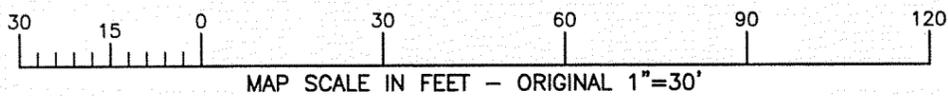

NOTE: COPIES OF THIS MAP TO WHICH THE FOLLOWING CERTIFICATE WILL APPLY SHOW THE SURVEYOR'S ORIGINAL SEAL AND SIGNATURE IN RED INK. COPIES BY ANY OTHER MEANS MAY HAVE ALTERATIONS WHICH DO NOT REPRESENT THE SURVEYOR'S WORK PRODUCT. I HEREBY CERTIFY THAT THE ABOVE DESCRIBED PROPERTY HAS BEEN SURVEYED UNDER MY DIRECTION AND THAT THE ABOVE MAP IS A TRUE REPRESENTATION THEREOF AND SHOWS THE SIZE AND LOCATION OF THE PROPERTY AND ITS EXTERIOR BOUNDARIES. THIS SURVEY IS MADE FOR THE USE OF THE PRESENT OWNERS OF THE PROPERTY, AND ALSO THOSE WHO PURCHASE, MORTGAGE, OR GUARANTEE THE TITLE THERETO WITHIN ONE YEAR FROM THE DATE HEREOF.

DATED: 1/21/2008

Peter S. Gordon
 PETER S. GORDON

PROJECT: 7536
 DATE: 01/21/2008
 SHEET 1 OF 1

WSU - 50

011-2195

JAN 21 2008