


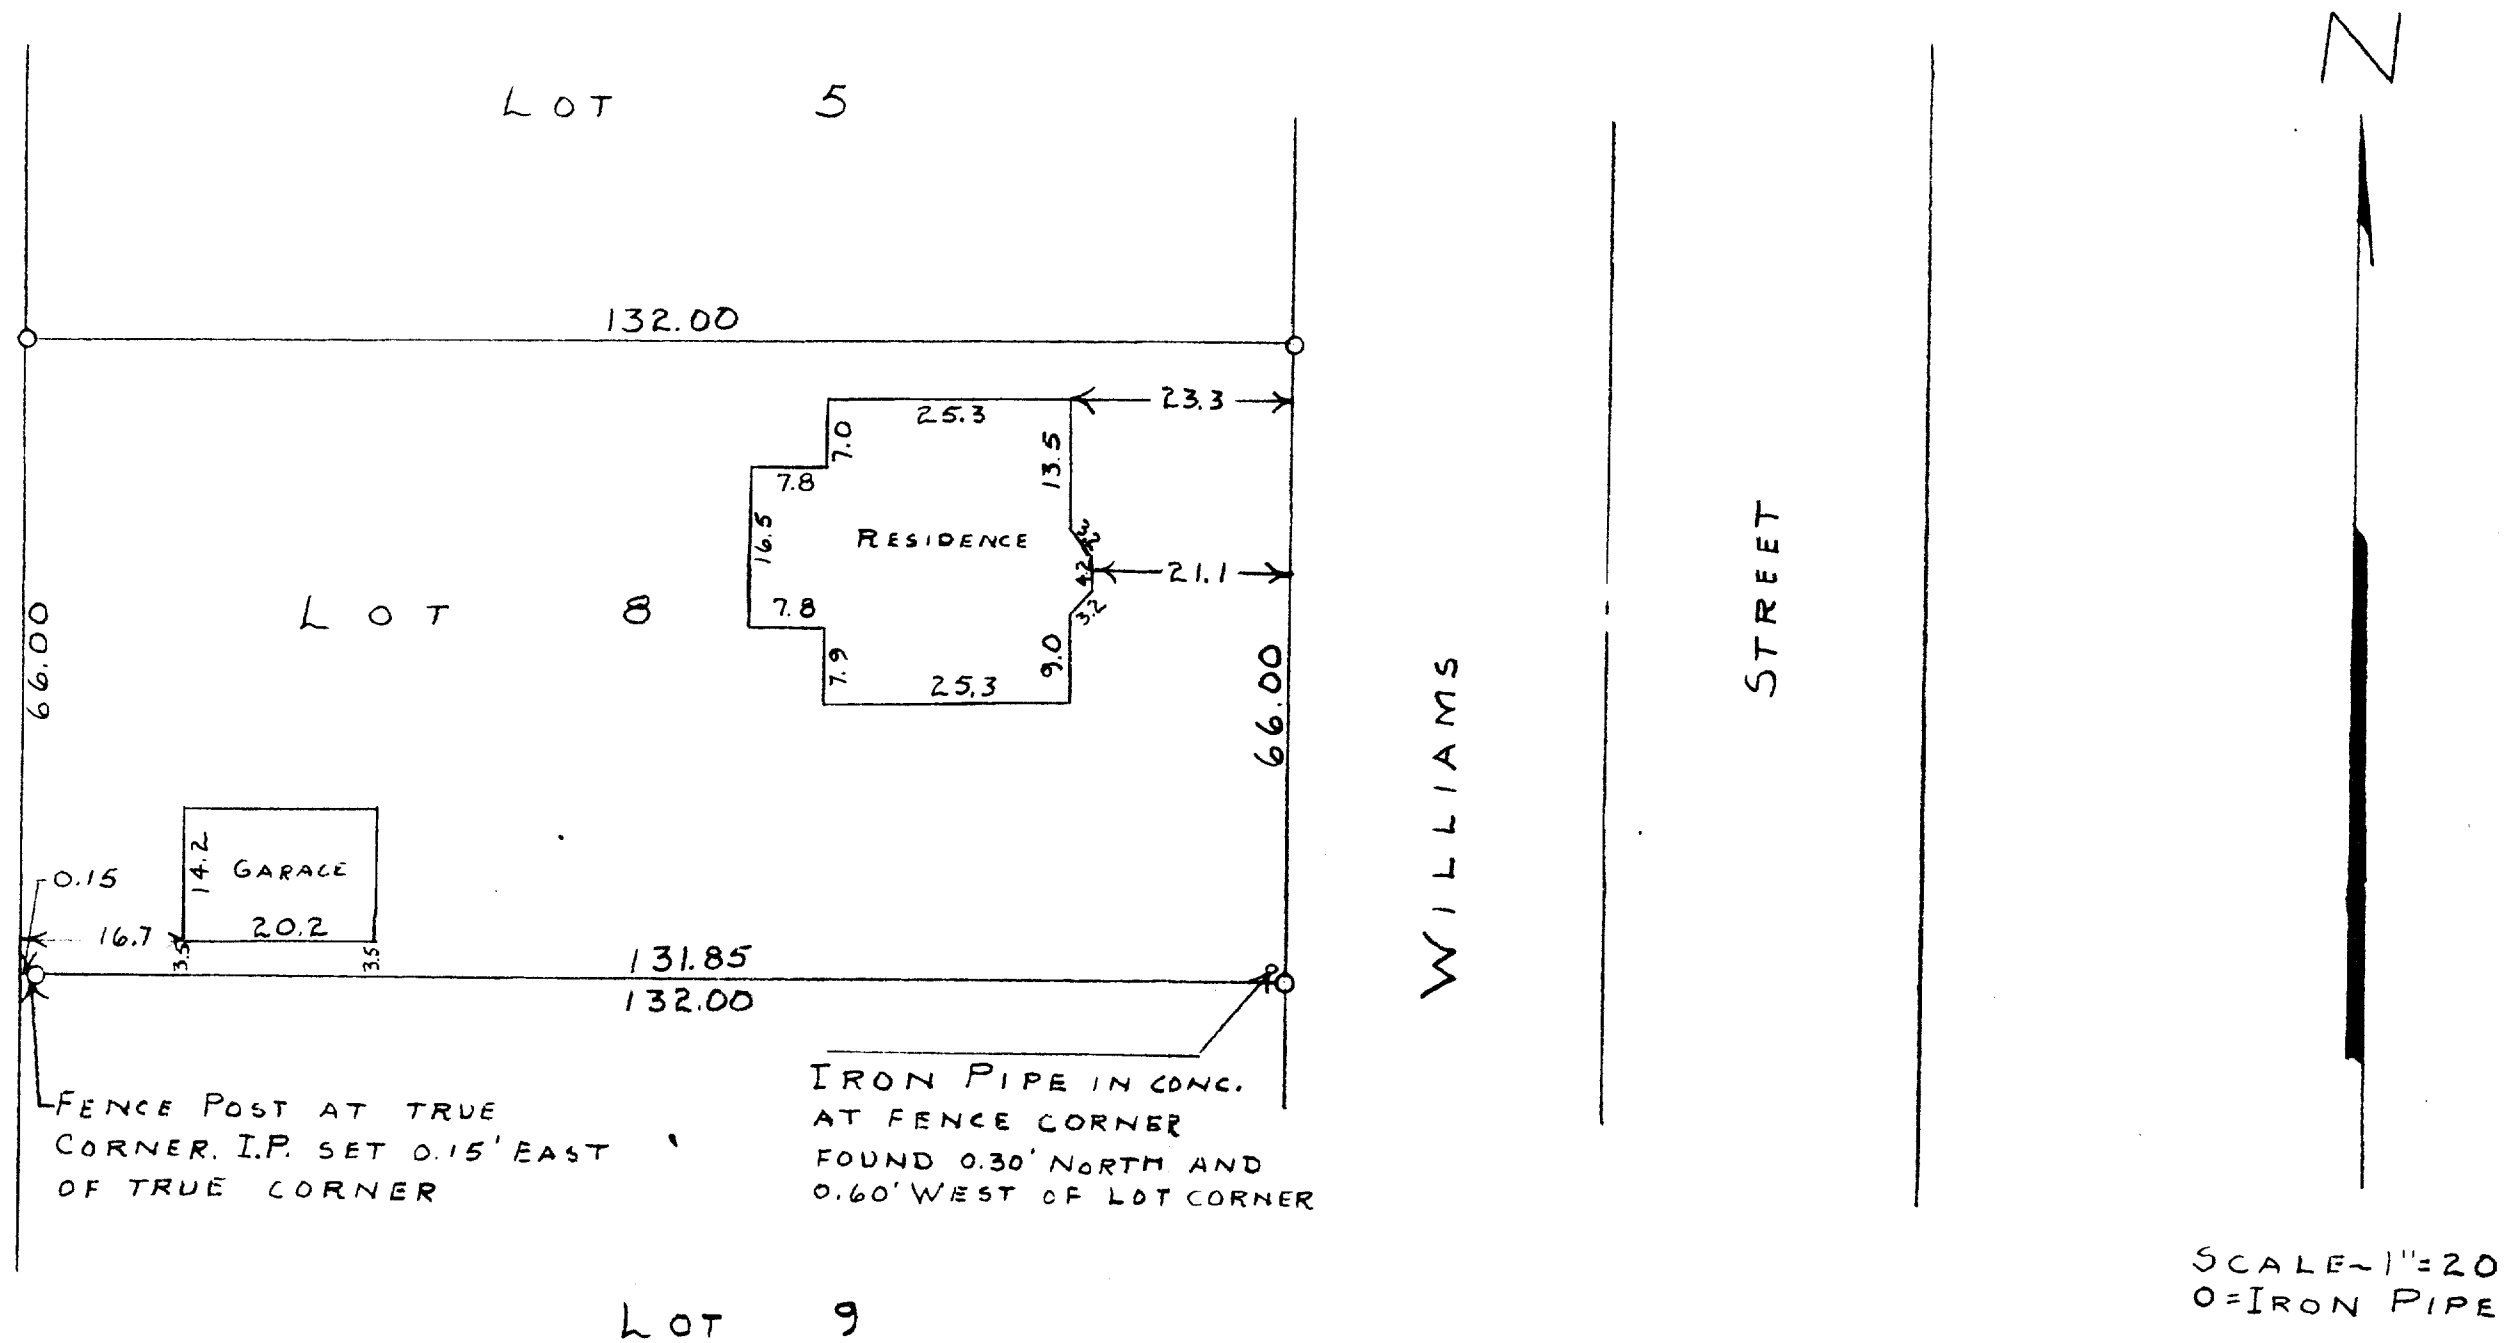

STATE OF WISCONSIN)
 WALWORTH COUNTY)

I, GEORGE T. DUNHAM, DO HEREBY CERTIFY THAT I HAVE SURVEYED
 THE PROPERTY DESCRIBED AS FOLLOWS:

LOT 8, BLOCK 9, WILLIAMS SECOND ADDITION TO WILLIAMS
 BAY LOCATED IN THE VILLAGE OF WILLIAMS BAY, WALWORTH
 COUNTY, WISCONSIN.

AND THAT THE PLAT SHOWN ABOVE IS A CORRECT REPRESENTATION OF THE
 PROPERTY LINES AND OF THE IMPROVEMENTS LOCATED THEREON.
 OCT. 22, 1957

George T. Dunham
 GEORGE T. DUNHAM, SURVEYOR
 DELAVAN, WISCONSIN

11-22