

Plat of Survey



of

A parcel of land described in a Sheriff's Deed recorded November 7, 1989 in Vol. 472 on Page 148 as Document No. 186102, as shown below:

A portion of Lot 5 in the Observatory Subdivision located in the Village of Williams Bay, Wisconsin in the Southwest quarter of Section 1, Town 1 North, Range 16 East, of the fourth p.m. said subdivision being recorded in Register of Deeds Office, Walworth County, Wisconsin, November 29, 1895 in Volume 6 of Plats on page 102 and 103; said portion being included within the following boundary lines: beginning at an iron pipe 15 feet North of the Southeast corner of Lot 5 in the Observatory Subdivision, thence North 0 degrees 15' West 257 feet on the East line of Lot 5 to an iron pipe which is the place of beginning, thence North 0 degrees 57' West 65 feet to an iron pipe, thence South 86 degrees 48' West 122.25 feet to an iron pipe, thence South 0 degrees 57' East along the Eastern boundary of the public highway 65 feet thence North 86 degrees 48' East 122.25 feet to the place of beginning.

Said property is located in the Village of Williams Bay, County of Walworth, State of Wisconsin, and more commonly known as 33 Parkhurst Place.

Surveyed for: Pat Byrnes
33 Parkhurst Place
Williams Bay, Wisconsin. 53191

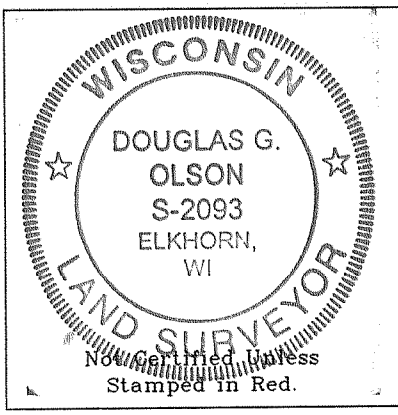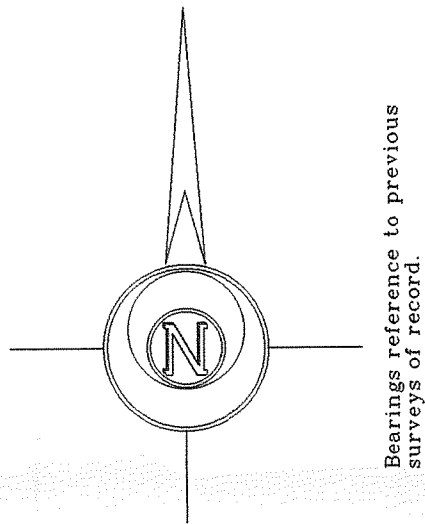


Notes: 1) This survey plat is not certified unless signed and sealed in red ink.
2) This survey is subject to Wisconsin lien laws. This Plat of Survey is the notice of intent to file lien. Lien waiver required.

Copyright © 2008 by Jensen & Olson Land Surveying, LLC.

All rights reserved. No part of this survey plat may be reproduced or transmitted in any form by any means - graphic, electronic, or mechanical, including photocopying, tracing, or information storage and retrieval systems - without permission in writing from Douglas G. Olson, Jensen & Olson Land Surveying, LLC.

I hereby certify that I have surveyed the above described property and the map hereon is correct to the best of my professional knowledge and belief and shows the size and location of the property, its exterior boundaries, the location and dimensions of all visible structures thereon, boundary fences, apparent easements and roadways and visible encroachments, if any.
This survey is made for the exclusive use of the present owners of property, and also those who purchase, mortgage or guarantee title thereto, within one year from the date hereof.

Douglas G. Olson
Wisconsin Registered Land Surveyor - 2093

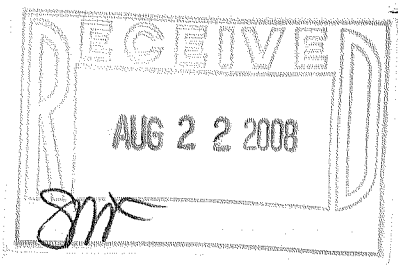

Geneva Street - State Trunk Highway 67

Parkhurst Place (40' Wide)

Tax Parcel
WGT 00020

Tax Parcel
WGT 00017

Tax Parcel
WOB 00016

Tax Parcel
WOB 00015

Tax Parcel
WOB 00017

Tax Parcel
WOB 00007
0.362 Acre
15,770 Sq.Ft.
Vol. 629, Page 4035.
Doc. No. 281894.

Tax Parcel
WOB 00008
Doc. No. 687619

Tax Parcel
WOB 00010
0.182 Acre
7,929 Sq.Ft.

Tax Parcel
WGT 00016

Tax Parcel
WOB 00011
Vol. 505, Page 904.
Doc. No. 203904.

West 1/4 Corner
Section 1-1-16.
N. 212.780.78
E. 2.387.747.72

Center 1/4 Corner
Section 1-1-16.
N. 212.908.54
E. 2.396.396.76

2008.076

Sheet 1 of 1 Sheets.

Job Reference Number

2008.076

Legend

- Found County Section Corner
- Found Iron Pipe
- Found Iron Rod
- Set Iron Rod
- Recorded Information
- Manhole
- Utility Pole
- Asphalt Surface
- Concrete Surface
- Gravel Surface



Jensen & Olson Land Surveying, LLC

45 South Wisconsin Street P.O. Box 322
Elkhorn, Wisconsin. 53121
Telephone: (262) 723-3434
Facsimile: (262) 723-8044

Scale in Feet

1" = 20'



Survey date: June 27, 2008.
Revisions:

WOB-7 WOB-10

011-2221