


2-11

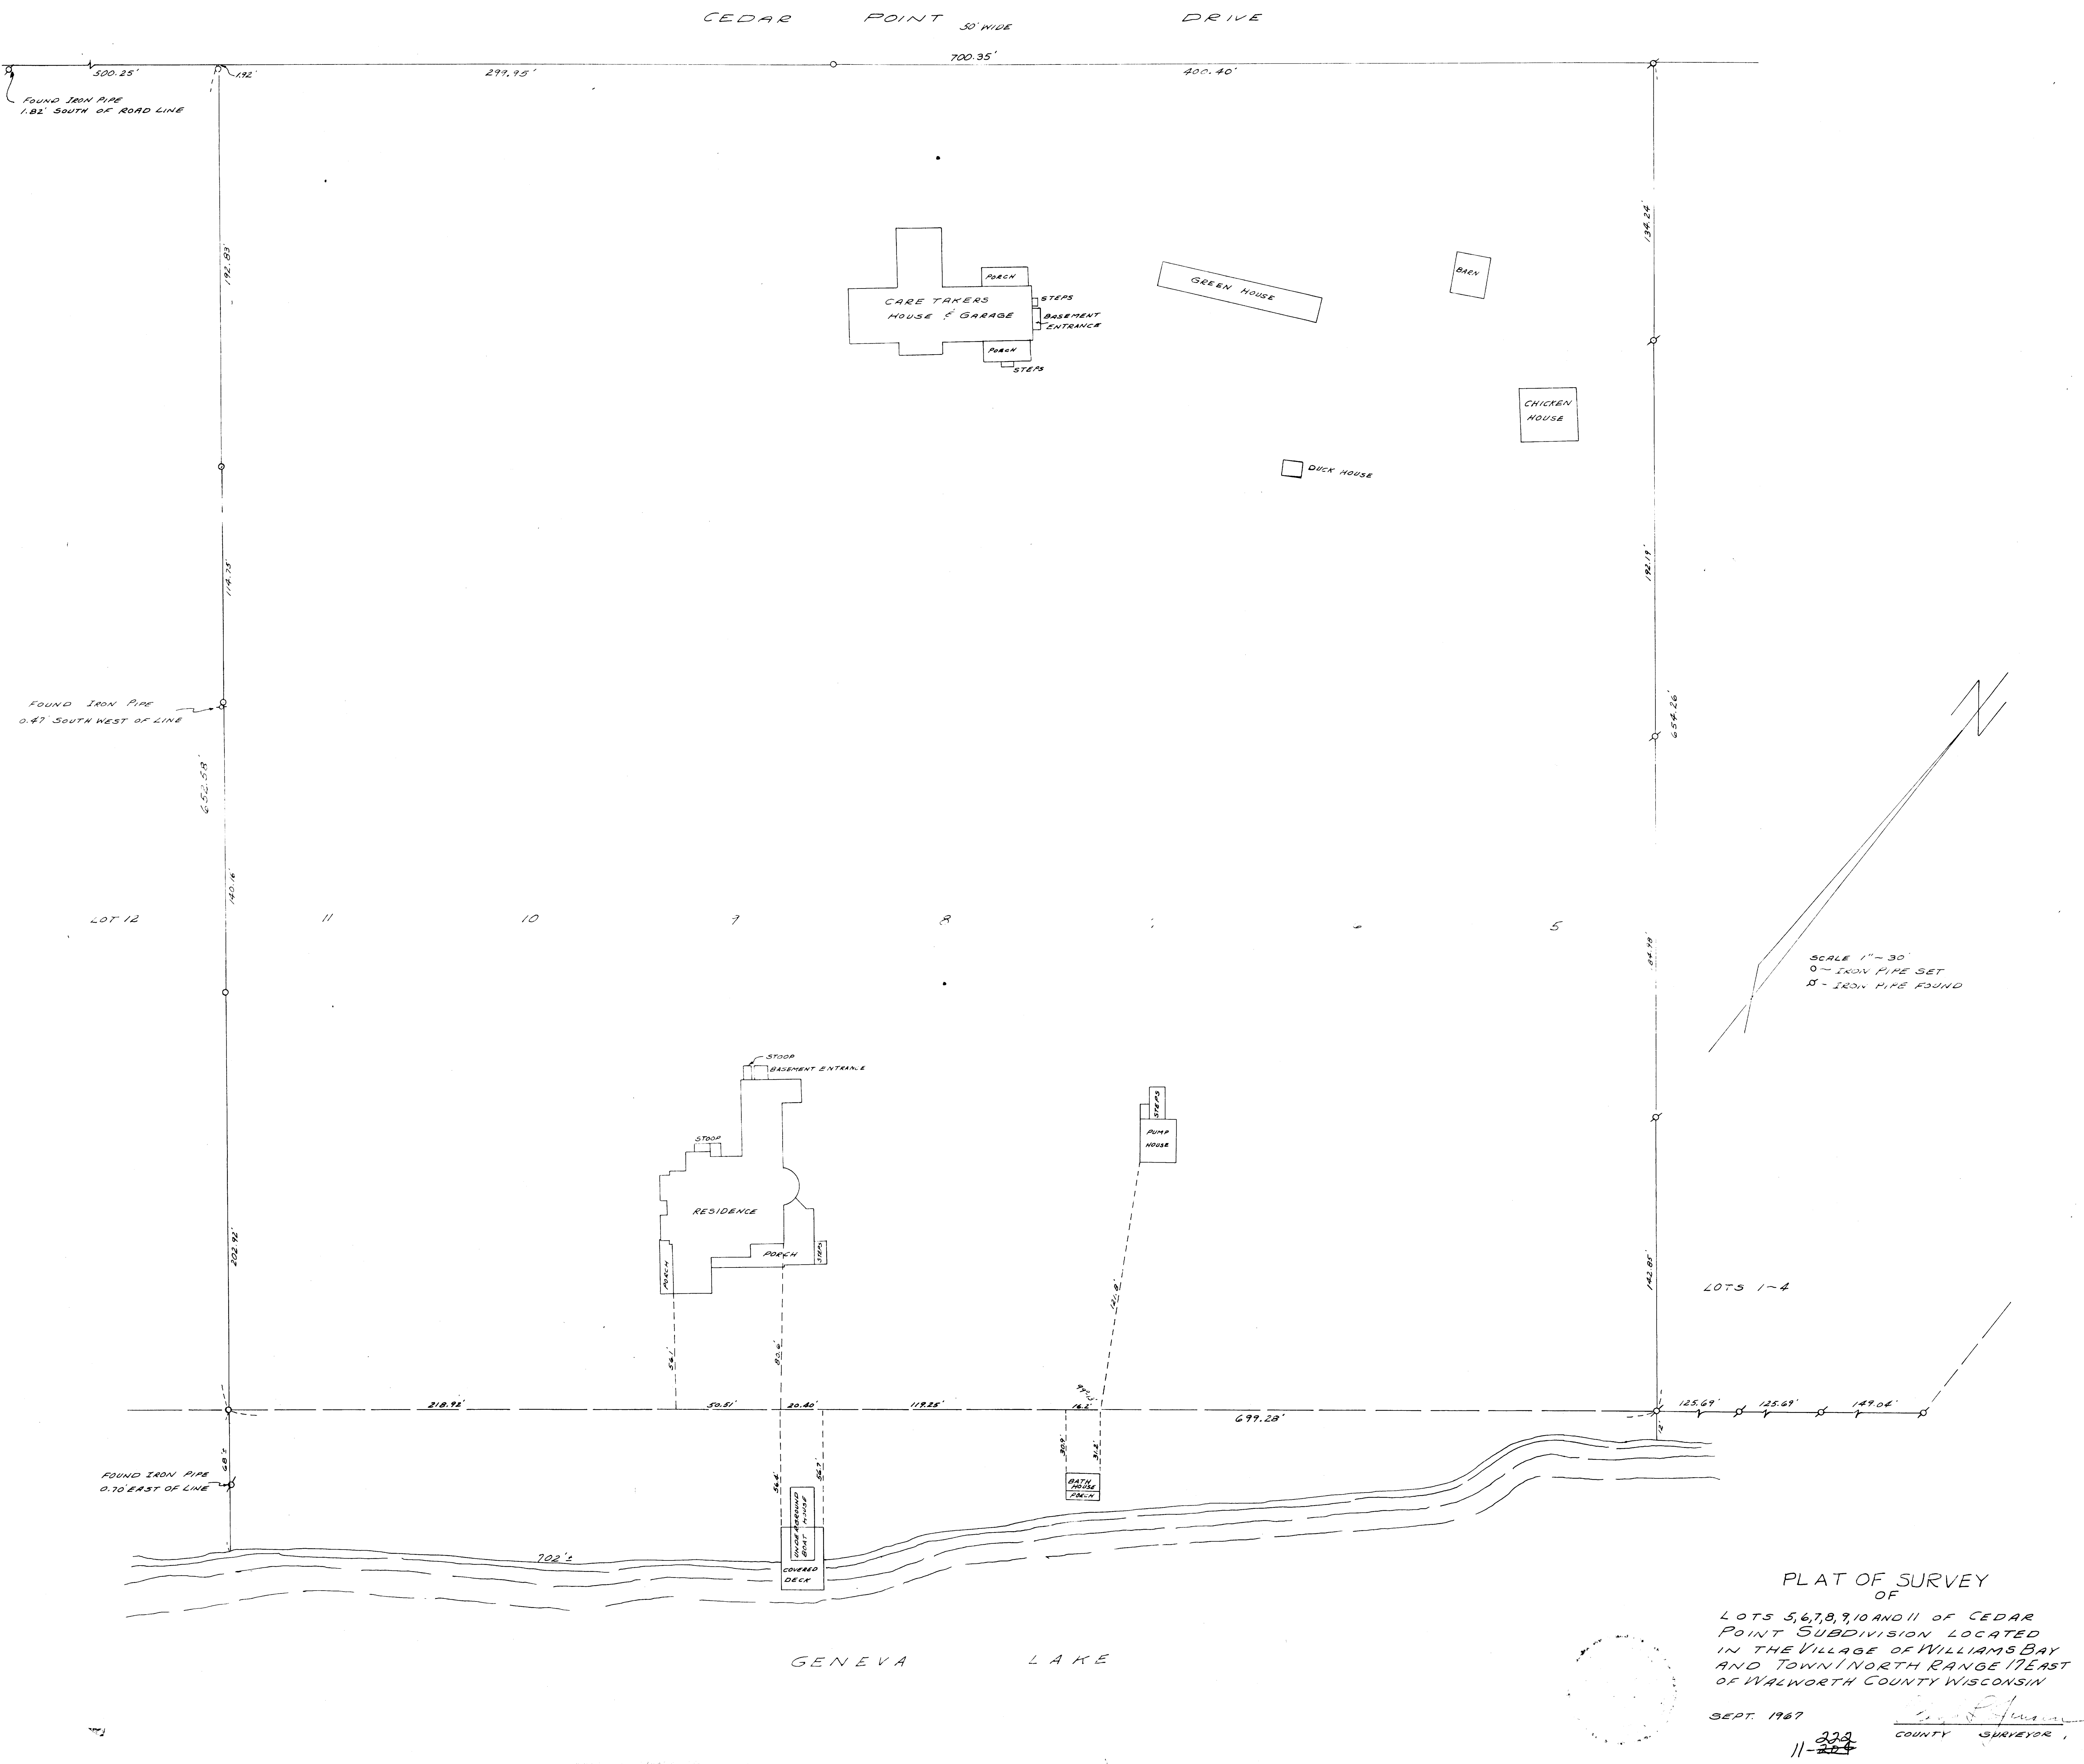

PLAT OF SURVEY  
OF  
LOTS 5, 6, 7, 8, 9, 10 AND 11 OF CEDAR  
POINT SUBDIVISION LOCATED  
IN THE VILLAGE OF WILLIAMS BAY  
AND TOWN OF NORTH RANGE 17 EAST  
OF WALWORTH COUNTY WISCONSIN  
SEPT. 1967  
229  
11-204  
COUNTY SURVEYOR